


U. S. PUBLIC LAND SURVEY MONUMENT RECORD

SECTION 31 T 15 N, R 6 W, TOWN OF SHELBY
LA CROSSE COUNTY

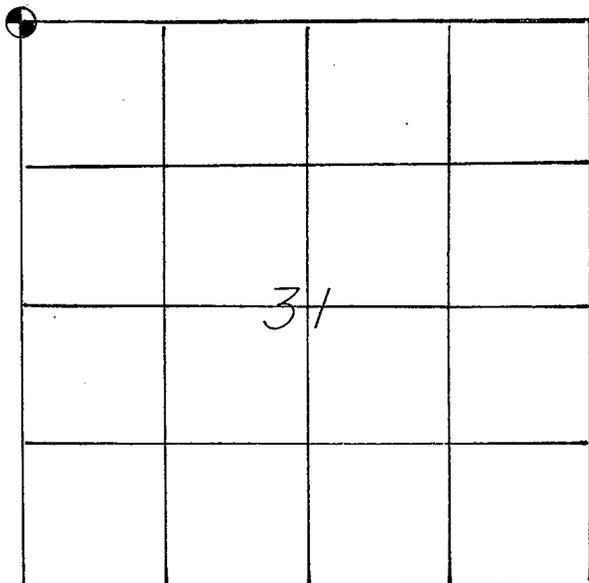

WISCONSIN COORDINATE SYSTEM
North
East
Theta Angle
Horiz. Order
Vert. Order
TYPE OF LANDMARK
1" iron pipe with Hofmeister cap
BEARINGS ARE REFERENCED TO
Assumed

CREW: LOCATION OF LANDMARK
BILL JUNG
PERRY DAHL

DATE: 7-24-86

Describe any record evidence, monument evidence, testimonial evidence or any other material evidence you considered and whether the monument was found or restored through acceptance of an obliterated evidence location.


I found an iron pipe at the occupied corner which I accepted as the best available evidence of the original government corner position. Hofmeister apparently used this as the section corner when he was surveying in Section 25 to the Northwest.

Describe or show any material discrepancy between the location of the restored corner and that of the corner previously restored or reestablished.

None known.

RECORD OF DURABLE WITNESS MONUMENTS


NO	DESCRIPTION	MAGNETIC	
		BEARING	DISTANCE
1	CENTER OF LARGE OAK STUMP	N76°E	31.6'±
2	NAIL IN DOUBLE-BLAZED 9" HICKORY	S73°E	25.15'
3	NAIL IN DOUBLE-BLAZED 5" HICKORY	SOUTH	29.05'
4	NAIL IN DOUBLE-BLAZED 11" HICKORY	S17°W	24.54'
5	NAIL IN DOUBLE-BLAZED 9" HICKORY	S72°W	22.12'

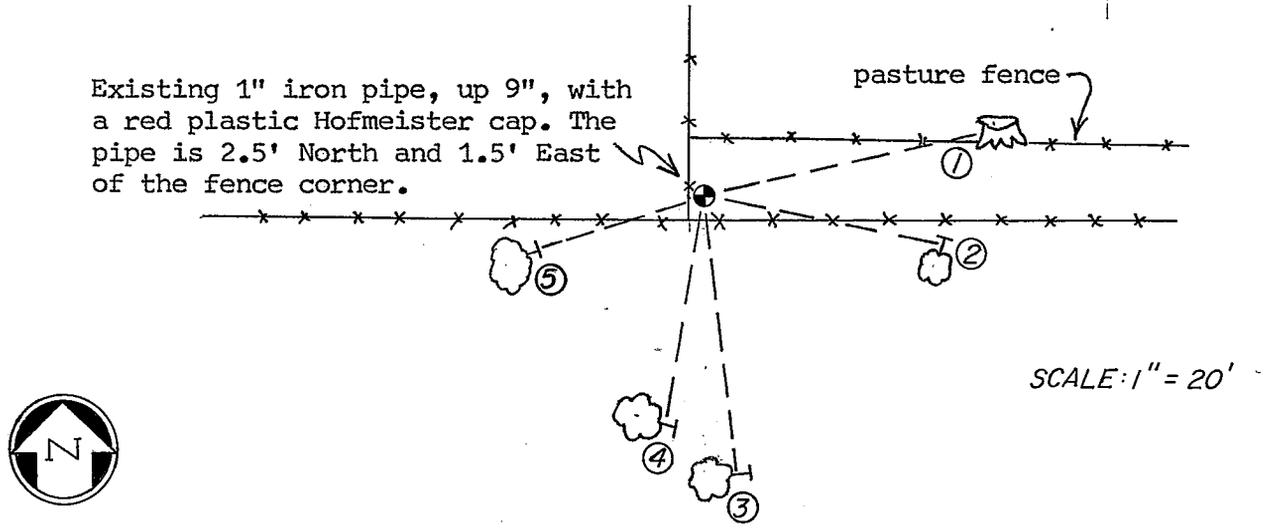

PLAN VIEW DRAWING OF REFERENCE TIES

MAP SHOWING DISTANCE AND DIRECTION TO OTHER PUBLIC LAND SURVEY CORNERS USED FOR REESTABLISHING THE CORNER

(not to scale)

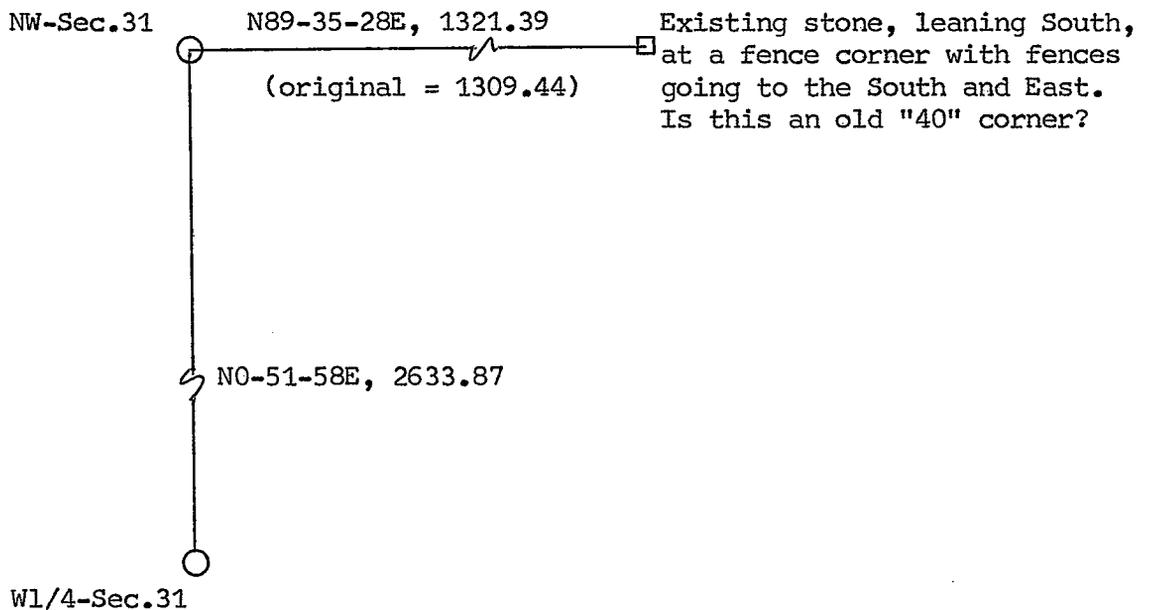

I, William C. Jung, Deputy County Surveyor,
 HEREBY CERTIFY THAT THE CORNER LOCATION SHOWN ON THIS RECORD
 WAS DETERMINED BY ME OR UNDER MY DIRECTION AND CONTROL AND
 THAT THIS U. S. PUBLIC LAND SURVEY MONUMENT RECORD IS CORRECT
 AND COMPLETE TO THE BEST OF MY KNOWLEDGE AND BELIEF.

William C. Jung
 Signature

March 6, 1987
 Date



Seal