


U. S. PUBLIC LAND SURVEY MONUMENT RECORD

SECTION 30 T 15 N, R 6 W, TOWN OF SHELBY  
 LA CROSSE COUNTY

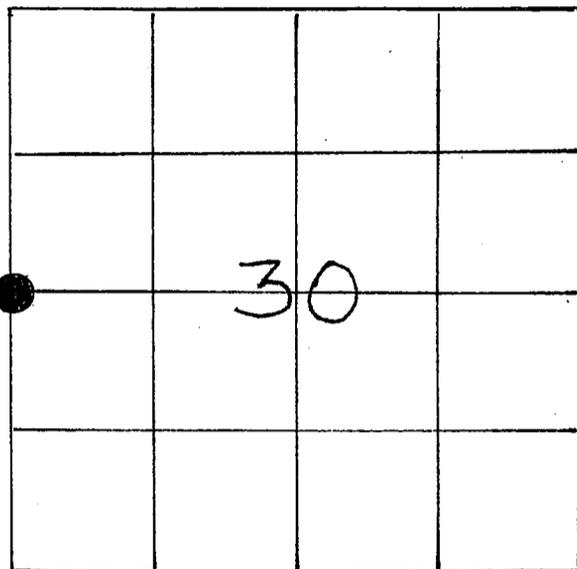

LOCATION OF LANDMARK

CREW: P. FAIRCHILD  
 R. JASPERSON

WISCONSIN COORDINATE SYSTEM
North
East
Theta Angle
Horiz. Order
Vert. Order
TYPE OF LANDMARK
1/4" I.P.
BEARINGS ARE REFERENCED TO

Describe any record evidence, monument evidence, testimonial evidence or any other material evidence you considered and whether the monument was found or restored through acceptance of an obliterated evidence location.


NO MONUMENT FOUND - CORNER WAS ESTABLISHED BY SINGLE-PROPORTIONATE MEASURE. INTERIOR CORNERS SET ON E-W 1/4 LINE OF SEC. 25-15-7 (ADJACENT SECTION TO WEST) WERE SET IN A VERY OLD DOWN FENCE LINE WHICH HELPED AFFIRM THIS LOCATION.

Describe or show any material discrepancy between the location of the restored corner and that of the corner previously restored or reestablished.


NO DISCREPANCY

RECORD OF DURABLE WITNESS MONUMENTS

NO	DESCRIPTION	BEARING	DISTANCE
1	24" HICKORY SINGLE BLAZE W/PK	N17°59'37"W	500.29'
2	12" CHERRY SINGLE BLAZE W/PK	S87°53'25"E	143.08'
3	24" MAPLE SINGLE BLAZE W/PK	S63°41'42"E	189.44'
4	SPIKE SET 1.5' NW OF NW CORNER OF SHED	S07°51'50"W	888.37'

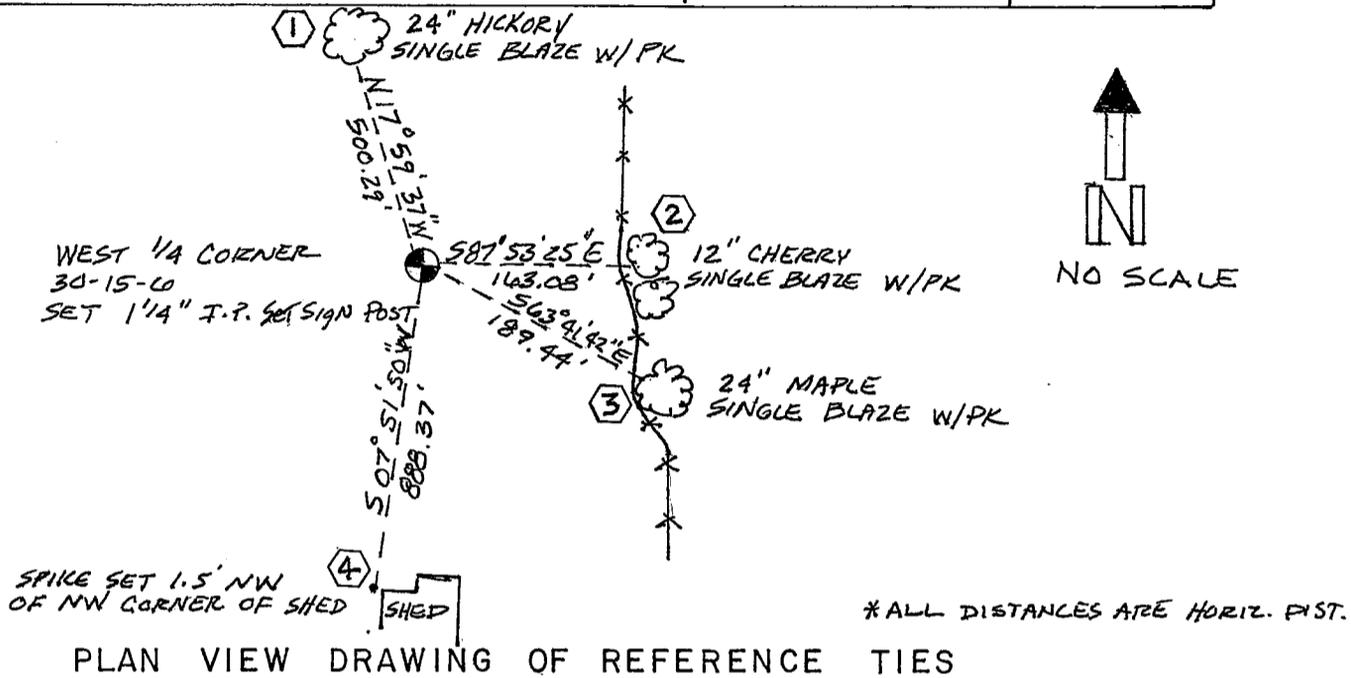

MAP SHOWING DISTANCE AND DIRECTION TO OTHER PUBLIC LAND SURVEY CORNERS USED FOR REESTABLISHING THE CORNER

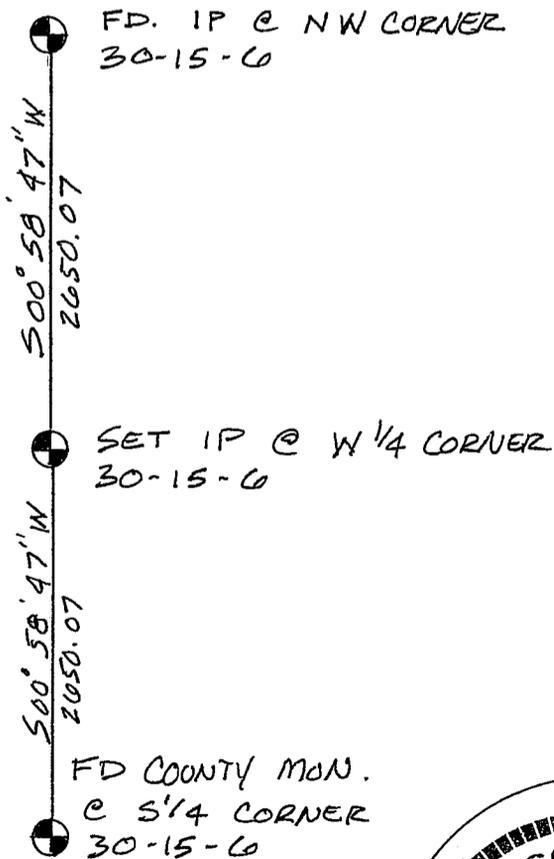

I, Paul E. Fairchild  
HEREBY CERTIFY THAT THE CORNER LOCATION SHOWN ON THIS RECORD  
WAS DETERMINED BY ME OR UNDER MY DIRECTION AND CONTROL AND  
THAT THIS U. S. PUBLIC LAND SURVEY MONUMENT RECORD IS CORRECT  
AND COMPLETE TO THE BEST OF MY KNOWLEDGE AND BELIEF.

Paul E. Fairchild Signature 5/17/94 Date



Seal