


U. S. PUBLIC LAND SURVEY MONUMENT RECORD

SECTION 31 T 15 N, R 6 W, TOWN OF SHELBY
LA CROSSE COUNTY

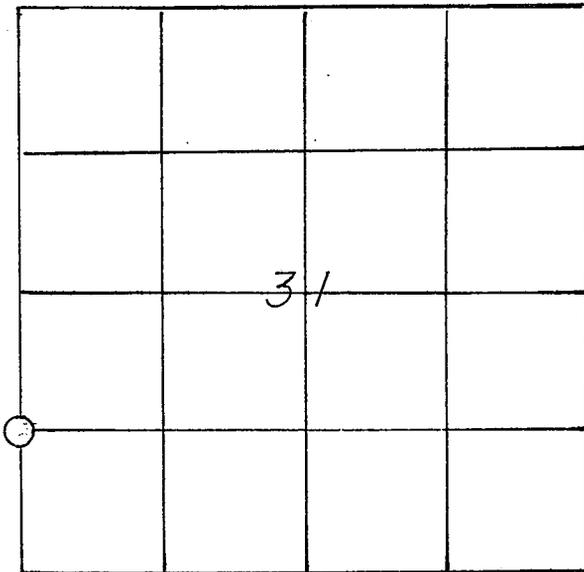

LOCATION OF LANDMARK

WISCONSIN COORDINATE SYSTEM

North

East

Theta Angle

Horiz. Order

Vert. Order

TYPE OF LANDMARK

BERNTSEN SET IN A PIPE

BEARINGS ARE REFERENCED TO

Assumed

CREW:

BILL JUNG

PERRY DAHL

DATE: 9-5-86

Describe any record evidence, monument evidence, testimonial evidence or any other material evidence you considered and whether the monument was found or restored through acceptance of an obliterated evidence location.


I set the corner "as per law", on line and equidistant between the SW and W1/4 corners.

Describe or show any material discrepancy between the location of the restored corner and that of the corner previously restored or reestablished.

The Northeast corner of the cemetery is supposed to be at the "40" corner and has been used as such in previous surveys and deeds, but I find it to be in error.

RECORD OF DURABLE WITNESS MONUMENTS
MAGNETIC


NO	DESCRIPTION	BEARING	DISTANCE
1	P.K. NAIL IN 9" DOUBLE-BLAZED ASPEN	N53°E	36.15'
2	P.K. NAIL IN 9" DOUBLE-BLAZED BIRCH	N47°W	10.42'
3	EXISTING IRON PIPE AT FENCE CORNER	S82°W	31.48'
4			

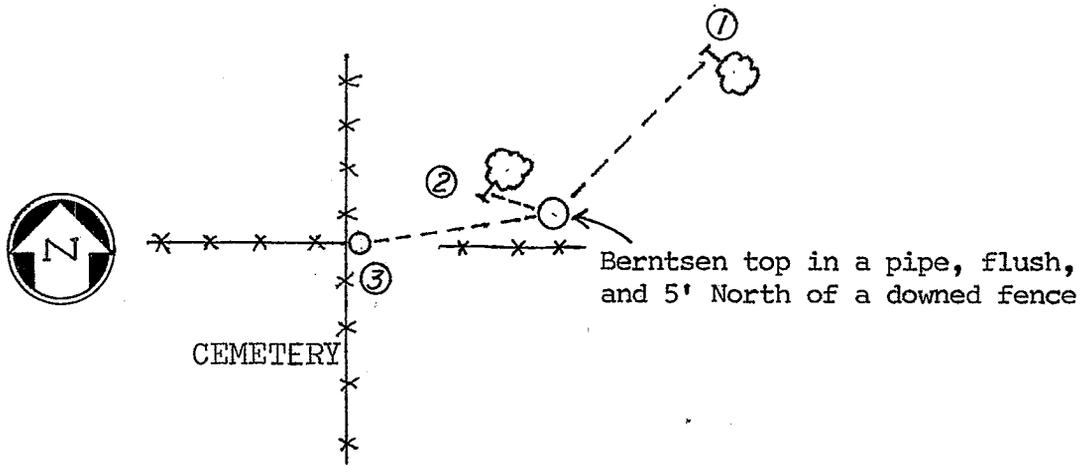

PLAN VIEW DRAWING OF REFERENCE TIES

MAP SHOWING DISTANCE AND DIRECTION TO OTHER PUBLIC LAND SURVEY CORNERS USED FOR REESTABLISHING THE CORNER

(not to scale)

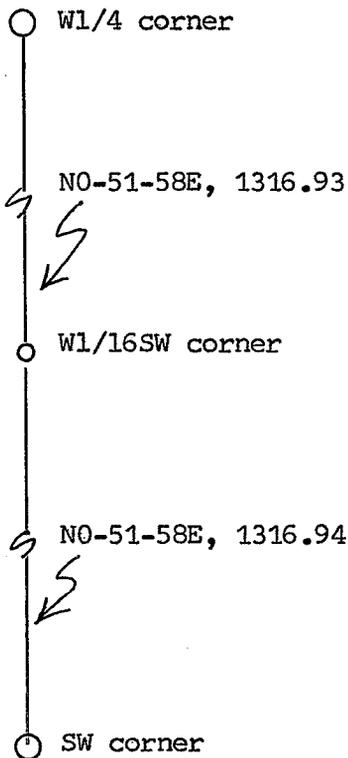

I, William C. Jung, Deputy County Surveyor,
HEREBY CERTIFY THAT THE CORNER LOCATION SHOWN ON THIS RECORD
WAS DETERMINED BY ME OR UNDER MY DIRECTION AND CONTROL AND
THAT THIS U. S. PUBLIC LAND SURVEY MONUMENT RECORD IS CORRECT
AND COMPLETE TO THE BEST OF MY KNOWLEDGE AND BELIEF.

William C. Jung
Signature

March 6, 1987
Date



Seal