


U. S. PUBLIC LAND SURVEY MONUMENT RECORD

SECTION 31 T 15 N, R 6 W, TOWN OF SHELBY

LA CROSSE COUNTY

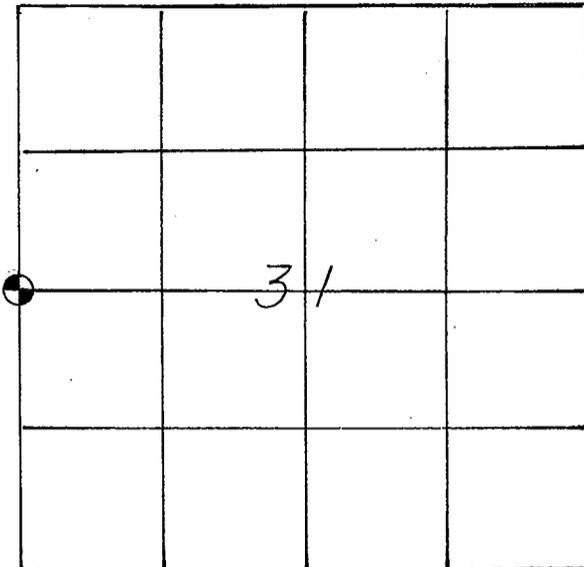

LOCATION OF LANDMARK

CREW: BILL JUNG
PERRY DAHL

DATE: 8-18-86

Describe any record evidence, monument evidence, testimonial evidence or any other material evidence you considered and whether the monument was found or restored through acceptance of an obliterated evidence location.

I set the corner by single proportionate measurement, on line and equidistant between the section corners. I set a brass capped Lunde marker.

Describe or show any material discrepancy between the location of the restored corner and that of the corner previously restored or reestablished.

None known. The corner falls about 90 feet East of the line fence.

WISCONSIN COORDINATE SYSTEM

North

East

Theta Angle

Horiz. Order

Vert. Order

TYPE OF LANDMARK

BRASS CAPPED MONUMENT


BEARINGS ARE REFERENCED TO

Assumed

RECORD OF DURABLE WITNESS MONUMENTS
MAGNETIC

NO	DESCRIPTION	BEARING	DISTANCE
1	P.K. NAIL IN DOUBLE-BLAZED 5" HICKORY	N75°E	22.09'
2	P.K. NAIL IN DOUBLE-BLAZED 15" OAK	S9°W	22.75'
3	P.K. NAIL IN DOUBLE-BLAZED 9" ELM TREE	S63°W	15.48'
4	1" IRON PIPE (survey point, random corner)	S86°W	21.66'


Set a brass capped Lunde marker in a mound of earth and rocks on a steep sidehill.

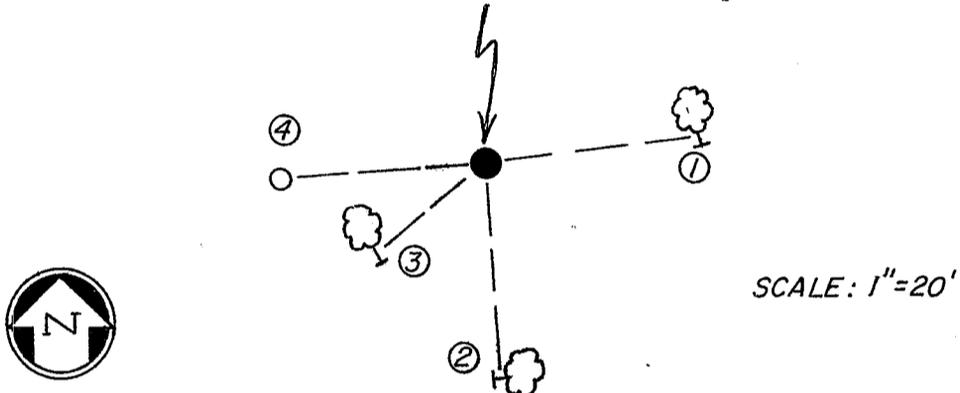

PLAN VIEW DRAWING OF REFERENCE TIES

MAP SHOWING DISTANCE AND DIRECTION TO OTHER PUBLIC LAND SURVEY CORNERS USED FOR REESTABLISHING THE CORNER


(not to scale)

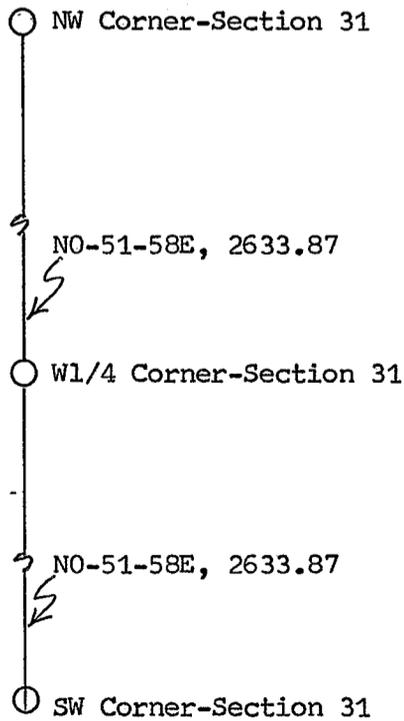

I, William C. Jung, Deputy County Surveyor,
HEREBY CERTIFY THAT THE CORNER LOCATION SHOWN ON THIS RECORD
WAS DETERMINED BY ME OR UNDER MY DIRECTION AND CONTROL AND
THAT THIS U. S. PUBLIC LAND SURVEY MONUMENT RECORD IS CORRECT
AND COMPLETE TO THE BEST OF MY KNOWLEDGE AND BELIEF.

William C. Jung
Signature

March 2, 1987
Date

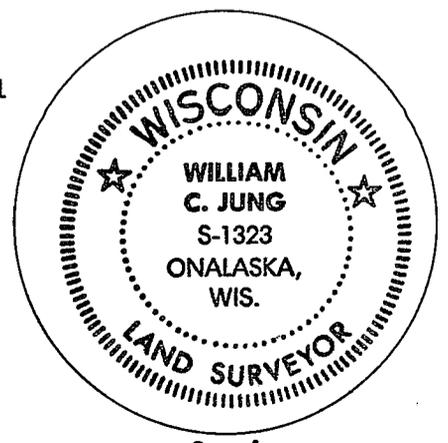

Seal