


21606310000

U. S. PUBLIC LAND SURVEY MONUMENT RECORD

SECTION 6 T 15 N, R 6 W, TOWN OF SHELBY

LA CROSSE COUNTY

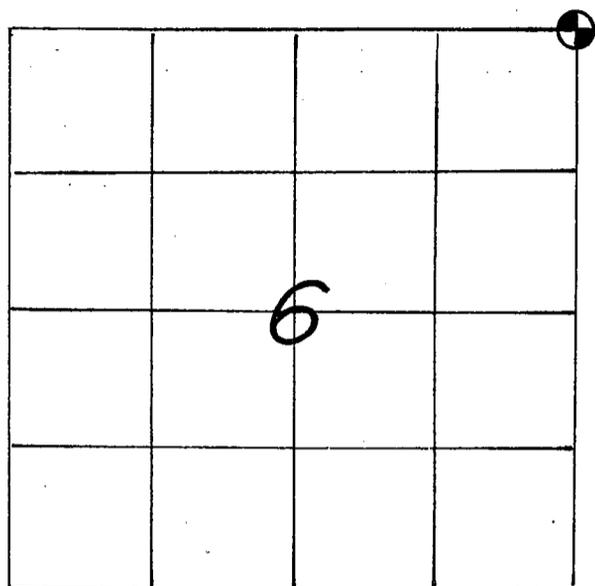

LOCATION OF LANDMARK

WISCONSIN COORDINATE SYSTEM

North

East

Theta Angle

Horiz. Order

Vert. Order

TYPE OF LANDMARK

Existing 6" square Stone. (broken)

BEARINGS ARE REFERENCED TO

Crew: WILLIAM C. JUNG
 PETER F. FOLLANSBEE
 Date: 1/04/1996

Describe any record evidence, monument evidence, testimonial evidence or any other material evidence you considered and whether the monument was found or restored through acceptance of an obliterated evidence location.

I found a broken stone at the corner and accepted it as the best available evidence of the original government corner position. I set a timber nail in the center of the bottom portion of the stone which appeared to be in good condition. The top part of the stone was broken into fragments. I placed many of the fragments around the stone. When we were here, the snow was deep and the ground frozen.

Describe or show any material discrepancy between the location of the restored corner and that of the corner previously restored or reestablished.

None Known.

RECORD OF DURABLE WITNESS MONUMENTS


NO	DESCRIPTION	MAGNETIC	
		BEARING	DISTANCE
1	Set P.K. Nail in SE-side 23" White Oak	N 57° E	Sl.= 80.32'
2	Set P.K. Nail in SE-side 15" Oak	N 71° E	15.70 Ft.
3	Set P.K. Nail in NE-side 17" Oak	S 25° E	13.72 Ft.
4	Set P.K. Nail in W.-side 17" Oak	S 06° E	10.46 Ft.

(Note: the four Bearing Trees are double blazed.)

NE-Cor., Sec. 6-15-6.

Found a broken Stone down in a shallow hole. Set a nail in the center of the part that remained together and placed the fragments around it. The Stone is about 4.8' * southwesterly of the Oak at the fence intersection.

* to center

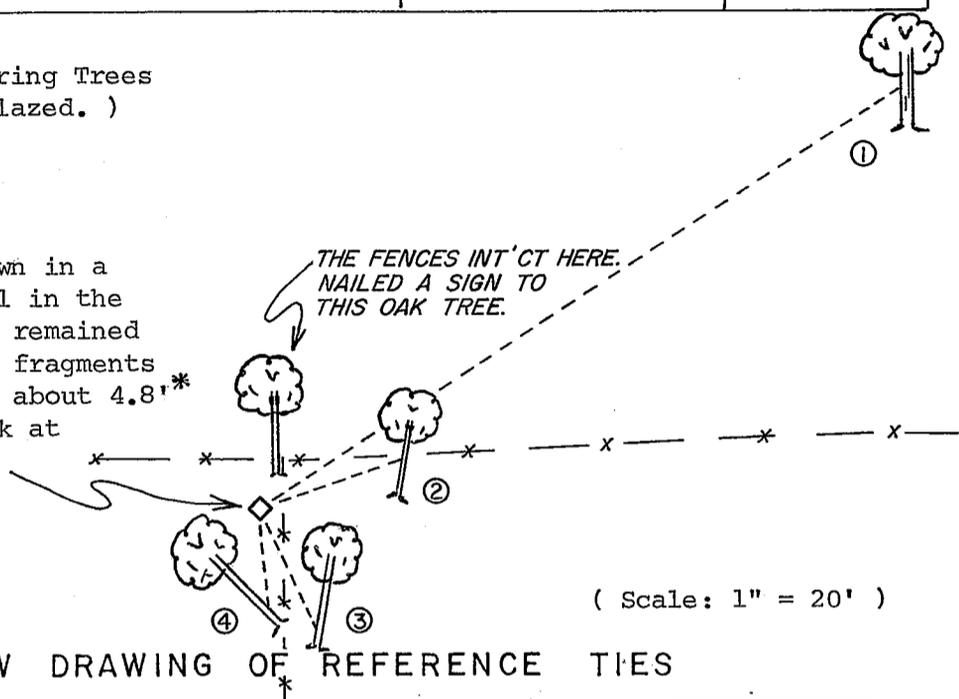

(Scale: 1" = 20')

PLAN VIEW DRAWING OF REFERENCE TIES

MAP SHOWING DISTANCE AND DIRECTION TO OTHER PUBLIC LAND SURVEY CORNERS USED FOR REESTABLISHING THE CORNER

No section measurements were made by me at this time.

I, William C. Jung, County Surveyor
 HEREBY CERTIFY THAT THE CORNER LOCATION SHOWN ON THIS RECORD
 WAS DETERMINED BY ME OR UNDER MY DIRECTION AND CONTROL AND
 THAT THIS U. S. PUBLIC LAND SURVEY MONUMENT RECORD IS CORRECT
 AND COMPLETE TO THE BEST OF MY KNOWLEDGE AND BELIEF.


William C. Jung 1/5/96
 Signature Date



Seal

U. S. PUBLIC LAND SURVEY MONUMENT RECORD

SECTION 31 T 16 N, R 6 W, TOWN OF BARRE
 LA CROSSE COUNTY

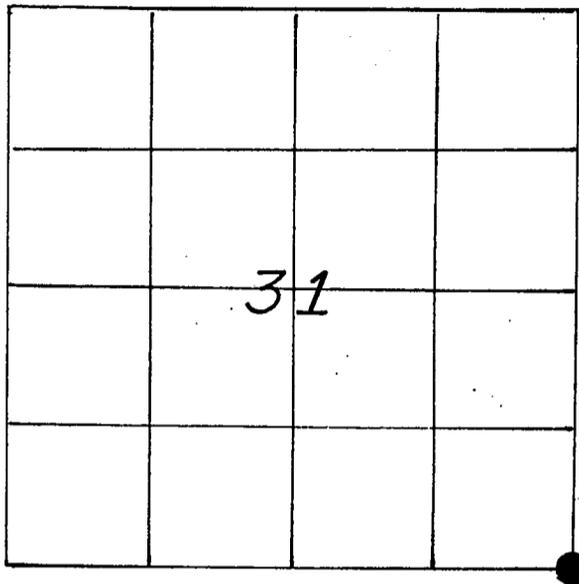

LOCATION OF LANDMARK

CREW: Rodney Maxwell, Dwayne Hefner

DATE: 14 May, 1995

Describe any record evidence, monument evidence, testimonial evidence or any other material evidence you considered and whether the monument was found or restored through acceptance of an obliterated evidence location.

I found a 6" X 8" Sandstone although the top was busted up, the stone was very similar to the others located around this section. The stone also fit very well with the occupied fence corner. Also found large hole in ground that measured perfect for location of bearing tree. This location also fits well with other corners in Section 31. Accepted stone as best available evidence of the original government corner location.


Describe or show any material discrepancy between the location of the restored corner and that of the corner previously restored or reestablished.

None known.

WISCONSIN COORDINATE SYSTEM
North
East
Theta Angle
Horiz. Order
Vert. Order
TYPE OF LANDMARK
6" X 8" SANDSTONE (Top busted up)
BEARINGS ARE REFERENCED TO the North line of the S.E. $\frac{1}{4}$ of Section 31 ASSUMED to bear East.


RECORD OF DURABLE WITNESS MONUMENTS

NO	DESCRIPTION	BEARING	DISTANCE
1	Tree hole from Gov't Tie	N10° W	10.5'
2	15" Oak (fence corner)	N20° E	4'
3	22" W. Oak	S7° E	10.5'
4	15" Crooked Oak	N78° 30' W	19.4'

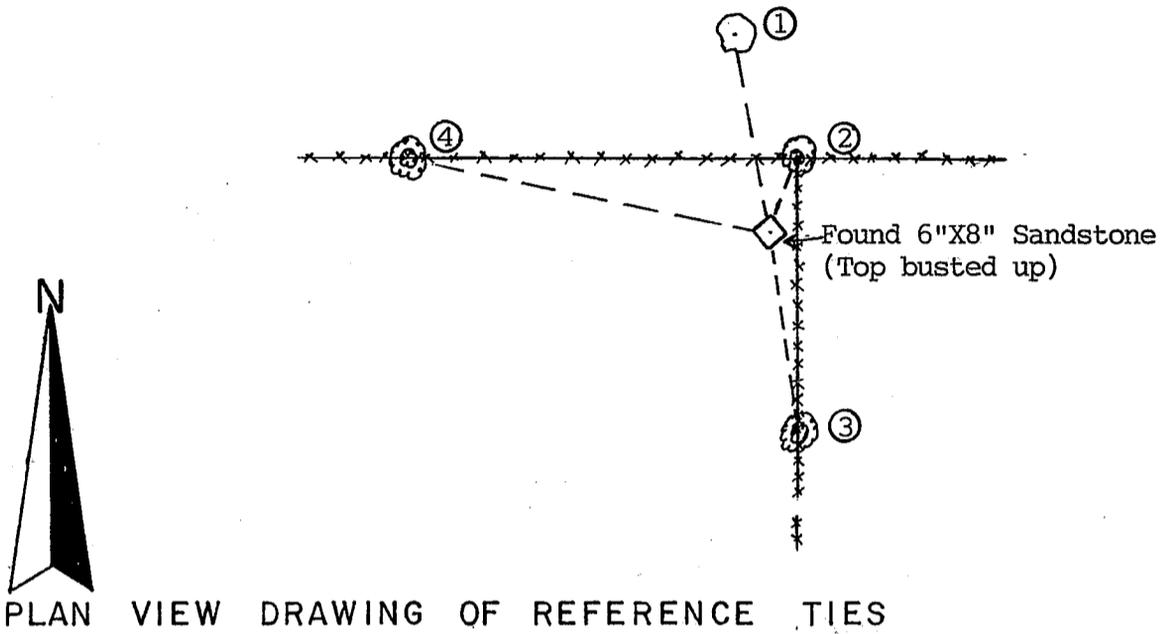

PLAN VIEW DRAWING OF REFERENCE TIES


MAP SHOWING DISTANCE AND DIRECTION TO OTHER PUBLIC LAND SURVEY CORNERS USED FOR REESTABLISHING THE CORNER

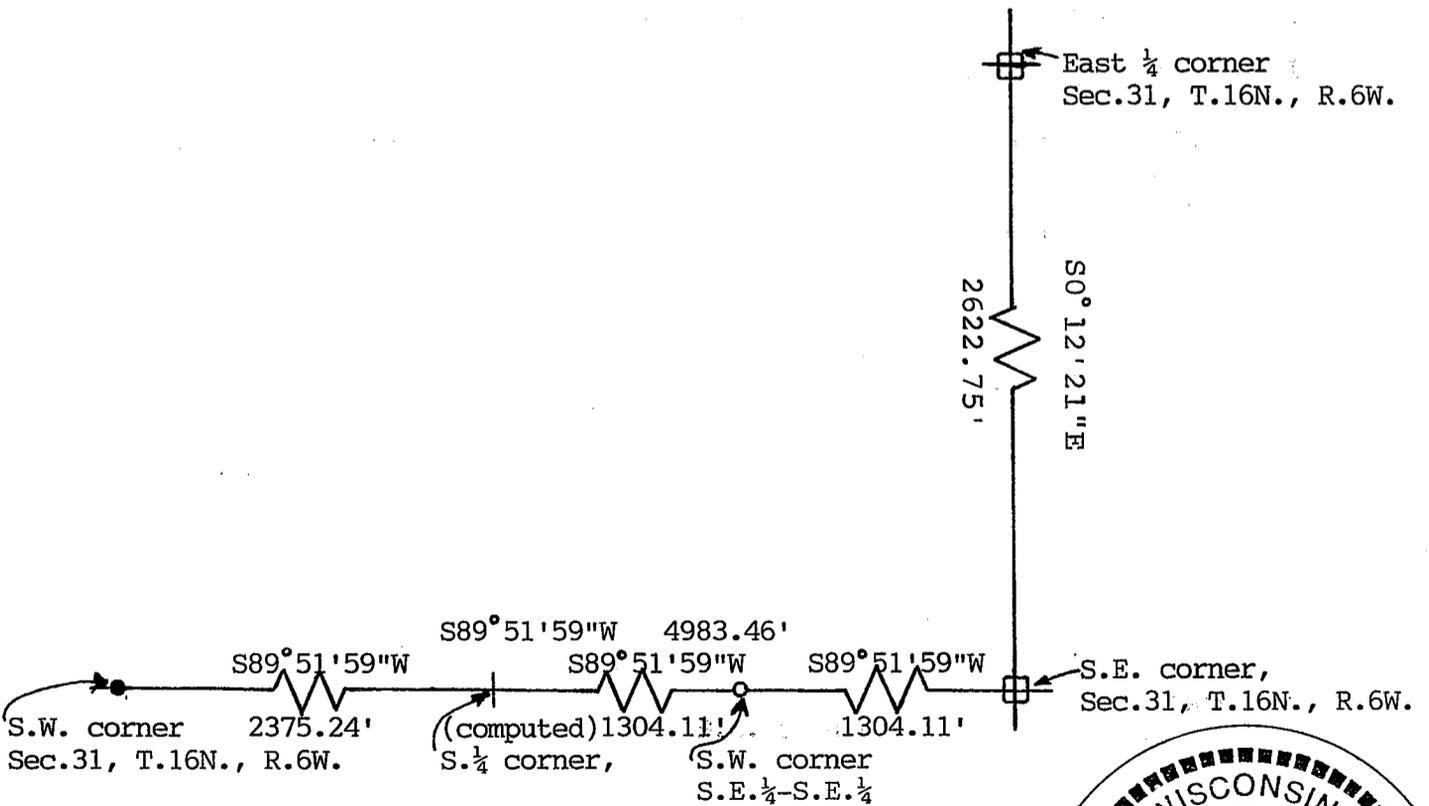

I, Rodney H. Maxwell, Registered Land Surveyor,
 HEREBY CERTIFY THAT THE CORNER LOCATION SHOWN ON THIS RECORD
 WAS DETERMINED BY ME OR UNDER MY DIRECTION AND CONTROL AND
 THAT THIS U. S. PUBLIC LAND SURVEY MONUMENT RECORD IS CORRECT
 AND COMPLETE TO THE BEST OF MY KNOWLEDGE AND BELIEF.

Rodney H. Maxwell
 Signature

Jan. 18, 1996
 Date

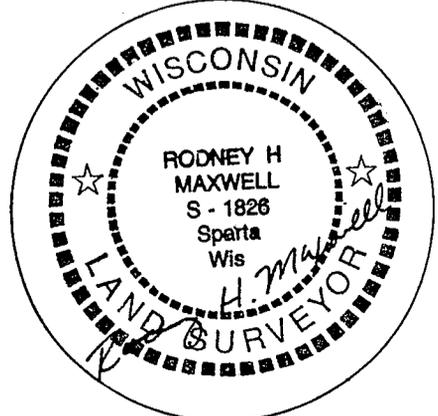

Seal