


LA CROSSE COUNTY, WISCONSIN US PUBLIC LAND SURVEY MONUMENT RECORD NORTH ¼ CORNER, SECTION 6, T15N, R6W, TOWN OF SHELBY




WISCONSIN COORDINATE SYSTEM
 NORTH: 662,573.086
 EAST: 1,667,462.593
 TYPE OF MONUMENT: No monument set at corner location
 BEARINGS REFERENCED TO: Grid
 CREW: Bryan Meyer and Pete Follansbee
 DATE: November 5, 2009
 WEATHER: Sunny, 40°±

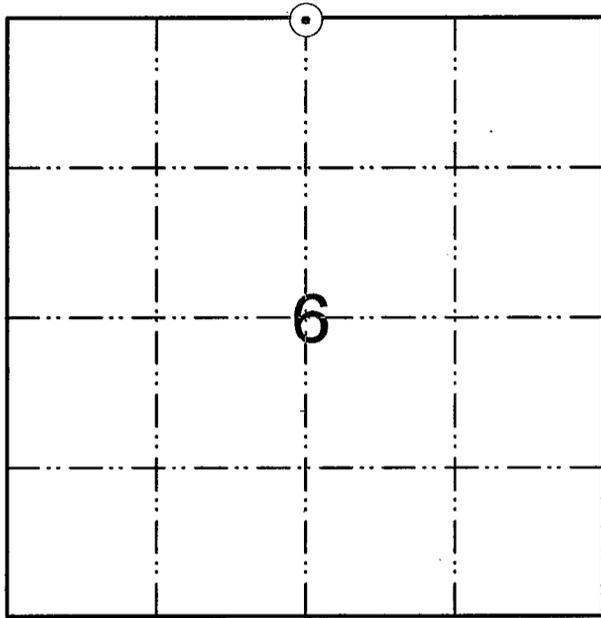

⊙ = LOCATION OF LANDMARK

PLAN VIEW OF REFERENCE TIES:

Looking East-Northeast. Instrument is set up over the Westerly witness bar.

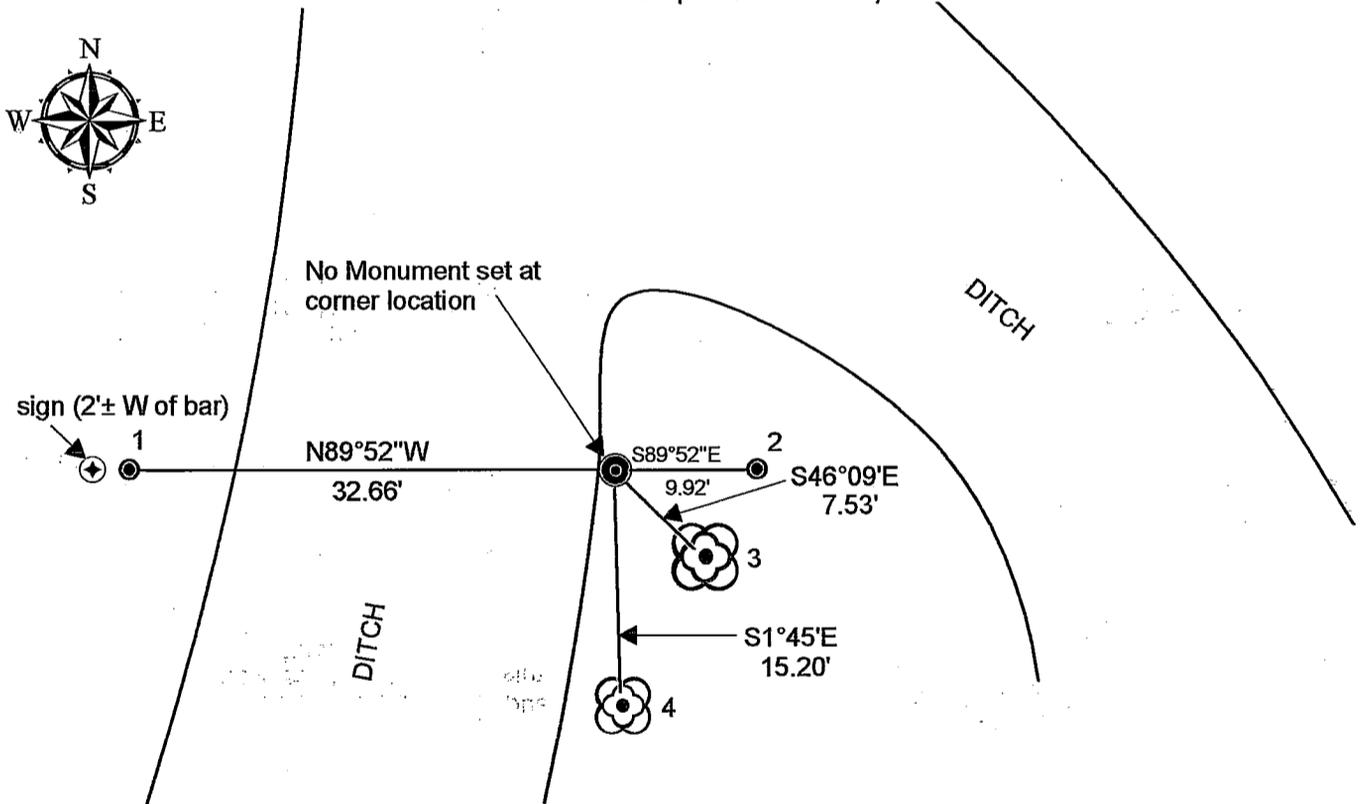


WITNESS TIES:

- 1 = Set 3/4"x30" round iron bar with aluminum cap
- 2 = Set 3/4"x30" round iron bar with aluminum cap
- 3 = Set nail and washer in W side of 30" White Oak
- 4 = Set nail and washer in E side of 17" Black Oak

NO SCALE

GRID BEARINGS AND DISTANCES

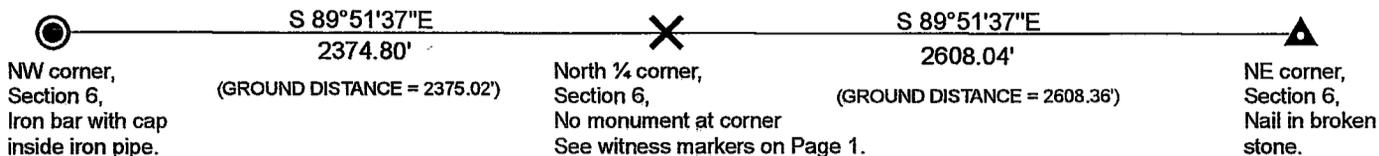

DESCRIBE ANY RECORD EVIDENCE, MONUMENT EVIDENCE, TESTIMONIAL EVIDENCE OR ANY OTHER MATERIAL EVIDENCE YOU CONSIDERED AND WHETHER THE MONUMENT WAS FOUND OR RESTORED THROUGH ACCEPTANCE OF AN OBLITERATED EVIDENCE LOCATION:

Set this corner on line and at proportionate distance between the Northeast and Northwest corners of Section 6.

DESCRIBE OR SHOW ANY MATERIAL DISCREPANCY BETWEEN THE LOCATION OF THE RESTORED CORNER AND THAT OF THE CORNER PREVIOUSLY RESTORED OR REESTABLISHED

None.

CERTIFICATE:

I, Bryan H. Meyer, County Surveyor, hereby certify that the corner location shown on this record was determined by me or under my direction and control and that this U. S. Public Land Survey Monument Record is correct and complete to the best of my knowledge and belief.

Bryan H. Meyer
Bryan H. Meyer, County Surveyor

2/19/2010
Date

