


21606320000

## U. S. PUBLIC LAND SURVEY MONUMENT RECORD

SECTION 5 T 15 N, R 6 W, TOWN OF GREENFIELD  
 LA CROSSE COUNTY

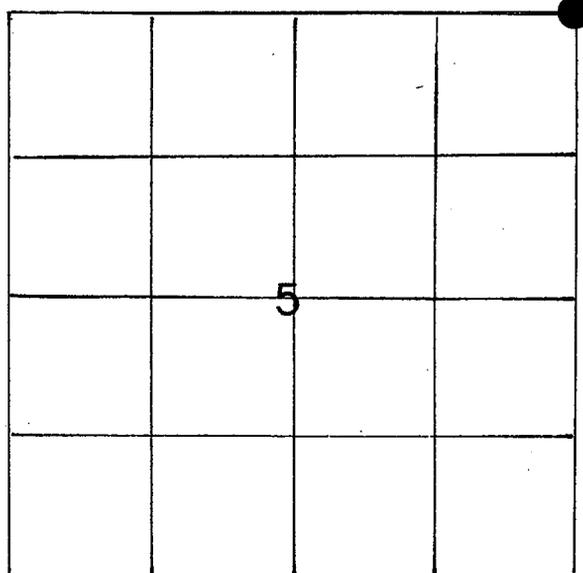

LOCATION OF LANDMARK

Crew: Bill Jung  
 Gary Watts  
 Perry Dahl  
 11/20/85

Crew: William C. Jung  
 Peter F. Follansbee  
 11/18/91 5/21/07

Describe any record evidence, monument evidence, testimonial evidence or any other material evidence you considered and whether the monument was found or restored through acceptance of an obliterated evidence location.

Gary Watts computed a location for this corner after surveying out part of Section 5. We set the section corner at his computed location. We probed and looked for a stone up and down the fence but did not find any evidence of the old corner. The old East-West fence appeared to be good evidence of that direction. There was also another old fence which was down running next to the fence that was up. This corner lines up with the road centerline to the North and the road centerline to the West. It was cold and windy when we set this corner with snow on the ground.


Describe or show any material discrepancy between the location of the restored corner and that of the corner previously restored or reestablished.

None known.

WISCONSIN COORDINATE SYSTEM	
North	662,521.063
East	1,675,327.173
Theta Angle	
Horiz. Order	
Vert. Order	
DATUM:	1983('91)
TYPE OF LANDMARK	
Berntsen Monument	
BEARINGS ARE REFERENCED TO	

RECORD OF DURABLE WITNESS MONUMENTS

NO	DESCRIPTION	BEARING	DISTANCE
1	set an iron pipe	West±	35.20
2	set an iron pipe	East±	42.02
3	to the center of a 3" sapling *****	Southeast	2.21
4			

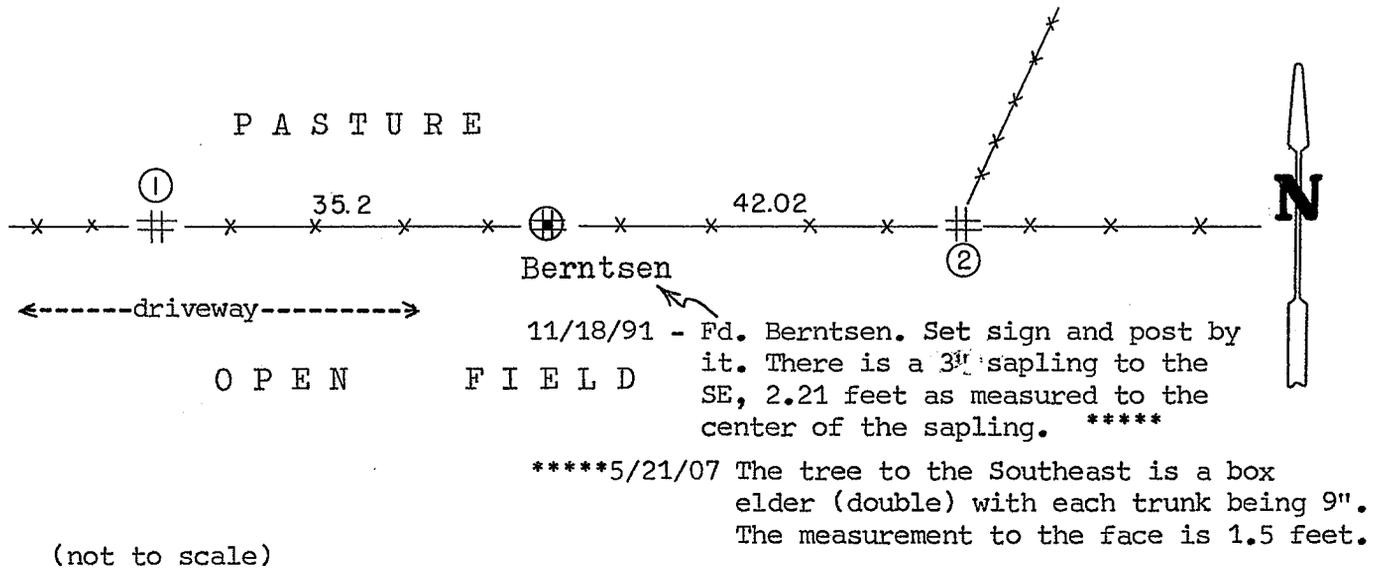

PLAN VIEW DRAWING OF REFERENCE TIES



MAP SHOWING DISTANCE AND DIRECTION TO OTHER PUBLIC LAND SURVEY CORNERS USED FOR REESTABLISHING THE CORNER


~~None measured by me~~

Section measurements made by Watts and later by Steve Solberg.

Surveys of record show section measurements to this corner. The SPC's that we assigned to this corner and the E1/4 of Section 5 after running GPS missions confirmed Watts' distance between these two corners.

I, William C. Jung, Deputy County Surveyor,  
 HEREBY CERTIFY THAT THE CORNER LOCATION SHOWN ON THIS RECORD  
 WAS DETERMINED BY ME OR UNDER MY DIRECTION AND CONTROL AND  
 THAT THIS U. S. PUBLIC LAND SURVEY MONUMENT RECORD IS CORRECT  
 AND COMPLETE TO THE BEST OF MY KNOWLEDGE AND BELIEF.

William C. Jung December 6, 1985  
 Signature Date

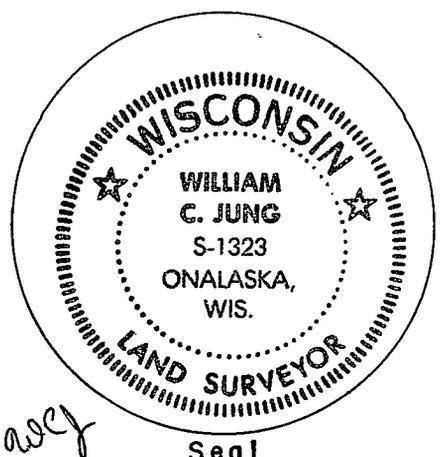

Revised: June 2, 1992  
 Revised: July 12, 2007

Seal