


21606320020

U. S. PUBLIC LAND SURVEY MONUMENT RECORD

SECTION 5 T 15 N, R 6 W, TOWN OF GREENFIELD

LA CROSSE COUNTY

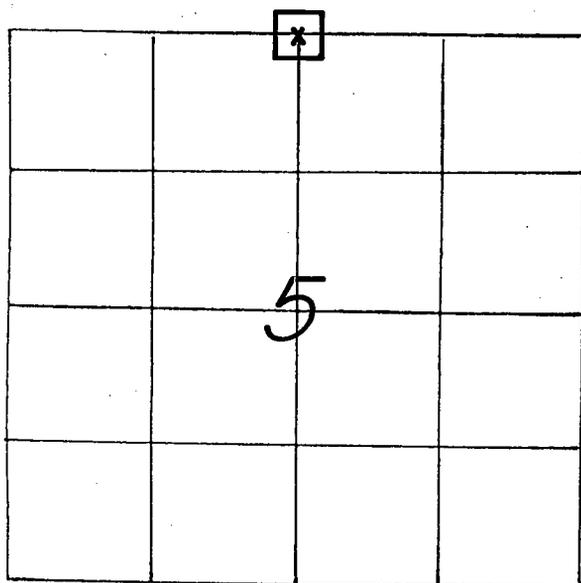

LOCATION OF LANDMARK

CREW: WILLIAM C. JUNG
 PETER F. FOLLANSBEE
 DATE: 9/24/2007

WISCONSIN COORDINATE SYSTEM

North

East

Theta Angle

Horiz. Order

Vert. Order

TYPE OF LANDMARK

6" x 6" STONE MONUMENT.

BEARINGS ARE REFERENCED TO

Describe any record evidence, monument evidence, testimonial evidence or any other material evidence you considered and whether the monument was found or restored through acceptance of an obliterated evidence location.


We found the stone of record and made new ties. Also, we found the old original burr oak bearing tree to the Northwest still in, dead, but still partially there. The top was off, but a goodly portion of the trunk was still standing.

Describe or show any material discrepancy between the location of the restored corner and that of the corner previously restored or reestablished.

NONE KNOWN.

RECORD OF DURABLE WITNESS MONUMENTS

NO	DESCRIPTION	MAGNETIC	
		BEARING	DISTANCE
1	SET A P.K. NAIL IN S.W.-SIDE OF A 12" HICKORY	N 50° W	1.64 FT.
2	SET A NAIL IN S.E.-SIDE OF AN 11" HICKORY	N 47° E	34.15 FT.
3	SET A NAIL IN N.E.-SIDE OF A 27" OAK	S 52° E	23.71 FT.
4	SET A NAIL IN N.W.-SIDE OF A 5-1/2" OAK	S 68° W	37.81 FT.

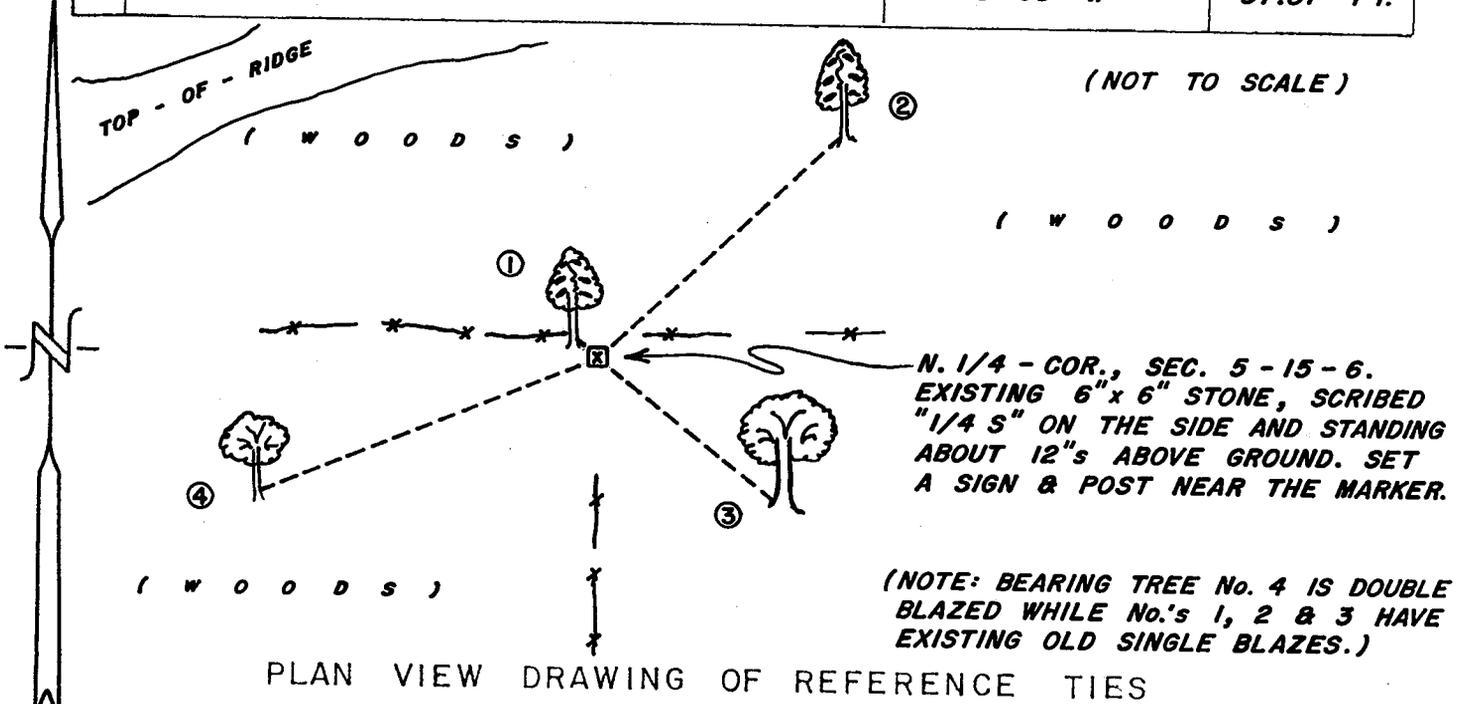

MAP SHOWING DISTANCE AND DIRECTION TO OTHER PUBLIC LAND SURVEY CORNERS USED FOR REESTABLISHING THE CORNER

No further section measurements were made by me at this time as several measurements of record have confirmed the position of this corner.

I, WILLIAM C. JUNG, COUNTY SURVEYOR
HEREBY CERTIFY THAT THE CORNER LOCATION SHOWN ON THIS RECORD
WAS DETERMINED BY ME OR UNDER MY DIRECTION AND CONTROL AND
THAT THIS U. S. PUBLIC LAND SURVEY MONUMENT RECORD IS CORRECT
AND COMPLETE TO THE BEST OF MY KNOWLEDGE AND BELIEF.


William C. Jung 9/27/07
Signature Date



Seal

U. S. PUBLIC LAND SURVEY MONUMENT RECORD

SECTION 5 T 15 N, R 6 W, TOWN OF GREENFIELD
LA CROSSE COUNTY

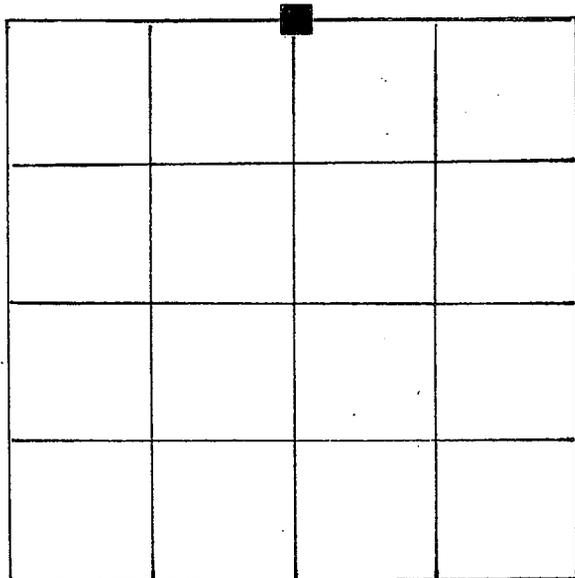

LOCATION OF LANDMARK

WISCONSIN COORDINATE SYSTEM
North
East
Theta Angle
Horiz. Order
Vert. Order
TYPE OF LANDMARK
STONE FOUND
BEARINGS ARE REFERENCED TO


Describe any record evidence, monument evidence, testimonial evidence or any other material evidence you considered and whether the monument was found or restored through acceptance of an obliterated evidence location.

STONE FOUND AT FENCE INTERSECTION

Describe or show any material discrepancy between the location of the restored corner and that of the corner previously restored or reestablished.

RECORD OF DURABLE WITNESS MONUMENTS

NO	DESCRIPTION	BEARING	DISTANCE
1	PK NAIL SET 6" SHAG BARK HICKORY	N43° E	33.96'
2	PK NAIL SET 8" SHAG BARK HICKORY	EAST	2.78'
3	PK NAIL SET 12" BUR. OAK	S75° W	24.10'
4	PK NAIL SET 6" SHAG BARK HICKORY	WEST	1.42'
5	PK NAIL SET 20" BUR. OAK	S51° E	24.15'

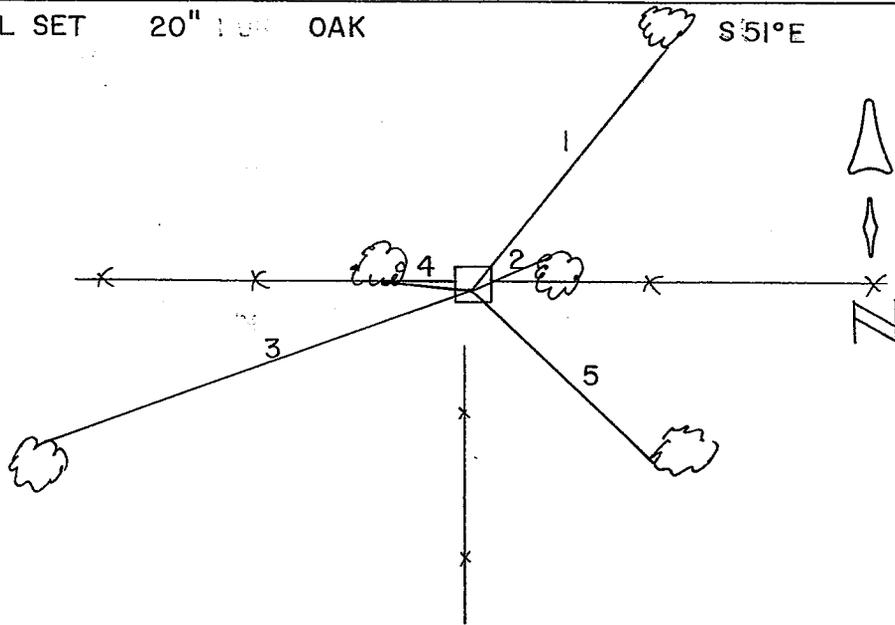

PLAN VIEW DRAWING OF REFERENCE TIES

MAP SHOWING DISTANCE AND DIRECTION TO OTHER PUBLIC LAND SURVEY CORNERS USED FOR REESTABLISHING THE CORNER

I, GARY A. WATTS
 HEREBY CERTIFY THAT THE CORNER LOCATION SHOWN ON THIS RECORD
 WAS DETERMINED BY ME OR UNDER MY DIRECTION AND CONTROL AND
 THAT THIS U. S. PUBLIC LAND SURVEY MONUMENT RECORD IS CORRECT
 AND COMPLETE TO THE BEST OF MY KNOWLEDGE AND BELIEF.

Gary A. Watts
 Signature

Nov. 18, 1985
 Date



Seal