


21606330000

U. S. PUBLIC LAND SURVEY MONUMENT RECORD

SECTION 3 T 15 N, R 6 W, TOWN OF GREENFIELD

LA CROSSE COUNTY

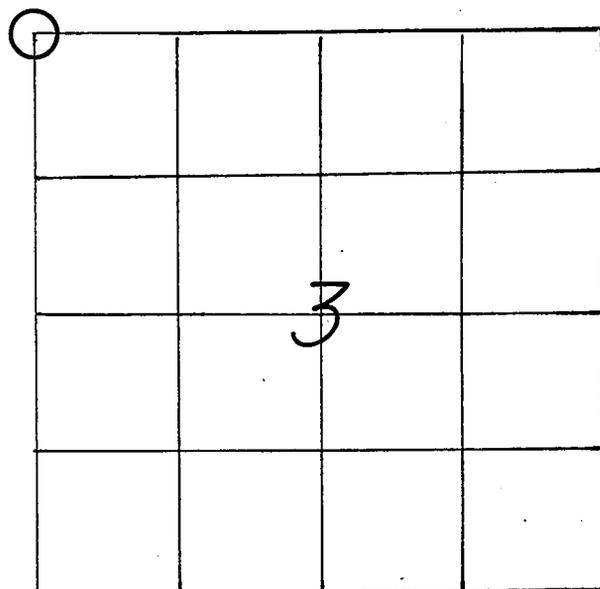

LOCATION OF LANDMARK

CREW: WILLIAM C. JUNG

PETER F. FOLLANSBEE

DATE: 5/06/2002

WISCONSIN COORDINATE SYSTEM

North 662,477.154

East 1,680,581.794

Theta Angle

Horiz. Order

Vert. Order

DATUM: 1983('91)

TYPE OF LANDMARK
2" IRON PIPE (I.D.).BEARINGS ARE REFERENCED TO
GRID NORTH AS PER SECTION DATA.

Describe any record evidence, monument evidence, testimonial evidence or any other material evidence you considered and whether the monument was found or restored through acceptance of an obliterated evidence location.

Rob Lampman set an iron pipe at the corner in 1984. I found the pipe disturbed by time and the elements. I reset Lampman's pipe and took new ties.


Rodney Loging said that when his father was a boy the "1867" stone fell from its location down into a washout to the East. It is now under several feet of fill. This was the story as his father told him.

Describe or show any material discrepancy between the location of the restored corner and that of the corner previously restored or reestablished.


NONE KNOWN.

RECORD OF DURABLE WITNESS MONUMENTS
MAGNETIC

NO	DESCRIPTION	BEARING	DISTANCE
1	SET A NAIL IN S.-SIDE OF A 6-1/2" HICKORY	N 70° W	13.55 FT.
2	SET A NAIL IN N.E.-SIDE OF A 5" BOX ELDER	N 51° W	29.13 FT.
3	SET A NAIL IN W.-SIDE OF A 9-1/2" BIRCH	N 13° W	28.73 FT.
4	SET A NAIL IN S.E.-SIDE OF A 7" ELM	N 23° E	29.08 FT.

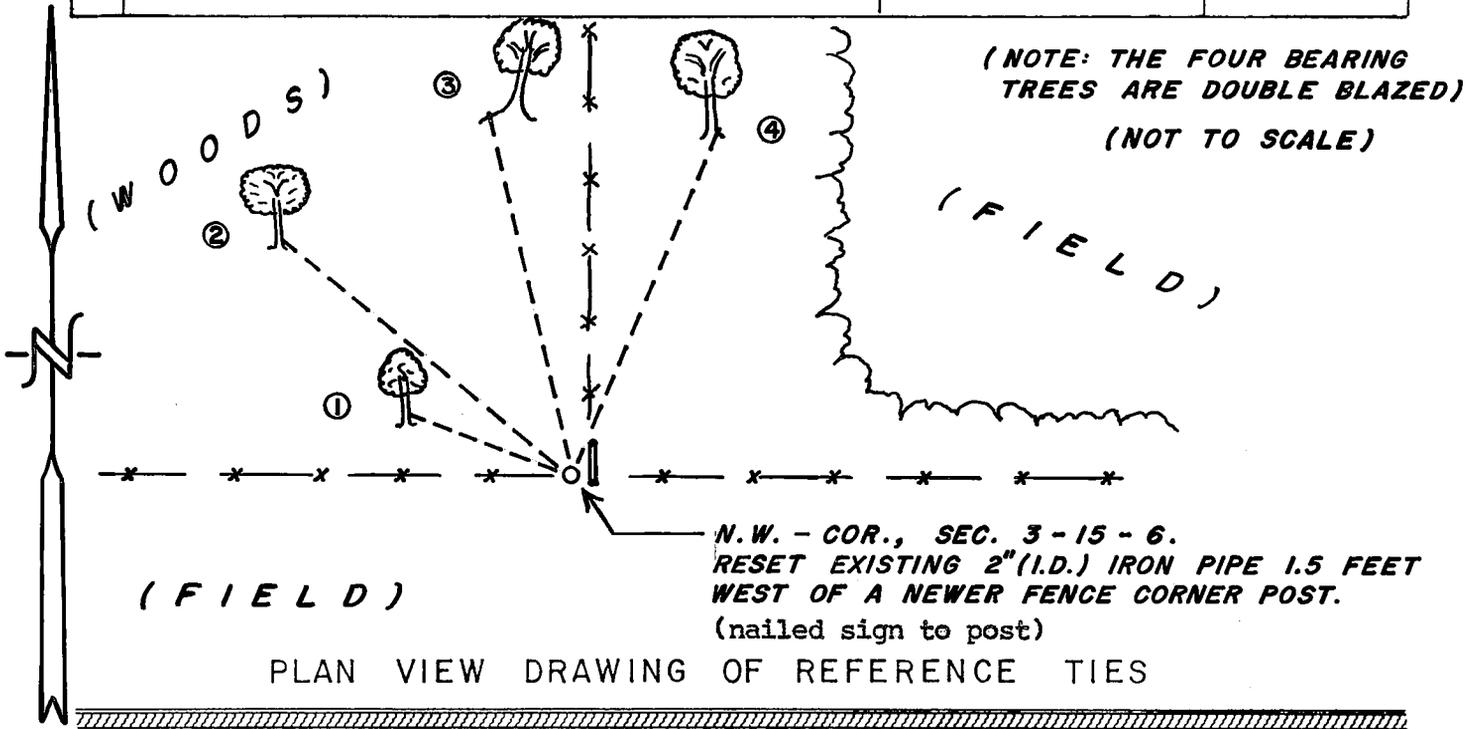

MAP SHOWING DISTANCE AND DIRECTION TO OTHER PUBLIC LAND SURVEY CORNERS USED FOR REESTABLISHING THE CORNER

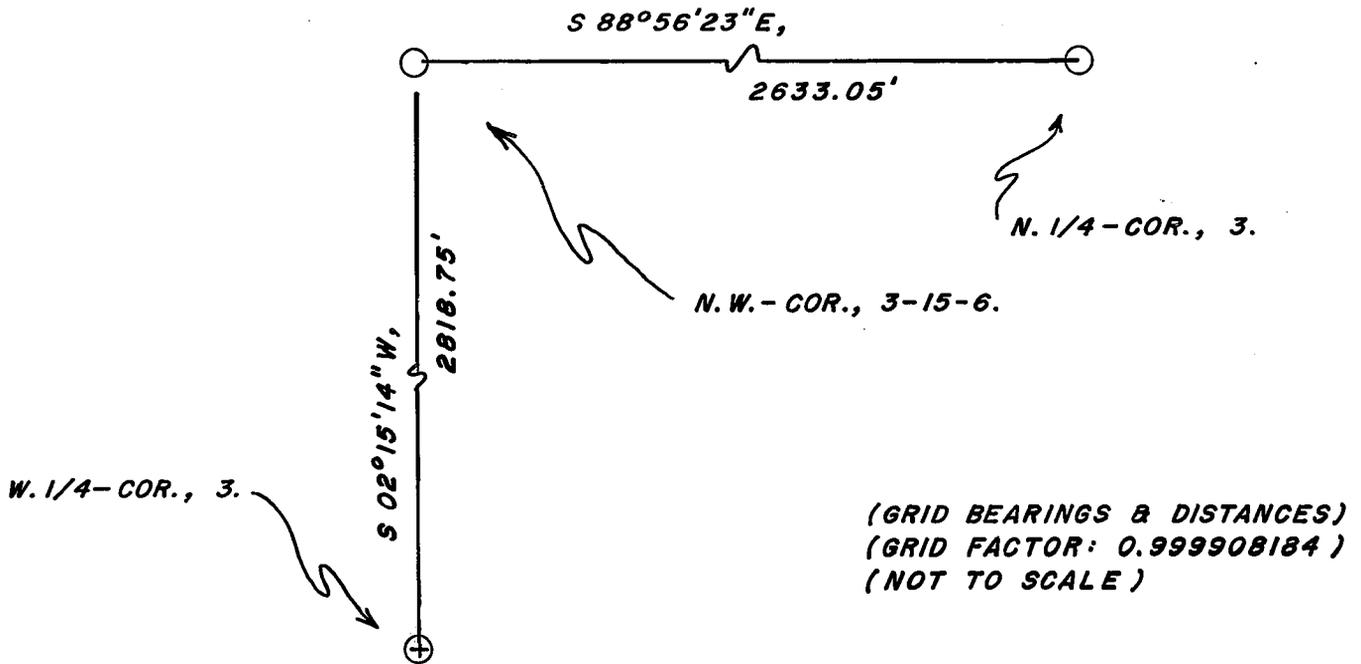

I, WILLIAM C. JUNG, COUNTY SURVEYOR
HEREBY CERTIFY THAT THE CORNER LOCATION SHOWN ON THIS RECORD WAS DETERMINED BY ME OR UNDER MY DIRECTION AND CONTROL AND THAT THIS U. S. PUBLIC LAND SURVEY MONUMENT RECORD IS CORRECT AND COMPLETE TO THE BEST OF MY KNOWLEDGE AND BELIEF.

William C. Jung
Signature

May 28, 2002
Date



Seal