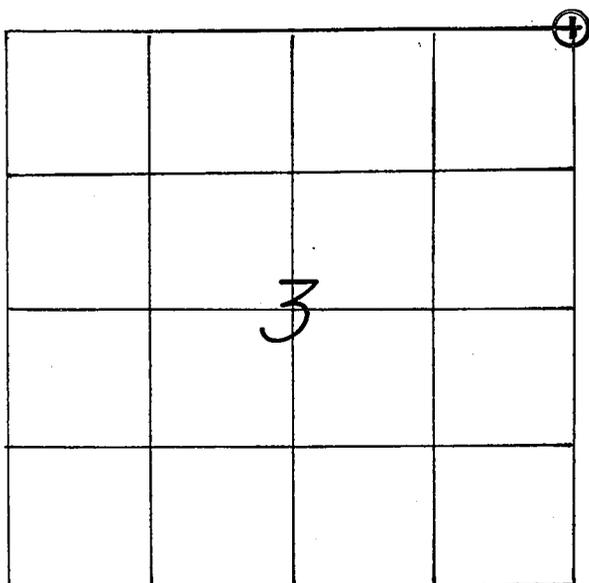


21606340000

U. S. PUBLIC LAND SURVEY MONUMENT RECORD

SECTION 3 T 15 N, R 6 W, TOWN OF GREENFIELD
LA CROSSE COUNTY

LOCATION OF LANDMARK

CREW: WILLIAM C. JUNG
PETER F. FOLLANSBEE
DATE: 6/07/2002

WISCONSIN COORDINATE SYSTEM	
North	662,377.546
East	1,685,843.870
Theta Angle	
Horiz. Order	
Vert. Order	
DATUM:	1983('91)
TYPE OF LANDMARK	
3/4" x 30" IRON BAR WITH ALUMINUM CAP.	
BEARINGS ARE REFERENCED TO	
GRID NORTH AS PER SECTION DATA.	

Describe any record evidence, monument evidence, testimonial evidence or any other material evidence you considered and whether the monument was found or restored through acceptance of an obliterated evidence location.


Steve Solberg set a rebar at this corner in 1991. I accepted his location, removed the rebar, and replaced it with an iron bar with cap. I searched at length for a stone but found nothing. The bar falls 2 foot North of a eight strand fence.

Describe or show any material discrepancy between the location of the restored corner and that of the corner previously restored or reestablished.


NONE KNOWN.

RECORD OF DURABLE WITNESS MONUMENTS

NO	DESCRIPTION	BEARING	DISTANCE
1	SET A P.K. NAIL IN S.E.-SIDE OF A 3-1/2" HICKORY	N.'EASTERLY ±	18.72 FT.
2	SET A RED PLASTIC CAP ON AN EXIST. IRON BAR	S 89°58'59"E(GRID)	71.40 FT.
3	EXIST. SPIKE IN THE FACE OF A 24" ± OAK	S 89° E (MAG.)	9.63 FT.
4	SET A REBAR IN THE WOODS AS A G.P.S. POINT	S 09°21'33"W(GRID)	81.34 FT.

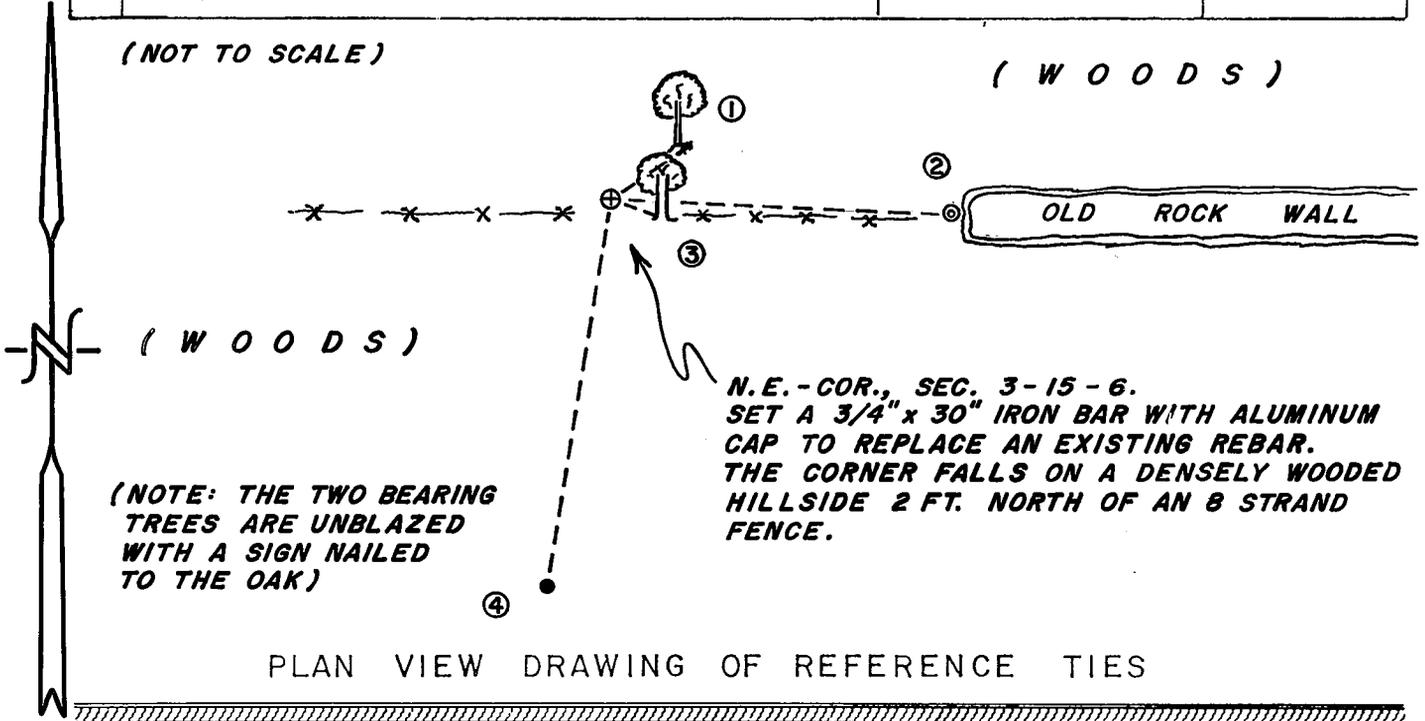

MAP SHOWING DISTANCE AND DIRECTION TO OTHER PUBLIC LAND SURVEY CORNERS USED FOR REESTABLISHING THE CORNER

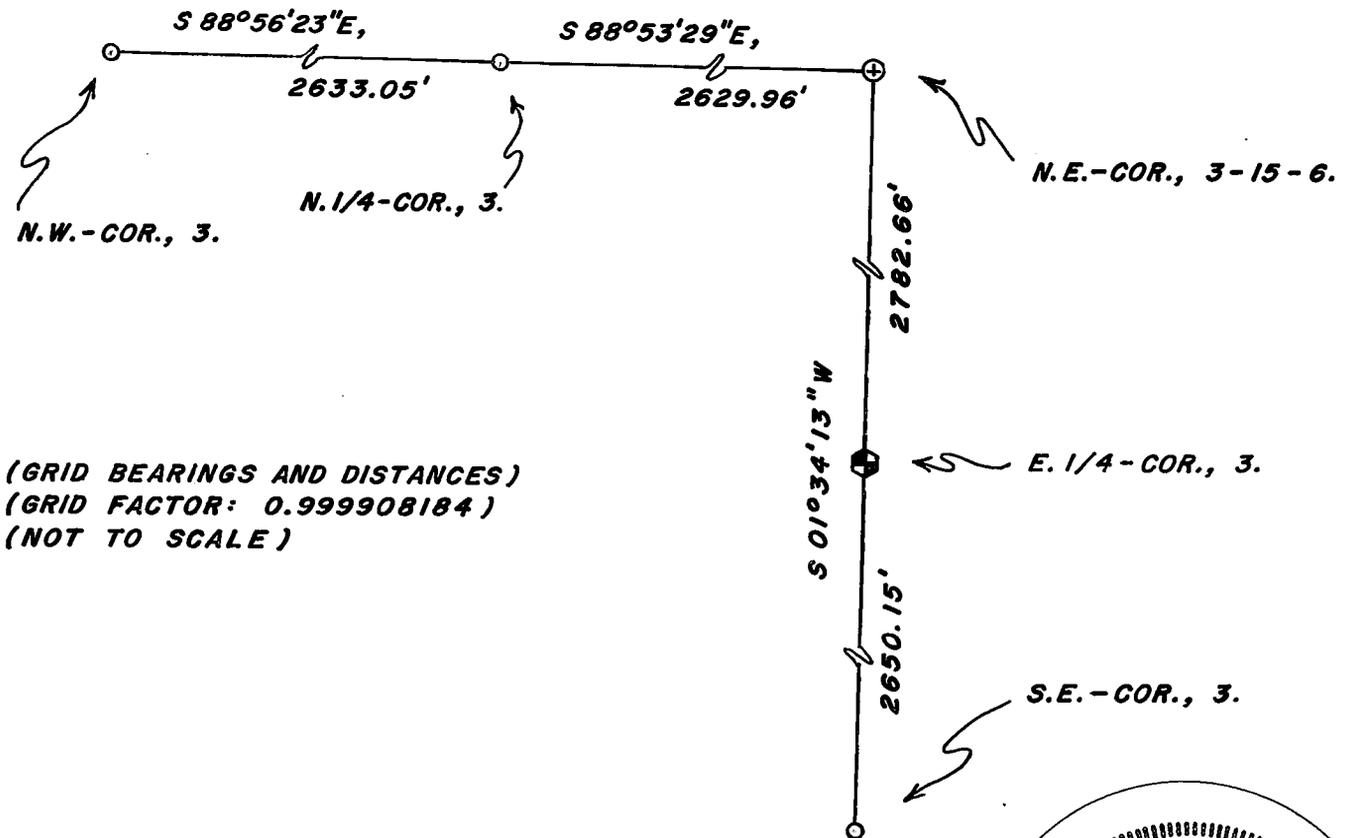

I, WILLIAM C. JUNG, COUNTY SURVEYOR
HEREBY CERTIFY THAT THE CORNER LOCATION SHOWN ON THIS RECORD WAS DETERMINED BY ME OR UNDER MY DIRECTION AND CONTROL AND THAT THIS U. S. PUBLIC LAND SURVEY MONUMENT RECORD IS CORRECT AND COMPLETE TO THE BEST OF MY KNOWLEDGE AND BELIEF.

William C. Jung 1/15/03
Signature Date



Seal