


21606340020

U. S. PUBLIC LAND SURVEY MONUMENT RECORD

SECTION 3 T 15 N, R 6 W, TOWN OF GREENFIELD

LA CROSSE COUNTY

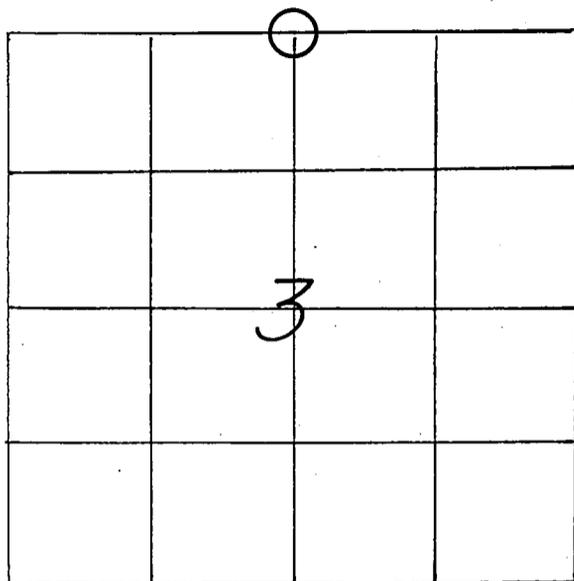

LOCATION OF LANDMARK

CREW: WILLIAM C. JUNG
 PETER F. FOLLANSBEE
 DATE: 5/06/2002

WISCONSIN COORDINATE SYSTEM

North 662,428.436

East 1,683,214.397

Theta Angle

Horiz. Order

Vert. Order

DATUM: 1983('91)

TYPE OF LANDMARK

2-1/4" IRON PIPE (O.D.).

BEARINGS ARE REFERENCED TO

GRID NORTH AS PER SECTION DATA.

Describe any record evidence, monument evidence, testimonial evidence or any other material evidence you considered and whether the monument was found or restored through acceptance of an obliterated evidence location.


Rob Lampman set an iron pipe at the corner in 1984. I found the pipe disturbed by time and the elements. I reset Lampman's pipe and took new ties.

Describe or show any material discrepancy between the location of the restored corner and that of the corner previously restored or reestablished.

NONE KNOWN.

RECORD OF DURABLE WITNESS MONUMENTS
MAGNETIC


NO	DESCRIPTION	BEARING	DISTANCE
1	SET A NAIL IN N.E.-SIDE OF A 5" ASPEN	N 64° W	10.32 FT.
2	SET A NAIL IN W.-SIDE OF A 5" ASPEN	N 04° W	10.38 FT.
3	SET A NAIL IN W.-SIDE OF A 9" ASPEN	N 13° E	17.69 FT.
4	SET A NAIL IN W.-SIDE OF A 4-1/2" ASPEN	S 03° W	24.54 FT.

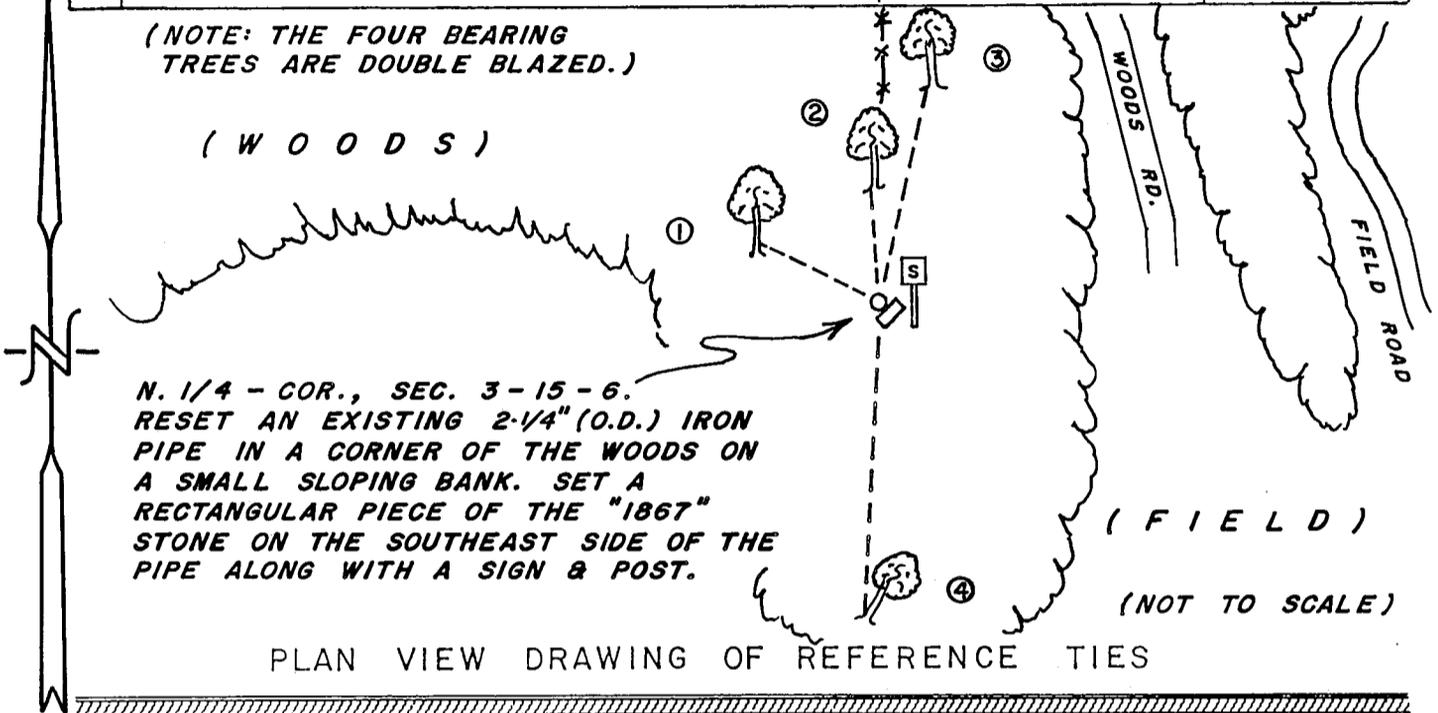

N. 1/4 - COR., SEC. 3-15-6.
RESET AN EXISTING 2-1/4" (O.D.) IRON PIPE IN A CORNER OF THE WOODS ON A SMALL SLOPING BANK. SET A RECTANGULAR PIECE OF THE "1867" STONE ON THE SOUTHEAST SIDE OF THE PIPE ALONG WITH A SIGN & POST.

MAP SHOWING DISTANCE AND DIRECTION TO OTHER PUBLIC LAND SURVEY CORNERS USED FOR REESTABLISHING THE CORNER

(GRID BEARINGS & DISTANCES)
(GRID FACTOR: 0.999908184)
(NOT TO SCALE)

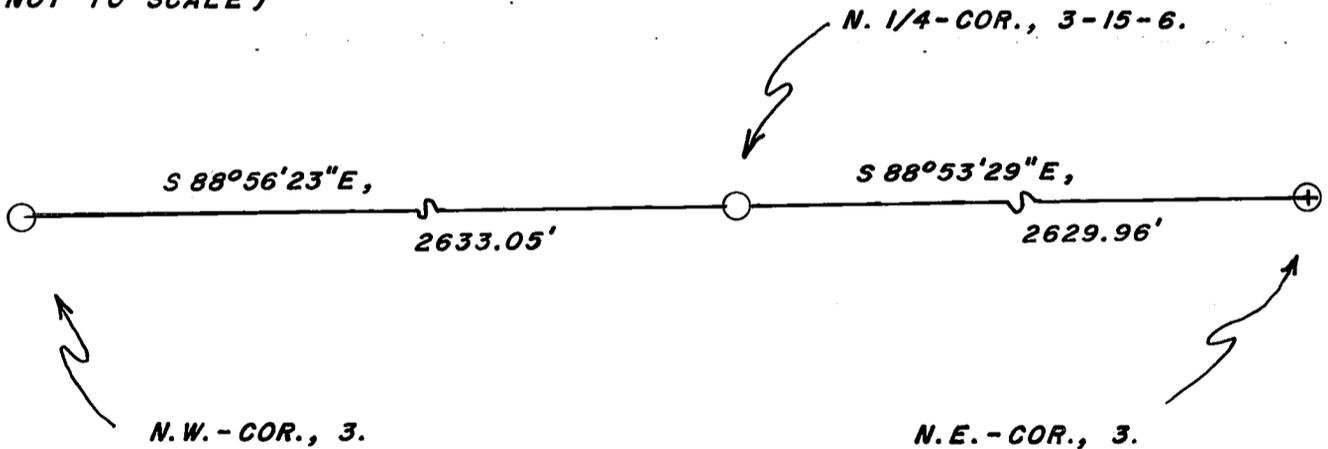

I, WILLIAM C. JUNG, COUNTY SURVEYOR
HEREBY CERTIFY THAT THE CORNER LOCATION SHOWN ON THIS RECORD WAS DETERMINED BY ME OR UNDER MY DIRECTION AND CONTROL AND THAT THIS U. S. PUBLIC LAND SURVEY MONUMENT RECORD IS CORRECT AND COMPLETE TO THE BEST OF MY KNOWLEDGE AND BELIEF.

William C. Jung May 28, 2002
Signature Date



Seal