


21606350000

U. S. PUBLIC LAND SURVEY MONUMENT RECORD

SECTION 1 T 15 N, R 6 W, TOWN OF GREENFIELD
 LA CROSSE COUNTY

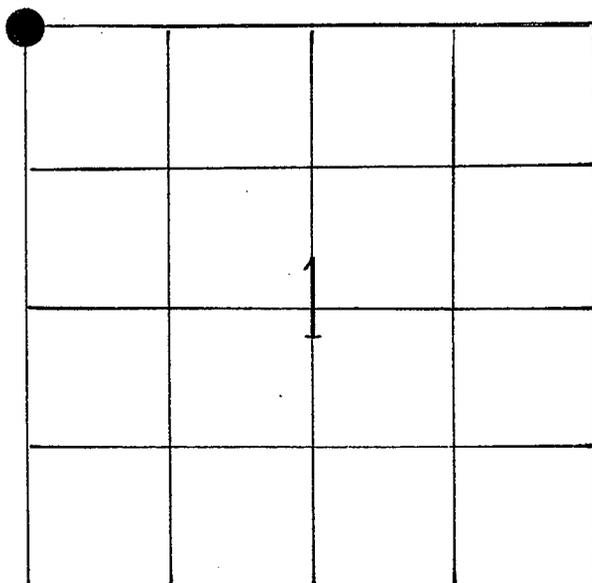

LOCATION OF LANDMARK

Crew: William Jung

2/22/85

WISCONSIN COORDINATE SYSTEM
North
East
Theta Angle
Horiz. Order
Vert. Order
TYPE OF LANDMARK
1"x31" IRON PIPE
BEARINGS ARE REFERENCED TO
Assumed

Describe any record evidence, monument evidence, testimonial evidence or any other material evidence you considered and whether the monument was found or restored through acceptance of an obliterated evidence location.

This corner shows up on surveys done by the County Highway Department, Clayton Solberg, and Marcou, but none of the maps call for any type of monument. Gary Watts set a pipe at this corner using Solberg's data, but it did not fit the fence corner. His pipe also had been knocked out. The line fence to the North is very old. Mrs. Noelke said that her husband put the new corner post where the old one was. The old wire supports this. I measured North 1/8 of a mile to a fence going to the West, 1/2 mile North to a stone, and 1/2+ mile to the South to a fence going to the West. I also talked to Mr. Schmidt. (continued)
 Describe or show any material discrepancy between the location of the restored corner and that of the corner previously restored or reestablished.


(refer to above notes)

(continued)

Mr. Schmidt said that his father and grandfaXther had also been on the farm. To his knowledge the fence corner had been there at least 50 years and had always been assumed to be the corner. He never saw a stone or iron pipe. I accepted the old occupied corner as the best available evidence of the original government corner. Ray Pelishek and Gary Watts agreed with this. I set a 1"x31" iron pipe at the corner

RECORD OF DURABLE WITNESS MONUMENTS


NO	DESCRIPTION	BEARING	DISTANCE
1	SET 1"x3½ FT. SQUARE BAR	West ±	16.5'
2	CENTERLINE OF CREEK	South +	35'±
3	SET 1¼"x27" IRON PIPE	East ±	16.44'
4	SET 1"x22" IRON PIPE	North ±	16.3'

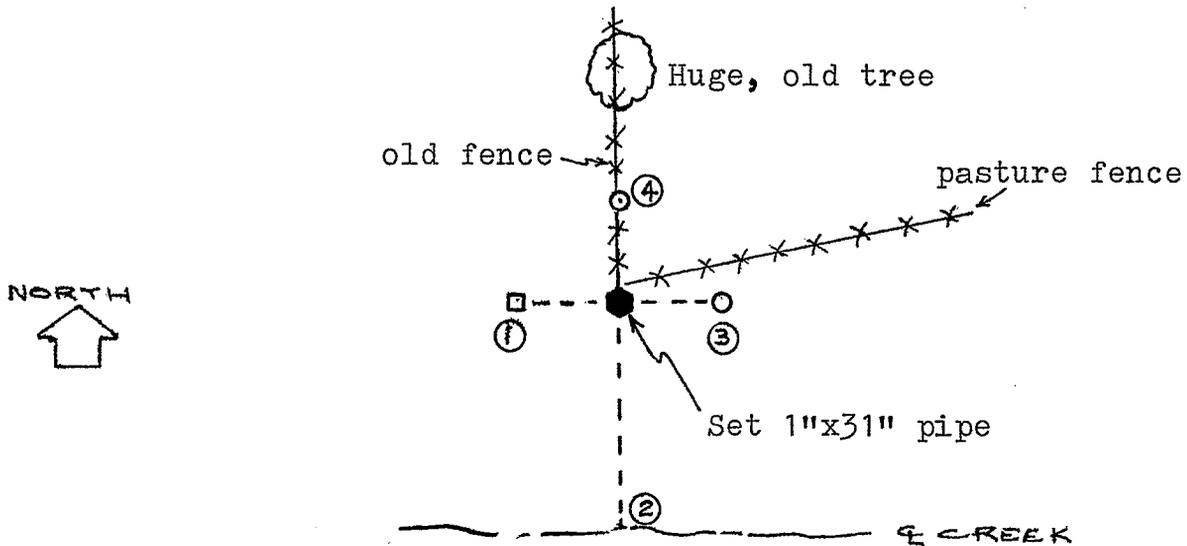

PLAN VIEW DRAWING OF REFERENCE TIES

MAP SHOWING DISTANCE AND DIRECTION TO OTHER PUBLIC LAND SURVEY CORNERS USED FOR REESTABLISHING THE CORNER


(not to scale)

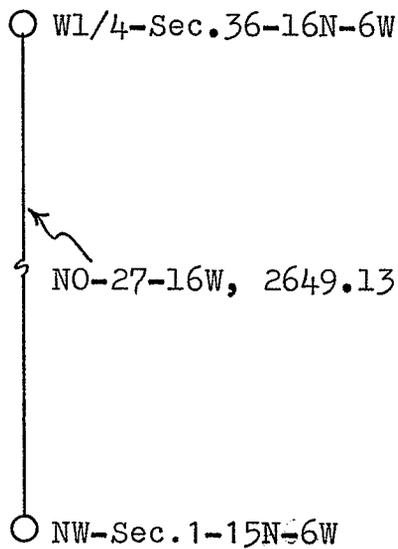

I, William C. Jung, Deputy County Surveyor,
 HEREBY CERTIFY THAT THE CORNER LOCATION SHOWN ON THIS RECORD
 WAS DETERMINED BY ME OR UNDER MY DIRECTION AND CONTROL AND
 THAT THIS U. S. PUBLIC LAND SURVEY MONUMENT RECORD IS CORRECT
 AND COMPLETE TO THE BEST OF MY KNOWLEDGE AND BELIEF.

William C. Jung
 Signature

2/12/86
 Date

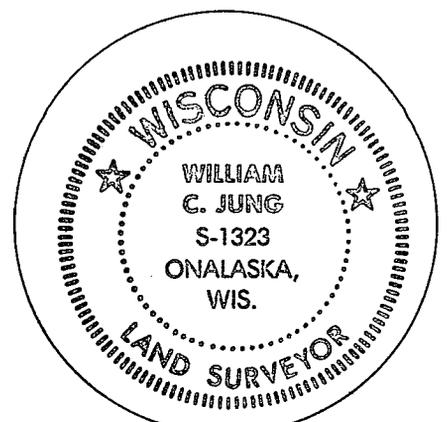

Seal