


21606350020

## U. S. PUBLIC LAND SURVEY MONUMENT RECORD

SECTION 2 T 15 N, R 6 W, TOWN OF Greenfield

LA CROSSE COUNTY

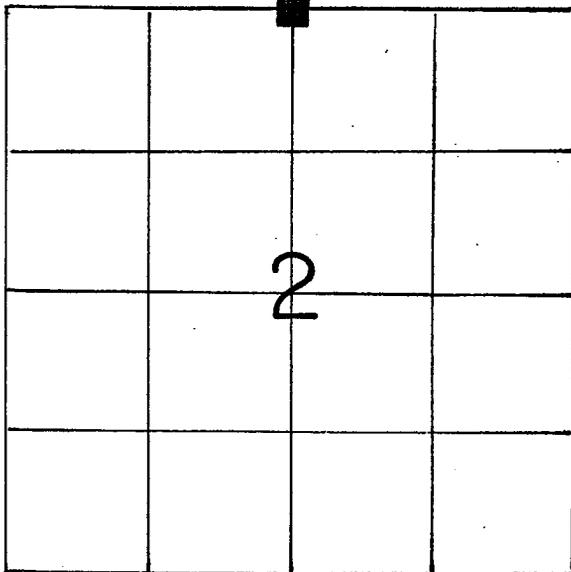

LOCATION OF LANDMARK

Crew: William C. Jung  
Peter F. Follansbee

Date: December 11, 1990

Describe any record evidence, monument evidence, testimonial evidence or any other material evidence you considered and whether the monument was found or restored through acceptance of an obliterated evidence location.

We found a 6" square stone laying on the ground. It appeared to have<sup>been</sup> "kicked out" by the frost. The bedrock was not down very far. The stone was scribed "1/4S". We placed the stone back in the ground, up 7". A 1" iron pipe was set as a witness pipe on the Northeast side of the stone.

Describe or show any material discrepancy between the location of the restored corner and that of the corner previously restored or reestablished.

None known.

## WISCONSIN COORDINATE SYSTEM

North

East

Theta Angle

Horiz. Order

Vert. Order

## TYPE OF LANDMARK

Stone


## BEARINGS ARE REFERENCED TO

True

RECORD OF DURABLE WITNESS MONUMENTS

Magnetic


NO	DESCRIPTION	BEARING	DISTANCE
1	P.K. nail in double blazed 12" oak with sign	N18°W	41.87
2	" " " " " 12" oak	N28°W	50.64
3	" " " " " 6" hickory	N81°W	39.92
4	" " " " " 10" oak	S40°W	slope= 63.93

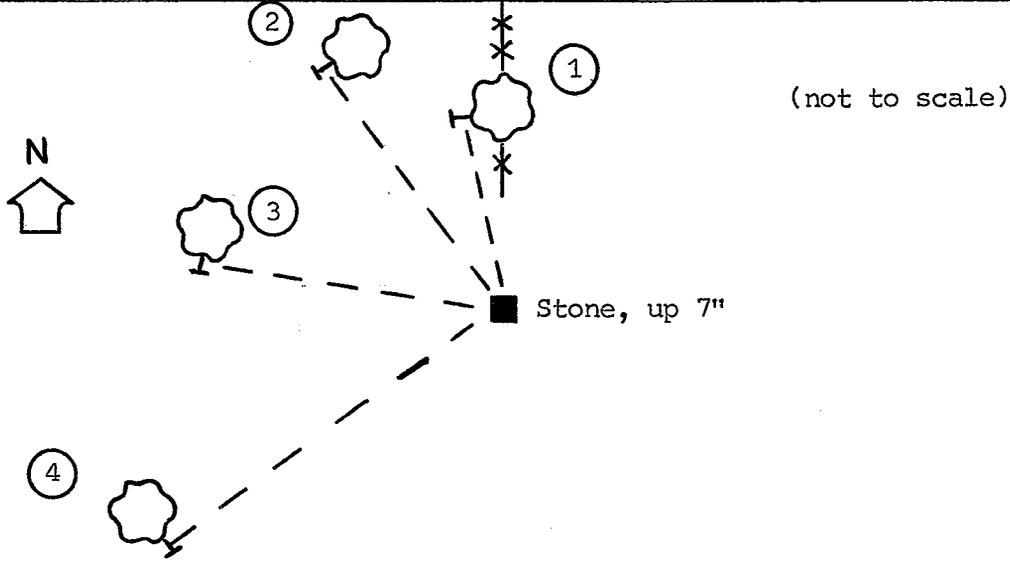

PLAN VIEW DRAWING OF REFERENCE TIES

MAP SHOWING DISTANCE AND DIRECTION TO OTHER PUBLIC LAND SURVEY CORNERS USED FOR REESTABLISHING THE CORNER


(not to scale)

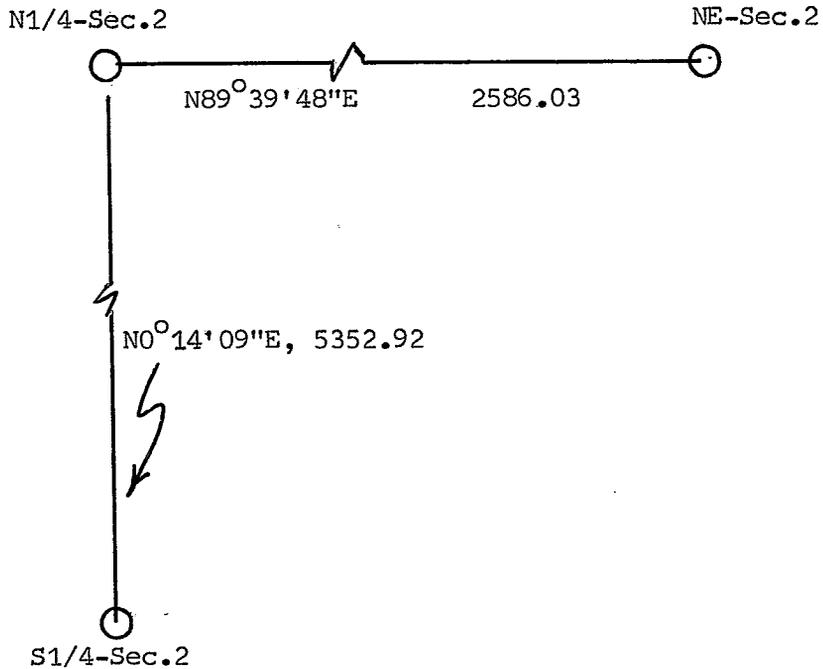

I, William C. Jung, Deputy County Surveyor,  
 HEREBY CERTIFY THAT THE CORNER LOCATION SHOWN ON THIS RECORD  
 WAS DETERMINED BY ME OR UNDER MY DIRECTION AND CONTROL AND  
 THAT THIS U. S. PUBLIC LAND SURVEY MONUMENT RECORD IS CORRECT  
 AND COMPLETE TO THE BEST OF MY KNOWLEDGE AND BELIEF.

William C. Jung  
 Signature

January 4, 1991  
 Date

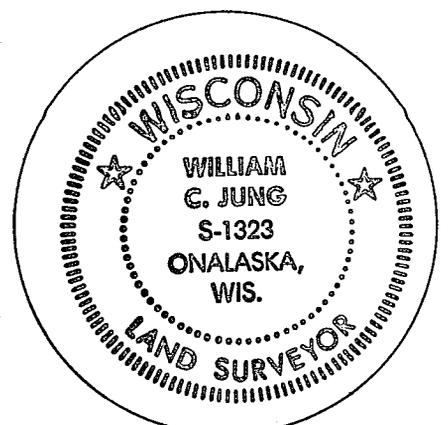

Seal