


## U. S. PUBLIC LAND SURVEY MONUMENT RECORD

SECTION 1 T 15 N, R 6 W, TOWN OF GREENFIELD

LA CROSSE COUNTY

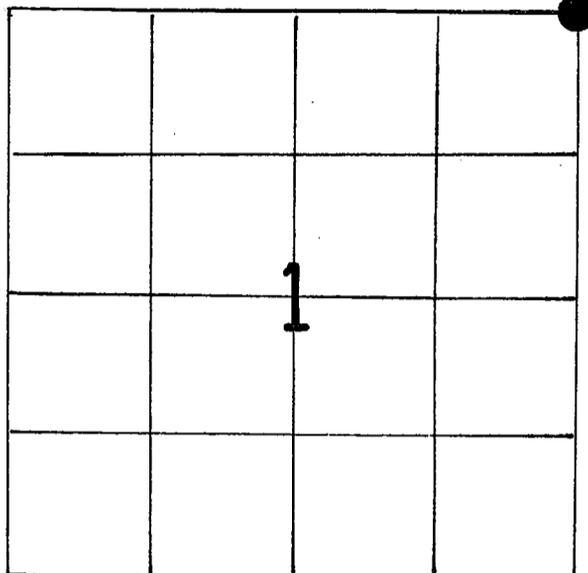

LOCATION OF LANDMARK

Crew: WILLIAM C. JUNG  
PETER F. FOLLANSBEE

Date: 11/10/1992

Describe any record evidence, monument evidence, testimonial evidence or any other material evidence you considered and whether the monument was found or restored through acceptance of an obliterated evidence location.

I would assume that there was a stone at this corner at one time. We searched extensively for the stone or evidence of it but to no avail. I set this town corner by double proportionate measurement. The corner was monumented with a brass capped Lunde marker. The stone was probably destroyed when the logging road was put in.

Describe or show any material discrepancy between the location of the restored corner and that of the corner previously restored or reestablished.

None Known

WISCONSIN COORDINATE SYSTEM

North

East

Theta Angle

Horiz. Order

Vert. Order

TYPE OF LANDMARK


Set brass cap Lunde marker.

BEARINGS ARE REFERENCED TO


True

RECORD OF DURABLE WITNESS MONUMENTS  
MAGNETIC

NO	DESCRIPTION	BEARING	DISTANCE
1	Set P.K. Nail in N-side 21" double Oak	N 87 W	27.84 Ft.
2	Set P.K. Nail in W-side 20" Dbl. W. Oak	N 05 E	66.85 Ft.
3	Set P.K. Nail in S-side 5" Hickory	N 77 E	18.26 Ft.
4	Set P.K. Nail in NW-side 18" Dbl. W. Oak	S 30 W	SLOPE = 54.86 Ft.

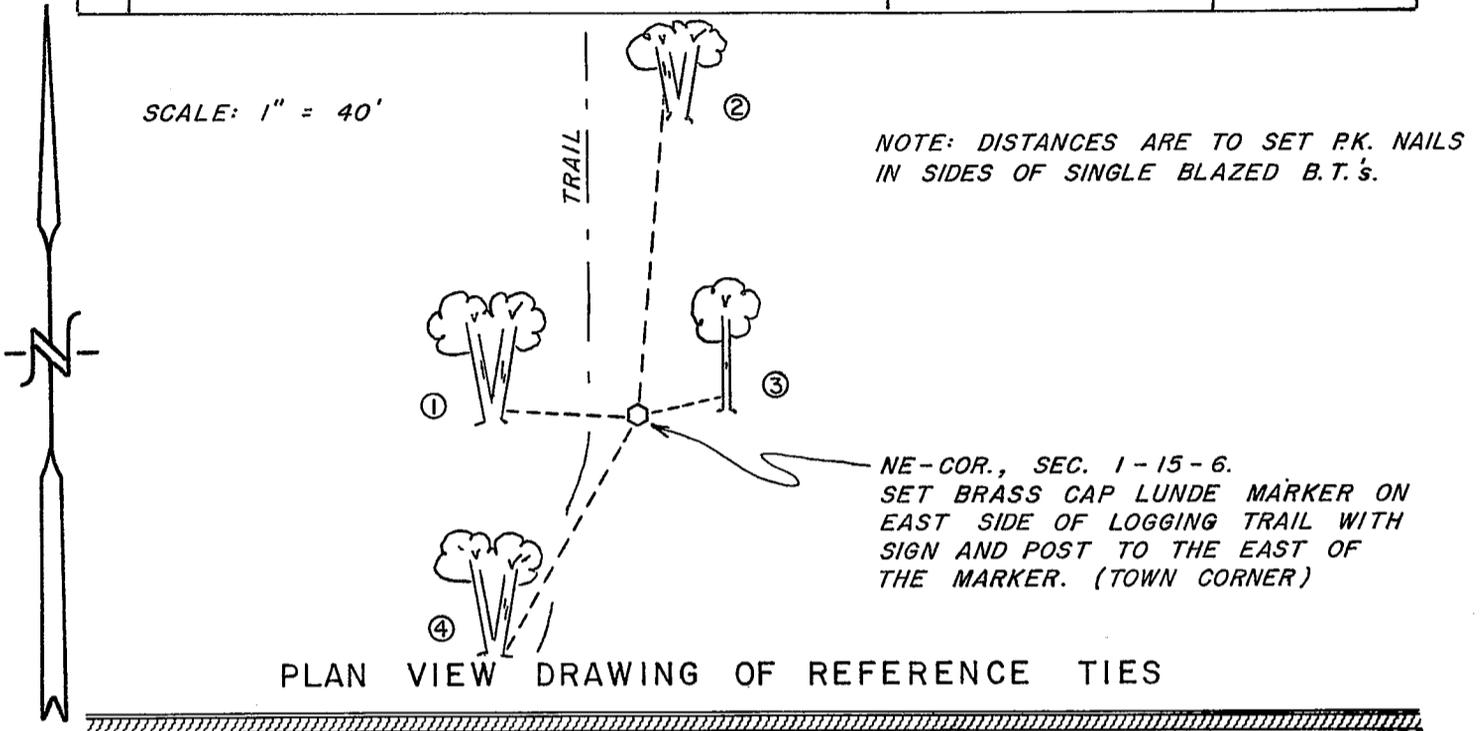


MAP SHOWING DISTANCE AND DIRECTION TO OTHER PUBLIC LAND SURVEY CORNERS USED FOR REESTABLISHING THE CORNER  
(not to scale)

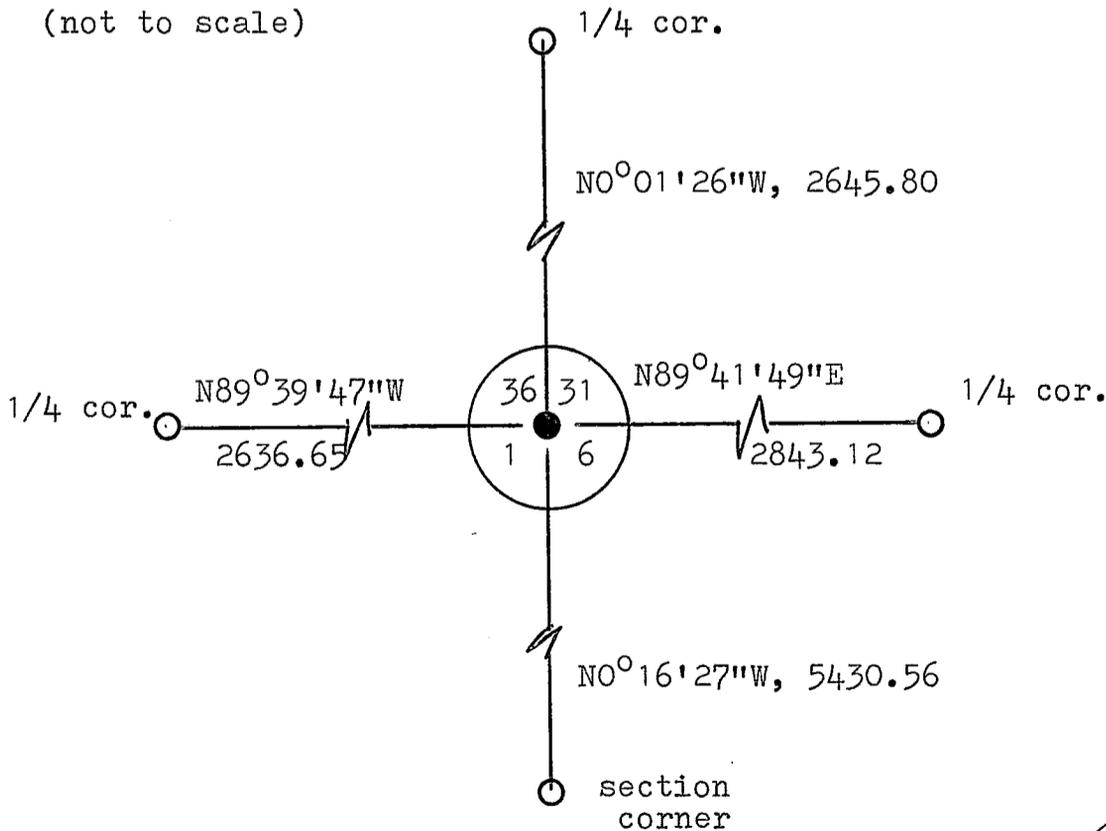

I, William C. Jung, Deputy County Surveyor  
HEREBY CERTIFY THAT THE CORNER LOCATION SHOWN ON THIS RECORD WAS DETERMINED BY ME OR UNDER MY DIRECTION AND CONTROL AND THAT THIS U. S. PUBLIC LAND SURVEY MONUMENT RECORD IS CORRECT AND COMPLETE TO THE BEST OF MY KNOWLEDGE AND BELIEF.

William C. Jung  
Signature

November 12, 1992  
Date

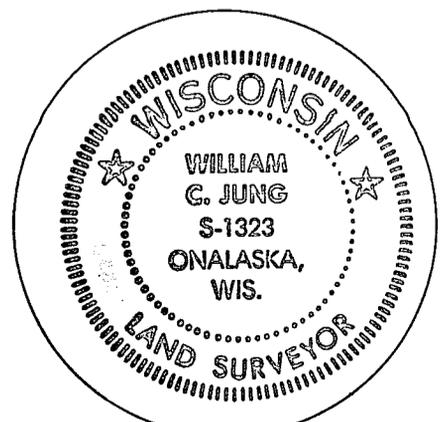

Seal