


U. S. PUBLIC LAND SURVEY MONUMENT RECORD

SECTION 1 T 15 N, R 6 W, TOWN OF Greenfield

LA CROSSE COUNTY

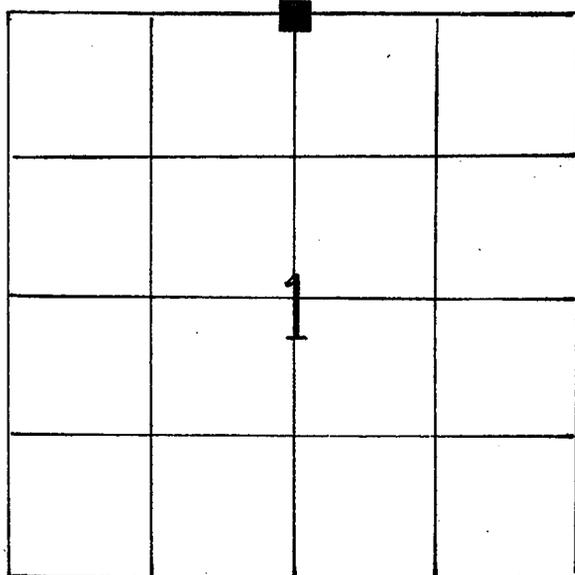

LOCATION OF LANDMARK

Crew: William C. Jung
Peter F. Follansbee

Date: December 10, 1990

Describe any record evidence, monument evidence, testimonial evidence or any other material evidence you considered and whether the monument was found or restored through acceptance of an obliterated evidence location.

We found a 6" square stone, slightly tipped. The stone was scribed "1/4S". We plumbed the stone back up. The stone at the occupied corner was accepted as the best available evidence of the original government corner.

Describe or show any material discrepancy between the location of the restored corner and that of the corner previously restored or reestablished.

None known.

WISCONSIN COORDINATE SYSTEM

North

East

Theta Angle

Horiz. Order

Vert. Order

TYPE OF LANDMARK


Stone

BEARINGS ARE REFERENCED TO

True

RECORD OF DURABLE WITNESS MONUMENTS
Magnetic


NO	DESCRIPTION	BEARING	DISTANCE
1	P.K. nail in double blazed double 6" birch	N14°E	1.50
2	" " " " " 7" birch	N81°W	6.17
3	" " " single " 30" white oak	S27°W	slope=150.78
4	" " " " " 27" burr oak	S17°W	slope= 87.87

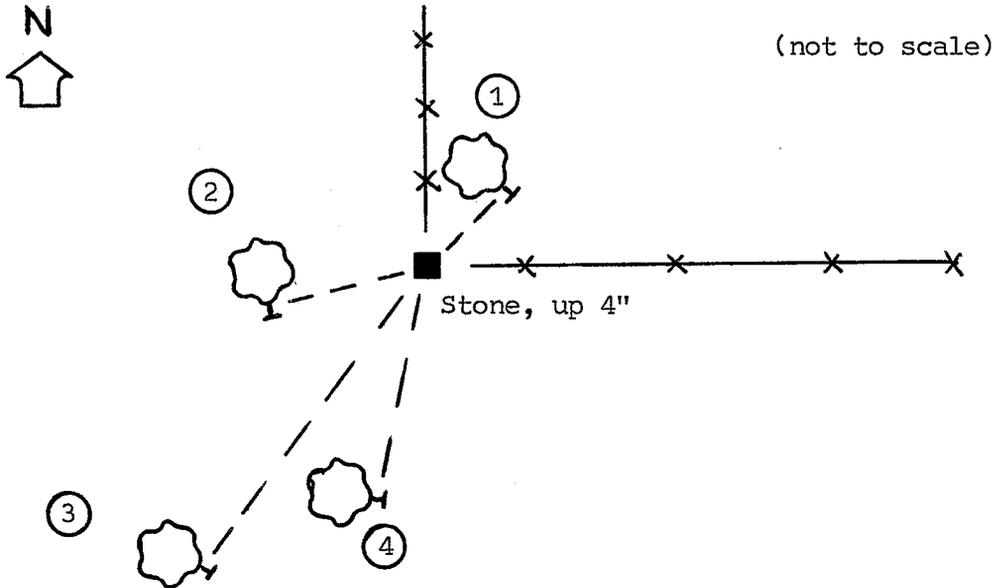

PLAN VIEW DRAWING OF REFERENCE TIES

MAP SHOWING DISTANCE AND DIRECTION TO OTHER PUBLIC LAND SURVEY CORNERS USED FOR REESTABLISHING THE CORNER

(not to scale)

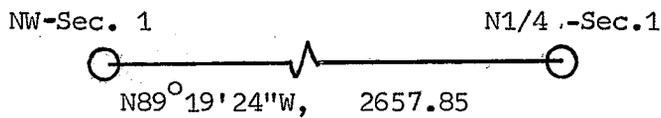

I, William C. Jung, Deputy County Surveyor,
HEREBY CERTIFY THAT THE CORNER LOCATION SHOWN ON THIS RECORD
WAS DETERMINED BY ME OR UNDER MY DIRECTION AND CONTROL AND
THAT THIS U. S. PUBLIC LAND SURVEY MONUMENT RECORD IS CORRECT
AND COMPLETE TO THE BEST OF MY KNOWLEDGE AND BELIEF.

William C. Jung
Signature

January 4, 1991
Date



Seal