


21507010020

U. S. PUBLIC LAND SURVEY MONUMENT RECORD

SECTION 1 T 15 N, R 7 W, TOWN OF SHELBY

LA CROSSE COUNTY

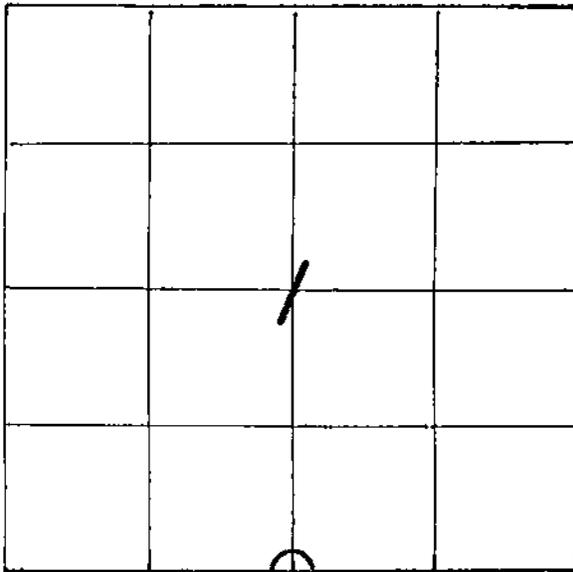

LOCATION OF LANDMARK

CREW: **WILLIAM C. JUNG**
PETER F. FOLLANSBEE
 DATE: **4/25/2000**

WISCONSIN COORDINATE SYSTEM

North

East

Theta Angle

Horiz. Order

Vert. Order

TYPE OF LANDMARK

EXISTING 1" PINCHED PIPE.

BEARINGS ARE REFERENCED TO

Describe any record evidence, monument evidence, testimonial evidence or any other material evidence you considered and whether the monument was found or restored through acceptance of an obliterated evidence location.


I found an iron pipe at the old occupied corner. This pipe had been used as the corner in previous survey work. I accepted it as the best available evidence of the original government corner location.

Describe or show any material discrepancy between the location of the restored corner and that of the corner previously restored or reestablished.

NONE KNOWN.

RECORD OF DURABLE WITNESS MONUMENTS
MAGNETIC

NO	DESCRIPTION	BEARING	DISTANCE
1	EX. SPIKE IN N.-SIDE 18" OAK	S 70° W	17.14 FT.
2	EX. SPIKE IN S.W.-SIDE 12" HICKORY	N 64° W	21.16 FT.
3	SET NAIL IN S.W.-SIDE 6" NUT TREE	N 29° W	19.75 FT.
4	EX. SPIKE IN S.W.-SIDE 18" HICKORY	S 89° E	26.46 FT.

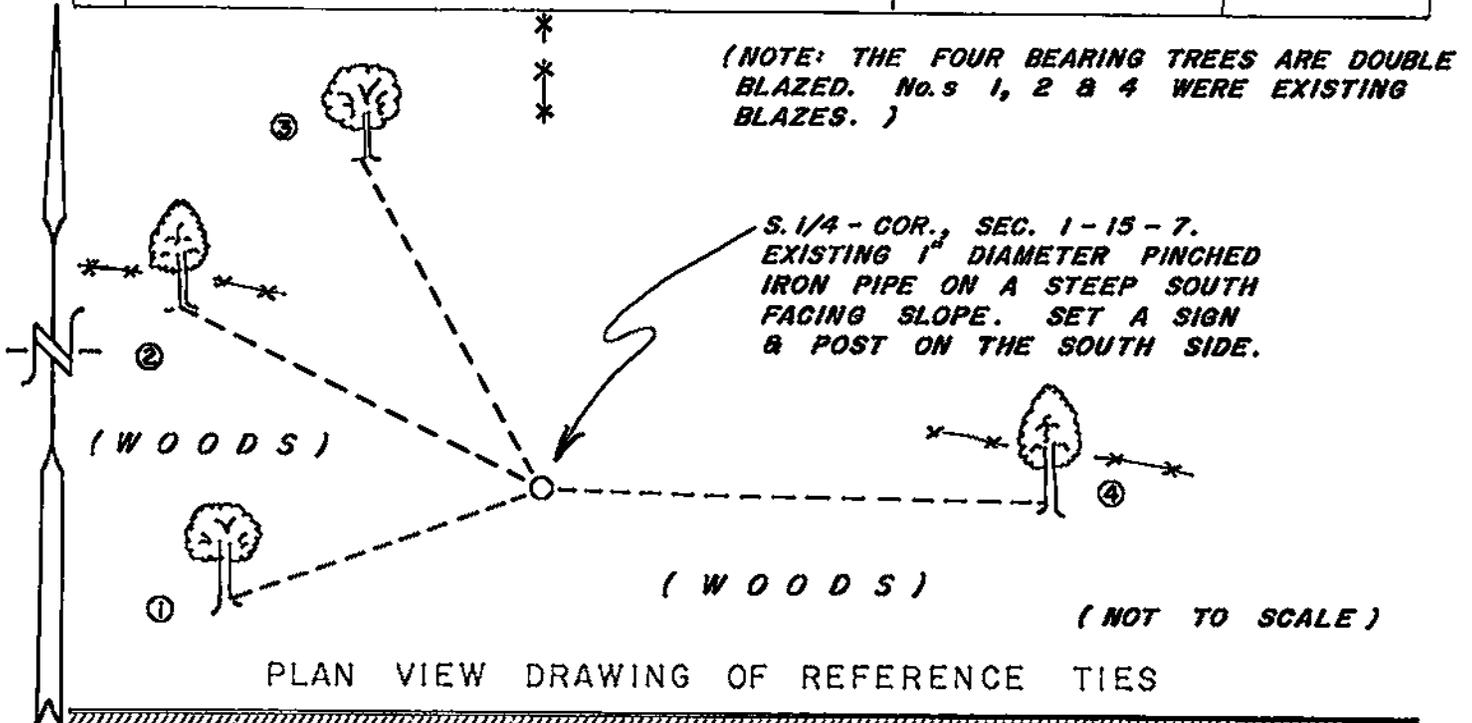

MAP SHOWING DISTANCE AND DIRECTION TO OTHER PUBLIC LAND SURVEY CORNERS USED FOR REESTABLISHING THE CORNER

No section measurements were made by me at this time. The location of this corner had been confirmed by others in previous surveys.

I, WILLIAM C. JUNG, COUNTY SURVEYOR
HEREBY CERTIFY THAT THE CORNER LOCATION SHOWN ON THIS RECORD WAS DETERMINED BY ME OR UNDER MY DIRECTION AND CONTROL AND THAT THIS U. S. PUBLIC LAND SURVEY MONUMENT RECORD IS CORRECT AND COMPLETE TO THE BEST OF MY KNOWLEDGE AND BELIEF.

William C. Jung 12/13/00
Signature Date



Seal