


21507020020

## U. S. PUBLIC LAND SURVEY MONUMENT RECORD

SECTION 2 T 15 N, R 7 W, TOWN OF SHELBY

LA CROSSE COUNTY

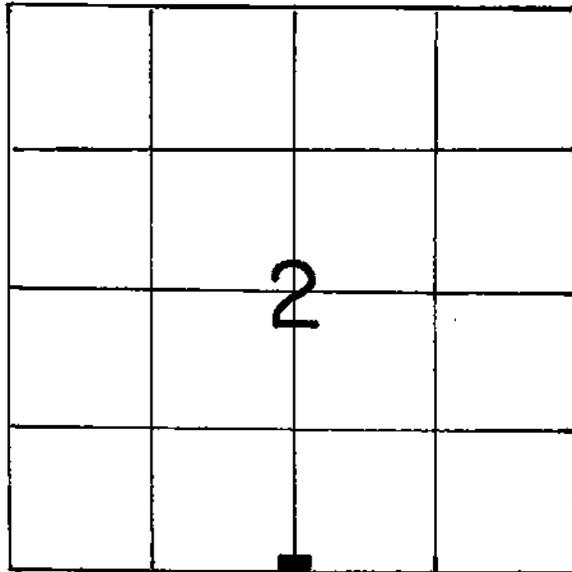

LOCATION OF LANDMARK

Crew: WILLIAM C. JUNG  
 PETER F. FOLLANSBEE

Date: 3/30/1992

Describe any record evidence, monument evidence, testimonial evidence or any other material evidence you considered and whether the monument was found or restored through acceptance of an obliterated evidence location.

I found a field stone at the occupied corner and accepted it as the best available evidence of the original government corner position. This stone had been used as the corner in many previous surveys of record.

Describe or show any material discrepancy between the location of the restored corner and that of the corner previously restored or reestablished.

Several surveys of record indicate an iron pipe at this corner. This pipe was probably the guard pipe to the North. The pipe is just that, a guard or witness pipe, not the corner.

WISCONSIN COORDINATE SYSTEM

North

East

Theta Angle

Horiz. Order

Vert. Order

TYPE OF LANDMARK

Triangular Field Stone.


BEARINGS ARE REFERENCED TO

RECORD OF DURABLE WITNESS MONUMENTS

NO	DESCRIPTION	BEARING	DISTANCE
1	Set P.K. Nail in E-side 20" Hickory	Southerly	32.71 Ft.
2	Set P.K. Nail in SE-side 16" D'ble Hick.	Southwesterly	(SLOPE) 55.43 Ft.
3	Set 1" x 17" Iron Pipe	Northwesterly	17.11 Ft.
4	Set P.K. Nail in NW-side 23" Hickory	Northeasterly	3.28 Ft.

(NO SCALE)

NOTE: BEARING TREES ARE HICKORIES (UNBLAZED) WITH DISTANCES MEASURED TO P.K. NAILS SET IN THE SIDES.

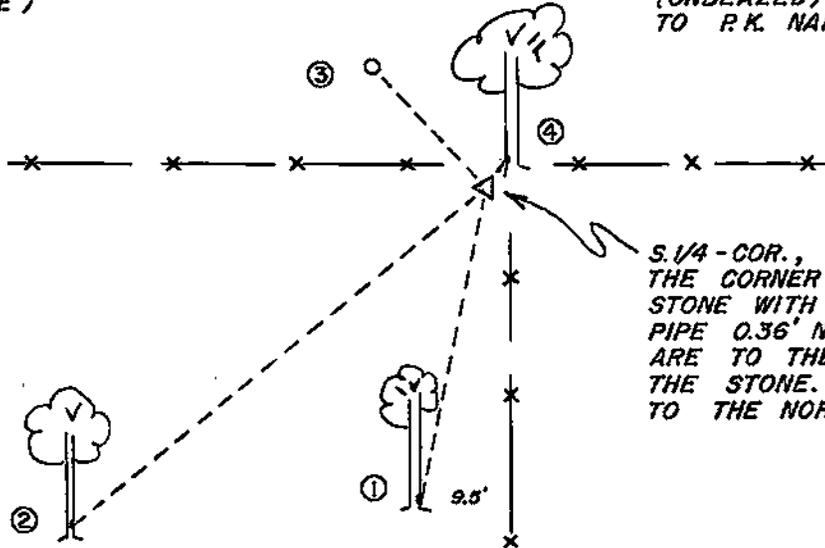

S. 1/4 - COR., SEC. 2-15-7.  
THE CORNER IS A TRIANGULAR FIELD STONE WITH AN EXISTING 1" GUARD PIPE 0.36' NORTH. THE DISTANCES ARE TO THE CENTER OF MASS OF THE STONE. SET SIGN AND POST TO THE NORTHWEST.


PLAN VIEW DRAWING OF REFERENCE TIES

MAP SHOWING DISTANCE AND DIRECTION TO OTHER PUBLIC LAND SURVEY CORNERS USED FOR REESTABLISHING THE CORNER

No section measurements were made by me at this time. The corner position was confirmed by previous surveys.

I, William C. Jung, Deputy County Surveyor  
HEREBY CERTIFY THAT THE CORNER LOCATION SHOWN ON THIS RECORD WAS DETERMINED BY ME OR UNDER MY DIRECTION AND CONTROL AND THAT THIS U. S. PUBLIC LAND SURVEY MONUMENT RECORD IS CORRECT AND COMPLETE TO THE BEST OF MY KNOWLEDGE AND BELIEF.

William C. Jung January 7, 1993  
Signature Date

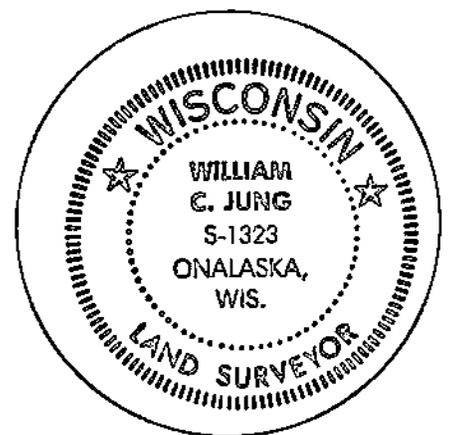

Seal