


21507022000

U. S. PUBLIC LAND SURVEY MONUMENT RECORD

SECTION 2 T 15 N, R 7 W, TOWN OF SHELBY

LA CROSSE COUNTY

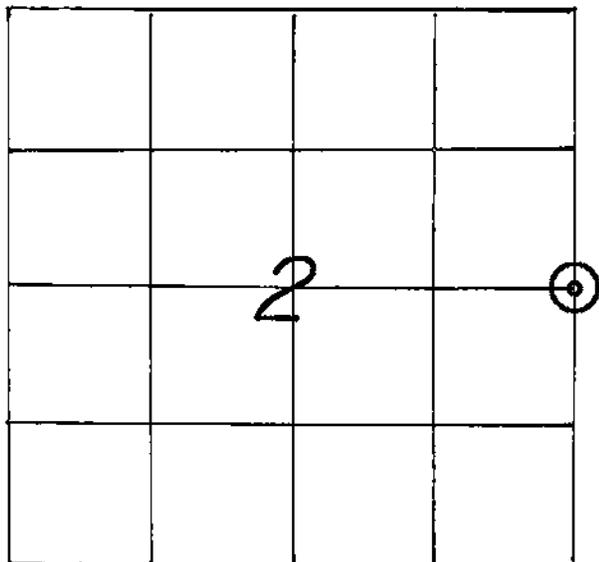

WISCONSIN COORDINATE SYSTEM

North

East

Theta Angle

Horiz. Order

Vert. Order

TYPE OF LANDMARK

1/4" IRON PIPE (O.D.), w/RED PLASTIC CAP.

BEARINGS ARE REFERENCED TO

ASSUMED NORTH AS PER SECTION DATA.

LOCATION OF LANDMARK

CREW: WILLIAM C. JUNG

PETER F. FOLLANSBEE

DATE: 10/03/2001

Describe any record evidence, monument evidence, testimonial evidence or any other material evidence you considered and whether the monument was found or restored through acceptance of an obliterated evidence location.

I found an iron pipe at the corner. This pipe had been used as the corner in previous survey work. I accepted it as the best available evidence of the original government corner position.

Describe or show any material discrepancy between the location of the restored corner and that of the corner previously restored or reestablished.

NONE KNOWN.

