


21507030000

U. S. PUBLIC LAND SURVEY MONUMENT RECORD

SECTION 2 T 15 N, R 7 W, TOWN OF SHELBY

LA CROSSE COUNTY

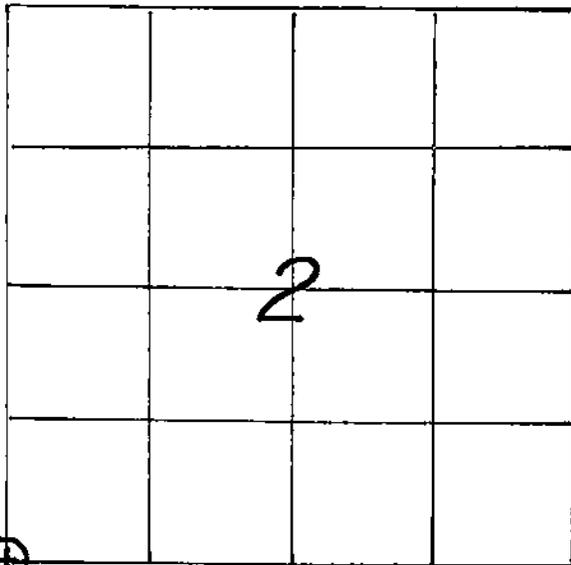

LOCATION OF LANDMARK

CREW: *WILLIAM C. JUNG*  
*PETER F. FOLLANSBEE*  
 DATE: *10/12/2001*

WISCONSIN COORDINATE SYSTEM

North

East

Theta Angle

Horiz. Order

Vert. Order

TYPE OF LANDMARK

*3/4" x 30" IRON BAR WITH ALUMINUM CAP.*

BEARINGS ARE REFERENCED TO

*ASSUMED NORTH AS PER SECTION DATA.*

Describe any record evidence, monument evidence, testimonial evidence or any other material evidence you considered and whether the monument was found or restored through acceptance of an obliterated evidence location.


I found an iron pipe at the corner that had been used as the section corner in previous survey work. I accepted this pipe as the best available evidence of the original government corner position. I set an iron bar with a cap inside of the pipe and pounded the entire monument down, flush.

Describe or show any material discrepancy between the location of the restored corner and that of the corner previously restored or reestablished.

**NONE KNOWN.**

**RECORD OF DURABLE WITNESS MONUMENTS  
ASSUMED NORTH**


NO.	DESCRIPTION	BEARING	DISTANCE
1	EXISTING IRON PIPE	N 02°08'17" E	225.48 FT.
2	SET P.K. NAIL IN N.W.-SIDE OF A 17" WHITE OAK	N 40°17'30" E	67.00 FT.
3	SET P.K. NAIL IN N.-SIDE OF A 23-1/2" OAK	S 88°34'59" E	66.84 FT.
4	SET P.K. NAIL IN N.W.-SIDE OF A 5-1/4" ASPEN	S 51°40'27" W	49.40 FT.

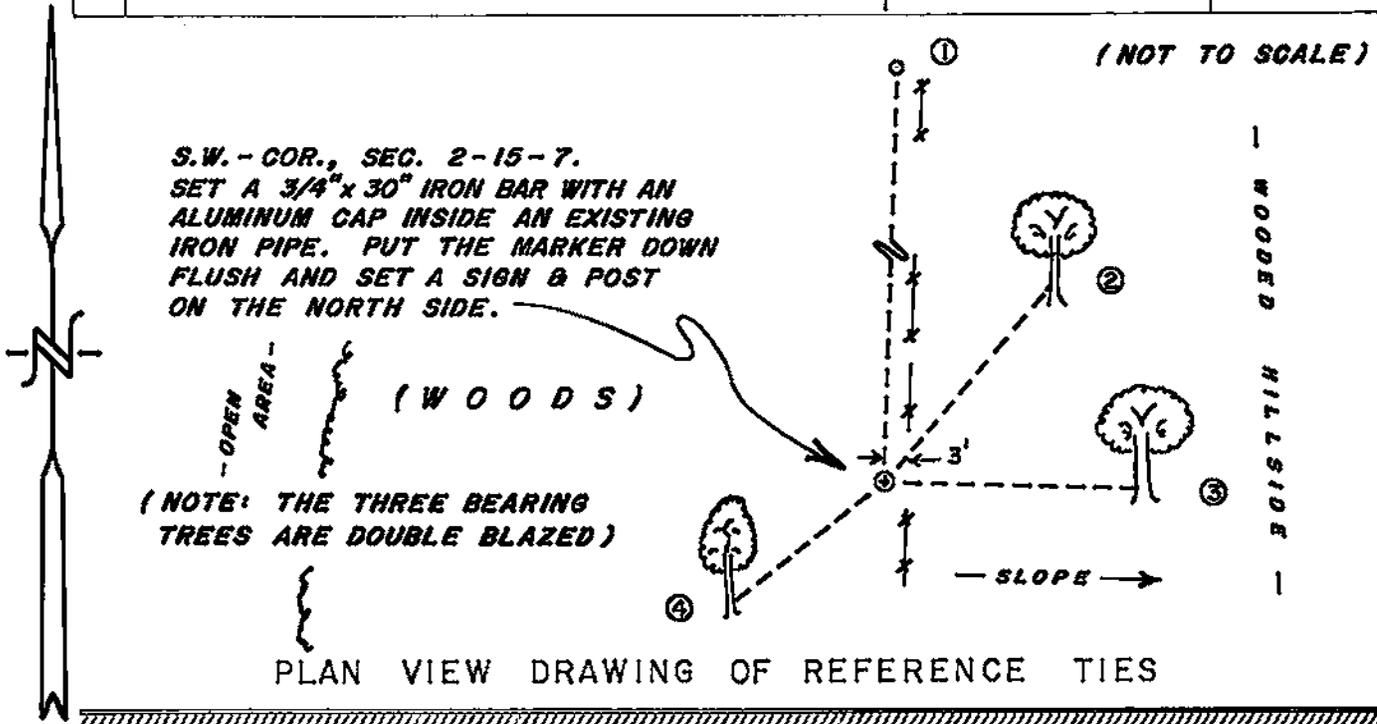

MAP SHOWING DISTANCE AND DIRECTION TO OTHER PUBLIC LAND SURVEY CORNERS USED FOR REESTABLISHING THE CORNER

(R.A. BERG MEASUREMENTS)  
(NOT TO SCALE)

Note: Other section work of record has also confirmed the location of this corner.

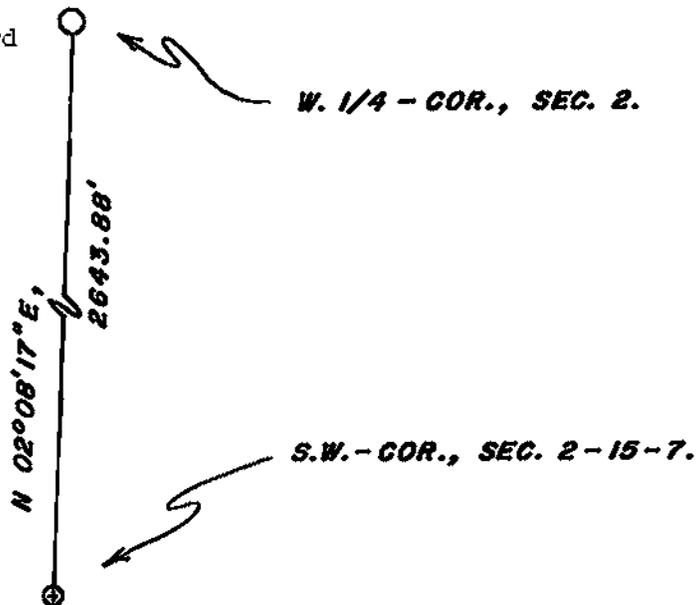

I, WILLIAM C. JUNG, COUNTY SURVEYOR  
HEREBY CERTIFY THAT THE CORNER LOCATION SHOWN ON THIS RECORD WAS DETERMINED BY ME OR UNDER MY DIRECTION AND CONTROL AND THAT THIS U. S. PUBLIC LAND SURVEY MONUMENT RECORD IS CORRECT AND COMPLETE TO THE BEST OF MY KNOWLEDGE AND BELIEF.

William C. Jung                      11/21/01  
Signature                                      Date



Seal