


21507030020

U. S. PUBLIC LAND SURVEY MONUMENT RECORD

SECTION 3 T 15 N, R 7 W, TOWN OF SHELBY

LA CROSSE COUNTY

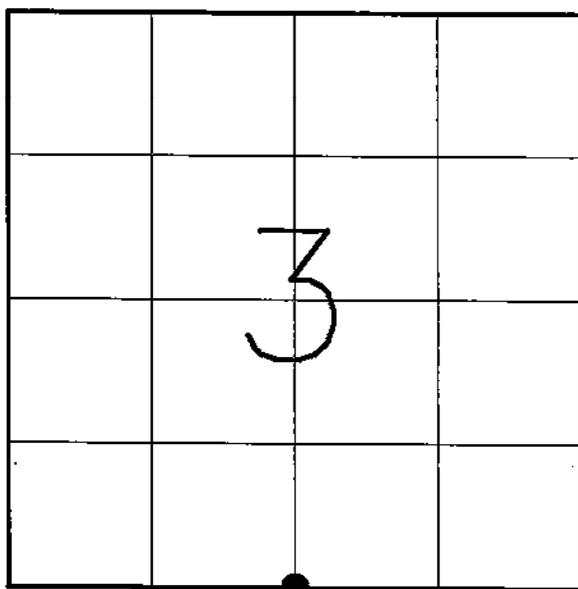

LOCATION OF LANDMARK

WISCONSIN COORDINATE SYSTEM
NORTH
EAST
THETA ANGLE
HORIZ. ORDER
VERT. ORDER
TYPE OF LANDMARK
FOUND 2" IRON PIPE
BEARINGS ARE REFERENCE TO LA CROSSE COUNTY COORDINATE SYSTEM (UNLESS OTHERWISE NOTED)

DESCRIBE ANY RECORDED EVIDENCE, MONUMENT EVIDENCE, TESTIMONIAL EVIDENCE, OR ANY OTHER MATERIAL EVIDENCE YOU CONSIDERED AND WHETHER THE MONUMENT WAS FOUND OR RESTORED THROUGH ACCEPTANCE OF AN OBLITERATED EVIDENCE LOCATION.

PREVIOUS SURVEYS SHOW SINGLE PORPORTION COMPUTED LOCATION FOR SOUTH QUARTER CORNER. A 2" IRON PIPE WAS FOUND NEAR COMPUTED LOCATION (\pm 30' SOUTH). I ACCEPTED 2" IRON PIPE AS SOUTH QUARTER CORNER LOCATION.


DESCRIBE OR SHOW ANY MATERIAL DISCREPANCY BETWEEN THE LOCATION OF THE RESTORED CORNER AND THAT OF THE CORNER PREVIOUSLY RESTORED OR REESTABLISHED.

NONE KNOWN

RECORD OF DURABLE WITNESS MONUMENT


NO	DESCRIPTION	BEARING	DISTANCE
1	SET PK NAIL IN 12" TREE	N 05° E *	4.89
2	SET PK NAIL IN 10" TREE	S 70° E *	21.40
3	SET 1 1/4" IRON BAR	S 00°48'51" E	29.22
4	SET PK NAIL IN 8" TREE	S 45° W *	37.05

* MAGNETIC BEARING

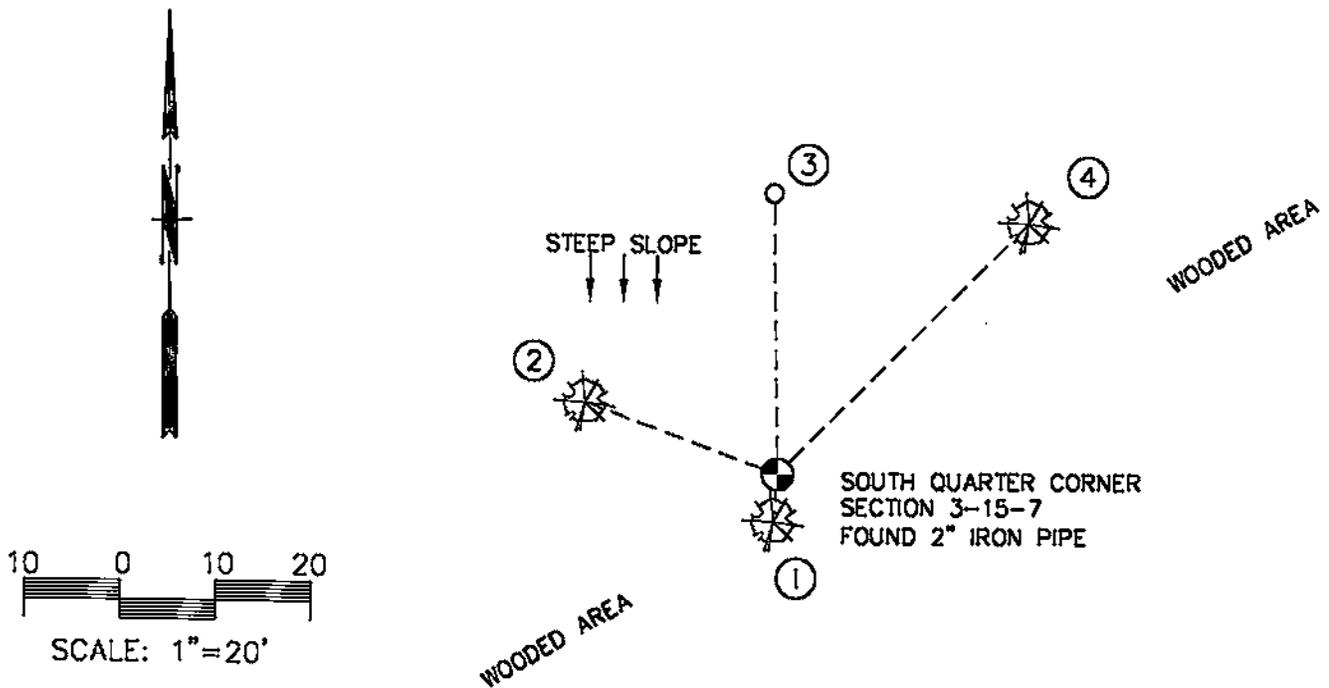

PLAN VIEW DRAWING OF REFERENCE TIES

MAP SHOWING DISTANCE AND DIRECTION TO OTHER PUBLIC LAND SURVEY CORNER USED FOR REESTABLISHING THE CORNER.

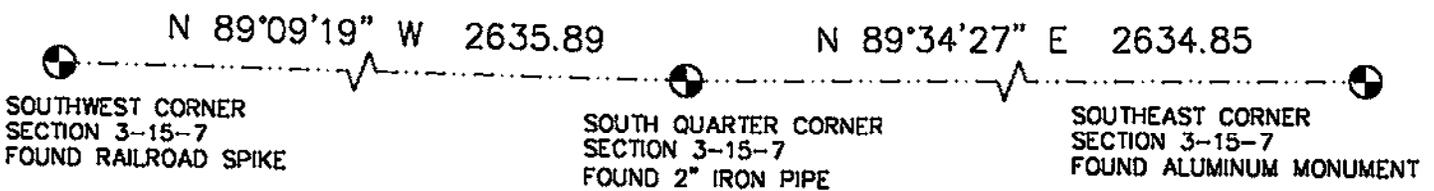

I, PAUL E. FAIRCHILD HEREBY CERTIFY THAT THE CORNER LOCATION SHOWN ON THIS RECORD WAS DETERMINED BY ME OR UNDER MY DIRECTION AND CONTROL AND THAT THIS U.S. PUBLIC LAND SURVEY MONUMENT IS CORRECT AND COMPLETE TO THE BEST OF MY KNOWLEDGE AND BELIEF.

SIGNATURE Paul E. Fairchild DATE 2-7-03

