


21507040000

U. S. PUBLIC LAND SURVEY MONUMENT RECORD

SECTION 9 T 15 N, R 7 W, ^{City}~~TOWN~~ OF LaCrosse

LA CROSSE COUNTY

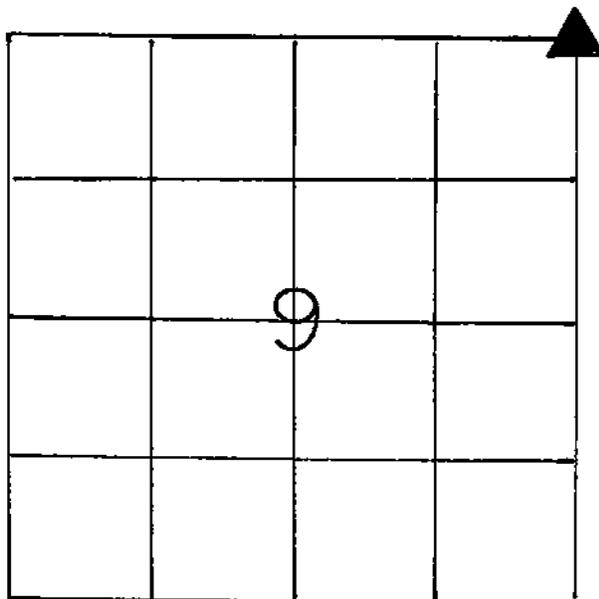

LOCATION OF LANDMARK

WISCONSIN COORDINATE SYSTEM

North

East

Theta Angle

Horiz. Order

Vert. Order

TYPE OF LANDMARK

Railroad spike

BEARINGS ARE REFERENCED TO

Assumed

Crew: William C. Jung
Peter F. Follansbee

Date: March 4, 1991

Describe any record evidence, monument evidence, testimonial evidence or any other material evidence you considered and whether the monument was found or restored through acceptance of an obliterated evidence location.


I found a railroad spike at the corner. This spike had been used as the corner in previous surveys. I accepted the spike as the best available evidence of the original government corner position.

Describe or show any material discrepancy between the location of the restored corner and that of the corner previously restored or reestablished.

None known.

RECORD OF DURABLE WITNESS MONUMENTS


NO	DESCRIPTION	BEARING	DISTANCE
1	Top center of hydrant	-----	55.78
2	Center of manhole	-----	27.76
3	Existing 2" iron pipe, flush	-----	29.91
4	Center of manhole	-----	13.62
5	At the base of an ex. 1" pipe, up 7"	-----	54.06

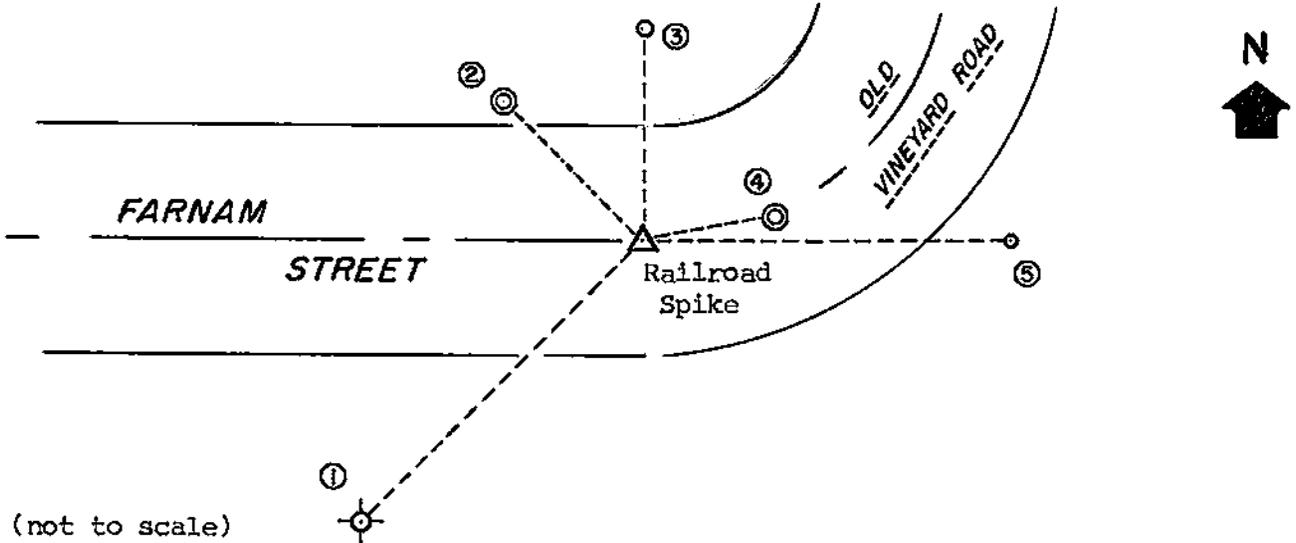

PLAN VIEW DRAWING OF REFERENCE TIES

MAP SHOWING DISTANCE AND DIRECTION TO OTHER PUBLIC LAND SURVEY CORNERS USED FOR REESTABLISHING THE CORNER

(not to scale)

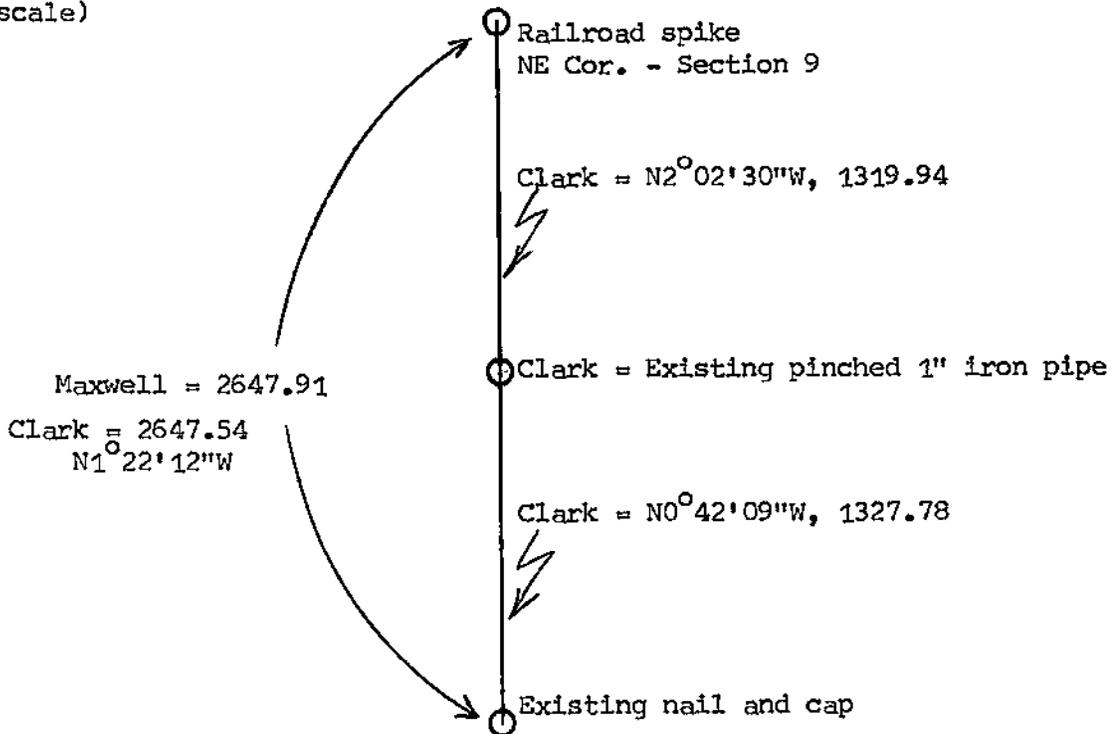

I, William C. Jung, Deputy County Surveyor,
 HEREBY CERTIFY THAT THE CORNER LOCATION SHOWN ON THIS RECORD
 WAS DETERMINED BY ME OR UNDER MY DIRECTION AND CONTROL AND
 THAT THIS U. S. PUBLIC LAND SURVEY MONUMENT RECORD IS CORRECT
 AND COMPLETE TO THE BEST OF MY KNOWLEDGE AND BELIEF.


William C. Jung December 4, 1991
 Signature Date



Seal

Tie Sheet, City of La Crosse

Section 9 Township 15 N Range 7 W

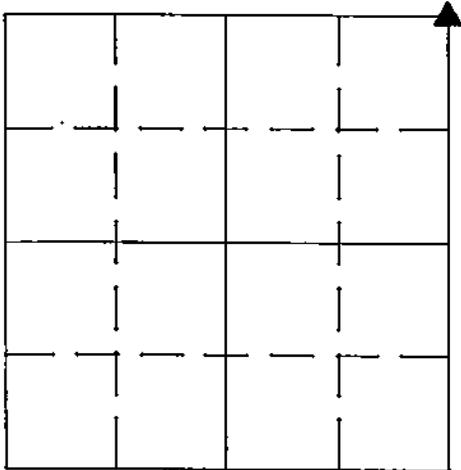


Project Section Corner
 Sta No _____
 Monument _____
 Coord. System _____
 North _____
 East _____
 Elev _____
 Surveyor County

Comments:

Date _____

Space for copy of field notes or ties to above described monument:

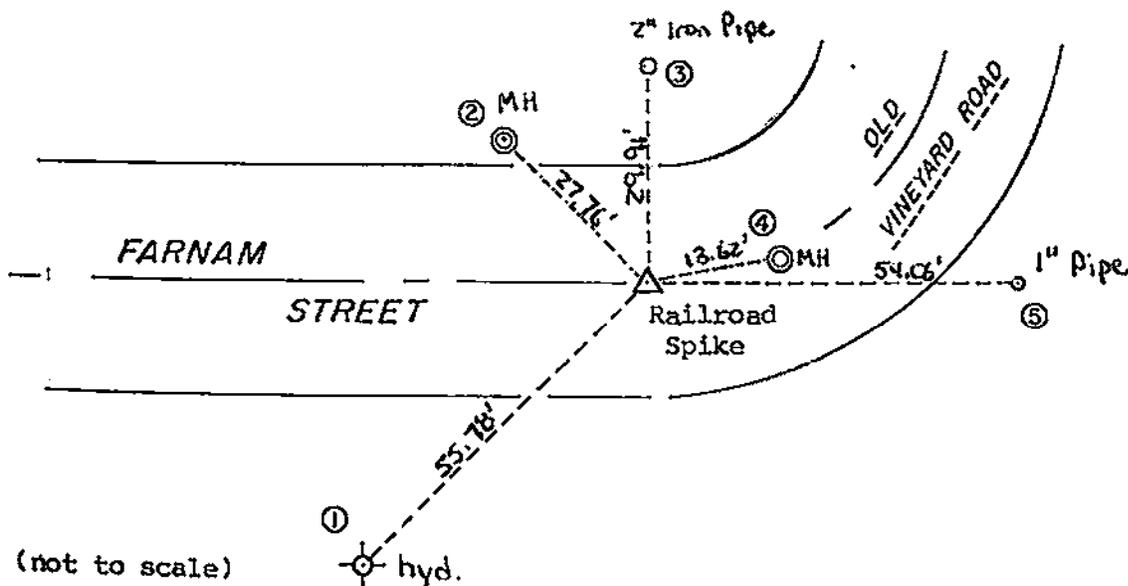

(not to scale)

PLAN VIEW DRAWING OF REFERENCE TIES

MAP SHOWING DISTANCE AND DIRECTION TO OTHER PUBLIC LAND SURVEY CORNERS USED FOR REESTABLISHING THE CORNER