


21507040020

U. S. PUBLIC LAND SURVEY MONUMENT RECORD

SECTION 9 T 15 N, R 7 W, ~~TOWN OF~~ CITY OF LACROSSE  
 LA CROSSE COUNTY

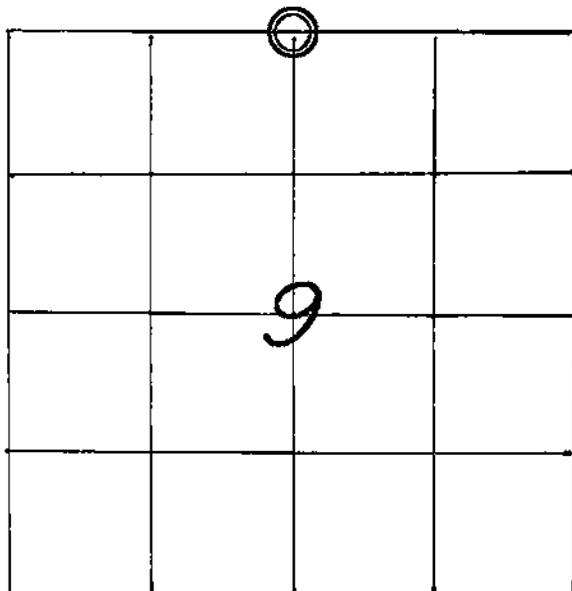

WISCONSIN COORDINATE SYSTEM	
North	657,658.538
East	1,646,459.574
Theta Angle	
Horiz. Order	
Vert. Order	
DATUM:	1983('91)
TYPE OF LANDMARK	
DRILL HOLE IN CONCRETE.	
BEARINGS ARE REFERENCED TO	
GRID NORTH AS PER SECTION DATA.	

LOCATION OF LANDMARK

CREW: WILLIAM C. JUNG  
 PETER F. FOLLANSBEE  
 DATE: 10/03/2001

Describe any record evidence, monument evidence, testimonial evidence or any other material evidence you considered and whether the monument was found or restored through acceptance of an obliterated evidence location.

I found and accepted the drill hole of record at the 1/4 corner. Further check measurements verified the location of this corner.

Describe or show any material discrepancy between the location of the restored corner and that of the corner previously restored or reestablished.

NONE KNOWN.

