


21507042000

U. S. PUBLIC LAND SURVEY MONUMENT RECORD

SECTION 4 T 15 N, R 7 W, TOWN OF SHELBY

LA CROSSE COUNTY

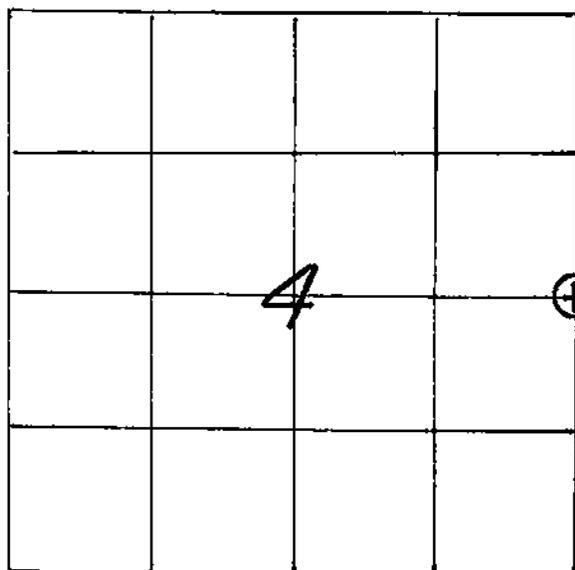

WISCONSIN COORDINATE SYSTEM

North

East

Theta Angle

Horiz. Order

Vert. Order

TYPE OF LANDMARK

3/4" x 30" IRON BAR WITH ALUMINUM CAP.

BEARINGS ARE REFERENCED TO

ASSUMED NORTH AS PER SECTION DATA.

LOCATION OF LANDMARK

CREW: *WILLIAM C. JUNG*
PETER F. FOLLANSBEE
 DATE: *10/02/2001*

Describe any record evidence, monument evidence, testimonial evidence or any other material evidence you considered and whether the monument was found or restored through acceptance of an obliterated evidence location.


A number of filed surveys show an iron pipe at this corner. One of them is dated April of 1947. As this pipe has ^{been} accepted and used as the 1/4 corner in many past surveys, I accepted this location as the best available evidence of the original government survey position. I set an iron bar with a cap inside of the existing pipe.

Describe or show any material discrepancy between the location of the restored corner and that of the corner previously restored or reestablished.

NONE KNOWN.


**RECORD OF DURABLE WITNESS MONUMENTS
MAGNETIC**

NO	DESCRIPTION	BEARING	DISTANCE
1	SET NAIL IN S.E.-SIDE OF A 14-1/2" NUT TREE	N 39° E	30.82 FT.
2	SET NAIL IN N.W.-SIDE OF A 11-1/2" ASPEN	N 60° E	43.56 FT.
3	SET NAIL IN S.-SIDE OF A 27" WHITE OAK	N 84° E	89.57 FT.
4	SET NAIL IN S.W.-SIDE OF A 7" CHERRY	S 34° E	26.10 FT.

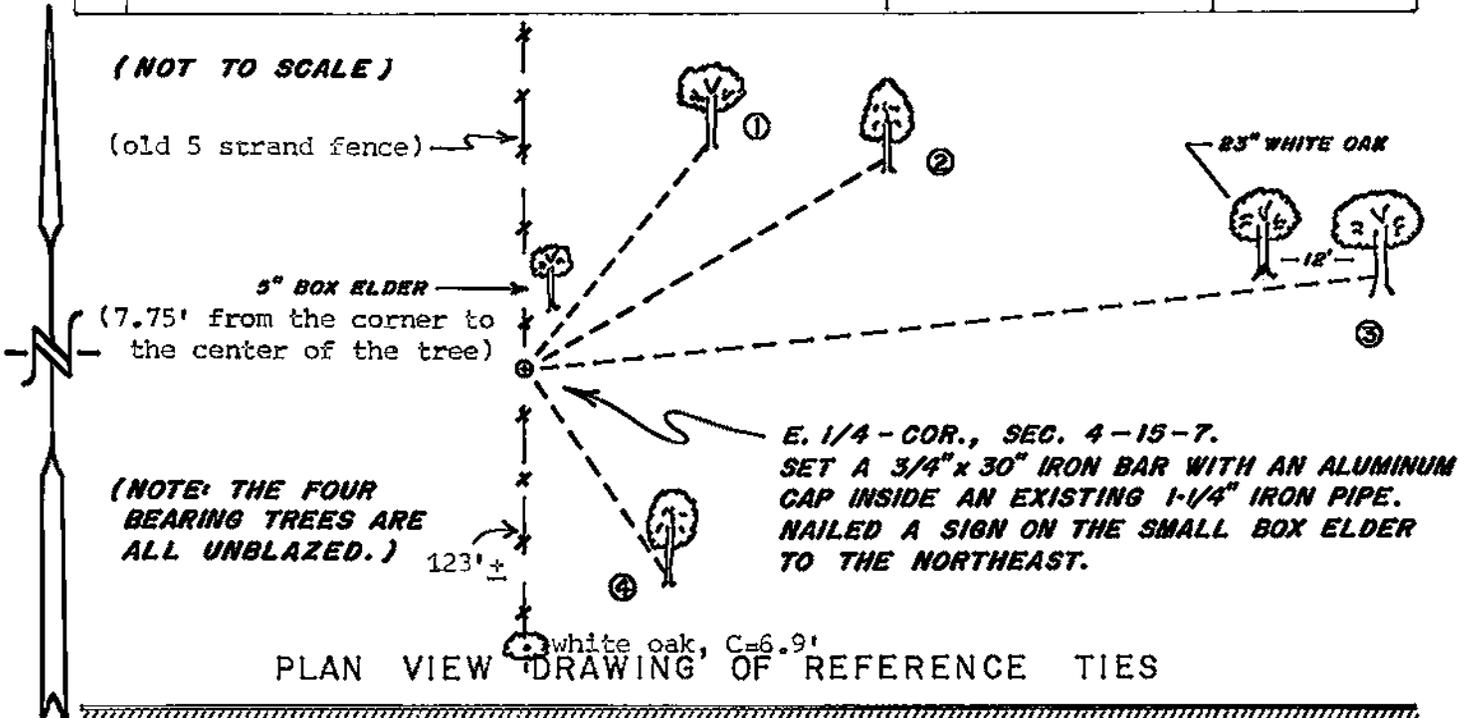


MAP SHOWING DISTANCE AND DIRECTION TO OTHER PUBLIC LAND SURVEY CORNERS USED FOR REESTABLISHING THE CORNER

(R. B. CONNELL MEASUREMENTS)
(ASSUMED NORTH)
(NOT TO SCALE)

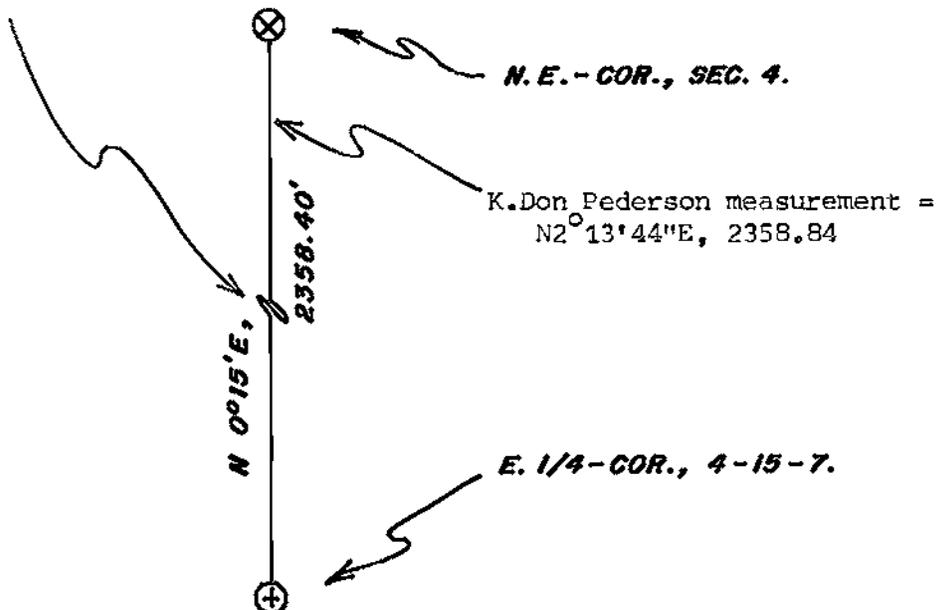

I, WILLIAM C. JUNG, COUNTY SURVEYOR
HEREBY CERTIFY THAT THE CORNER LOCATION SHOWN ON THIS RECORD WAS DETERMINED BY ME OR UNDER MY DIRECTION AND CONTROL AND THAT THIS U. S. PUBLIC LAND SURVEY MONUMENT RECORD IS CORRECT AND COMPLETE TO THE BEST OF MY KNOWLEDGE AND BELIEF.

William C. Jung 1/31/02
Signature Date

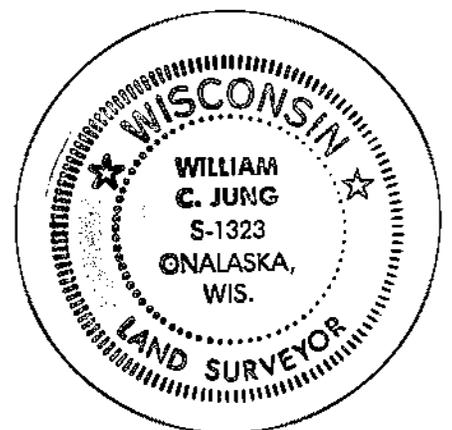

Seal