


21507050000

U. S. PUBLIC LAND SURVEY MONUMENT RECORD

SECTION 5 T 15 N, R 7 W, ~~TOWN OF~~ CITY OF LACROSSE
 LA CROSSE COUNTY

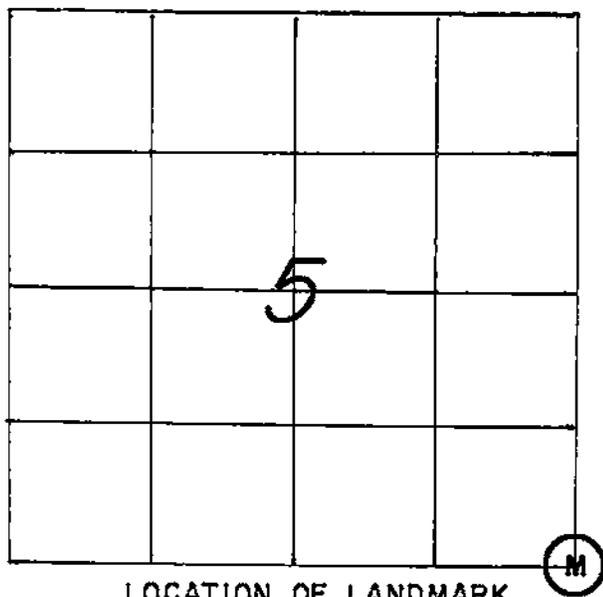

LOCATION OF LANDMARK

CREW: WILLIAM G. JUNG
 PETER F. FOLLANSBEE
 DATE: 10/22/2007

WISCONSIN COORDINATE SYSTEM

North 657,655.391

East 1,643,786.909

Theta Angle

Horiz. Order

Vert. Order

DATUM: 1983('91)

TYPE OF LANDMARK

CENTER OF MANHOLE

BEARINGS ARE REFERENCED TO
 GRID NORTH AS PER SECTION DATA.

Describe any record evidence, monument evidence, testimonial evidence or any other material evidence you considered and whether the monument was found or restored through acceptance of an obliterated evidence location.

In my research I found that all of the plats and surveys in the four surrounding quarter sections all started from this corner. They also agree on paper as to the location of this corner. There was a stone at this corner, but it was lost during street construction as there is a manhole at the corner now. I "pushed" the plats, existing monuments, evidence, etc. out to the corner and found that everything agrees that the section corner falls at the center of the manhole. This location fits very well.

Describe or show any material discrepancy between the location of the restored corner and that of the corner previously restored or reestablished.

NONE KNOWN.

