

U.S. PUBLIC LAND SURVEY MONUMENT RECORD

SECTION 8, T15N, R7W, CITY OF LA CROSSE
LA CROSSE COUNTY


CERTIFICATE

I, K. DON PEDERSON, DO HEREBY CERTIFY THAT ON THE 23RD DAY OF MAY, 2001, I FOUND NO EVIDENCE OF THE NORTH 1/4 CORNER OF SECTION 8, T15 N, R7 W, AND I REESTABLISHED SAID CORNER ACCORDING TO THE WISCONSIN STATUTES AS SHOWN AND DESCRIBED HEREON.

DATED THIS 5TH DAY OF JULY 2001



K. Don Pederson

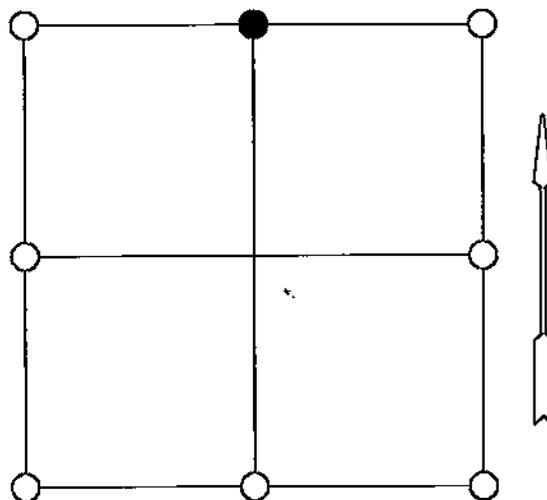

● = CORNER LOCATION
SECTION 8, T15N, R7W

HISTORY OF ORIGINAL CORNER ESTABLISHMENT:

ORIGINAL CORNER ESTABLISHED BY ALFRED L. BROWN IN NOVEMBER OF 1846

DESCRIPTION OF CORNER EVIDENCE FOUND:

INTERSECTED THE CENTERLINES OF STREETS USING EXISTING MONUMENTS AND BEST EVIDENCE AVAILABLE IN ADJACENT PLATS.

DESCRIPTION OF CORNER AND WITNESS MONUMENTS, REFERENCES AND ACCESSORIES USED TO PERPETUATE THE ORIGINAL OR REESTABLISHED LOCATION OF THIS CORNER:


WITNESSES TO CORNER LOCATION:

K. DON PEDERSON

PAUL CHAFER

- T-1 50.66' N61°24'17"E
- T-2 48.27' S61°14'19"E
- T-3 47.26' S60°16'54"W
- T-4 45.73' N63°42'31"W

SKETCH:

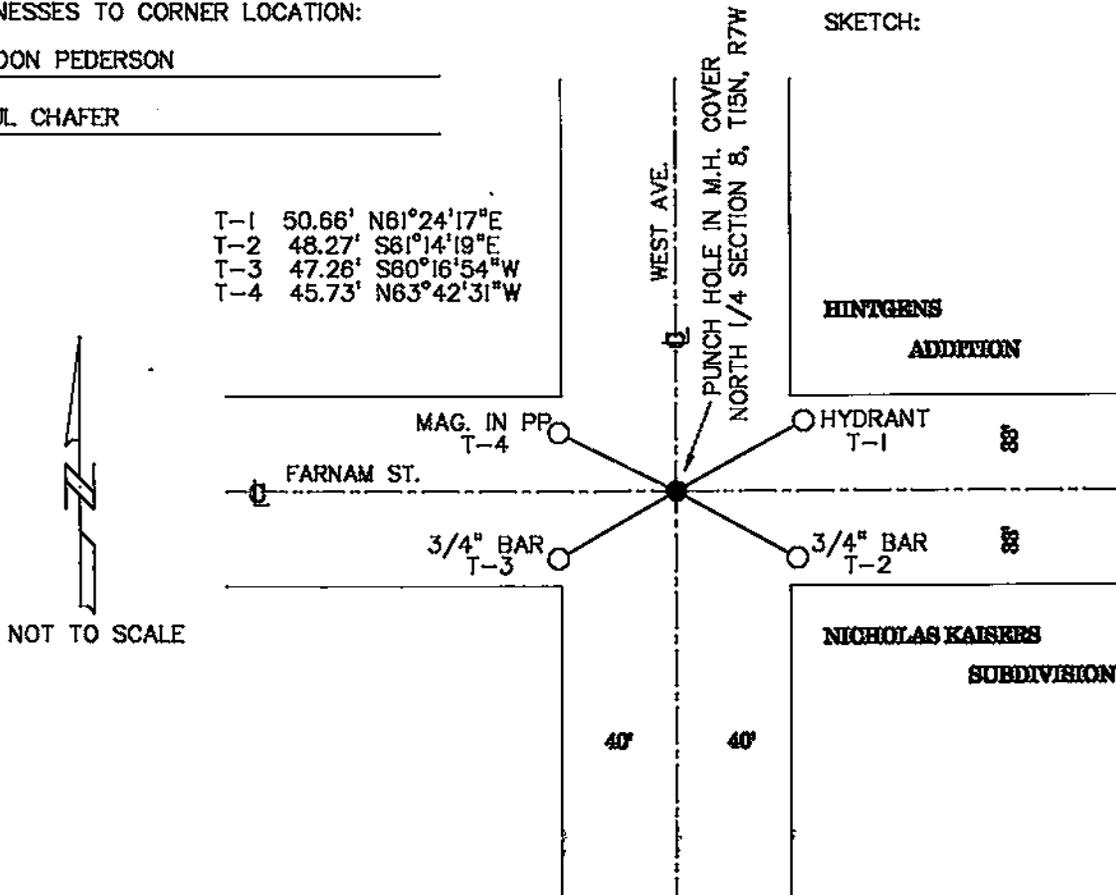

NOT TO SCALE