


21507052000

U. S. PUBLIC LAND SURVEY MONUMENT RECORD

SECTION 5 T 15 N, R 7 W, ~~TOWN OF~~ CITY OF LACROSSE

LA CROSSE COUNTY

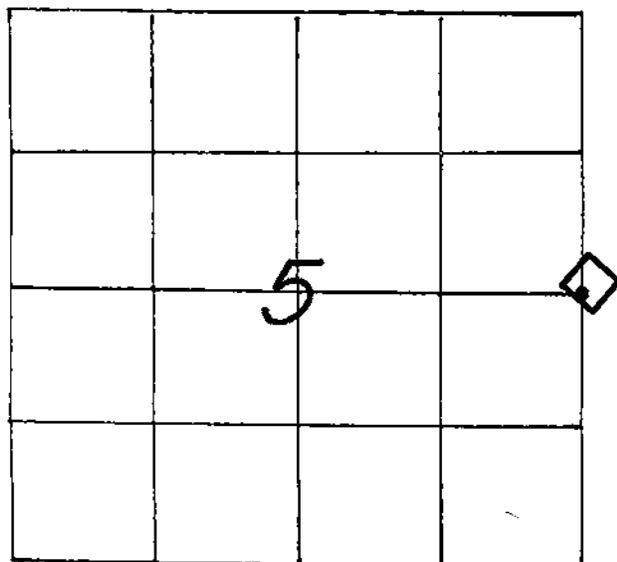

LOCATION OF LANDMARK

CREW: WILLIAM G. JUNG
 PETER F. FOLLANSBEE
 DATE: 11/02/2005

WISCONSIN COORDINATE SYSTEM	
North	660,291.550
East	1,643,968.577
Theta Angle	
Horiz. Order	
Vert. Order	
DATUM:	1983('91)
TYPE OF LANDMARK	
COPPER POINT IN CONCRETE BLOCK.	
BEARINGS ARE REFERENCED TO	
GRID NORTH AS PER SECTION DATA.	

Describe any record evidence, monument evidence, testimonial evidence or any other material evidence you considered and whether the monument was found or restored through acceptance of an obliterated evidence location.


At the corner we found a copper point in a 4"x4½" concrete block marker. This marker was on record at the City of LaCrosse Engineering Department. Dave Karl from that department pointed out the location to us. The marker also is on record with surveys done by Kraft, Clark, and Pederson. We tied off this existing marker.

Describe or show any material discrepancy between the location of the restored corner and that of the corner previously restored or reestablished.


NONE KNOWN.

RECORD OF DURABLE WITNESS MONUMENTS

NO	DESCRIPTION	BEARING	DISTANCE
1	CENTER OF CORNER PIPE FOR CHAIN-LINK FENCE	S.' WESTERLY ±	47.71 FT.
2	SET A NAIL IN CONCRETE JOINT IN ALLEY CENTERLINE	WESTERLY ±	59.16 FT.
3	SET A NAIL IN CONCRETE JOINT IN ALLEY CENTERLINE	S.' EASTERLY ±	23.85 FT.
4	2 1/4" SAWED OFF FENCE PIPE AT S.W.-COR. INTERSECTION	S.' WESTERLY ±	204.08 FT.

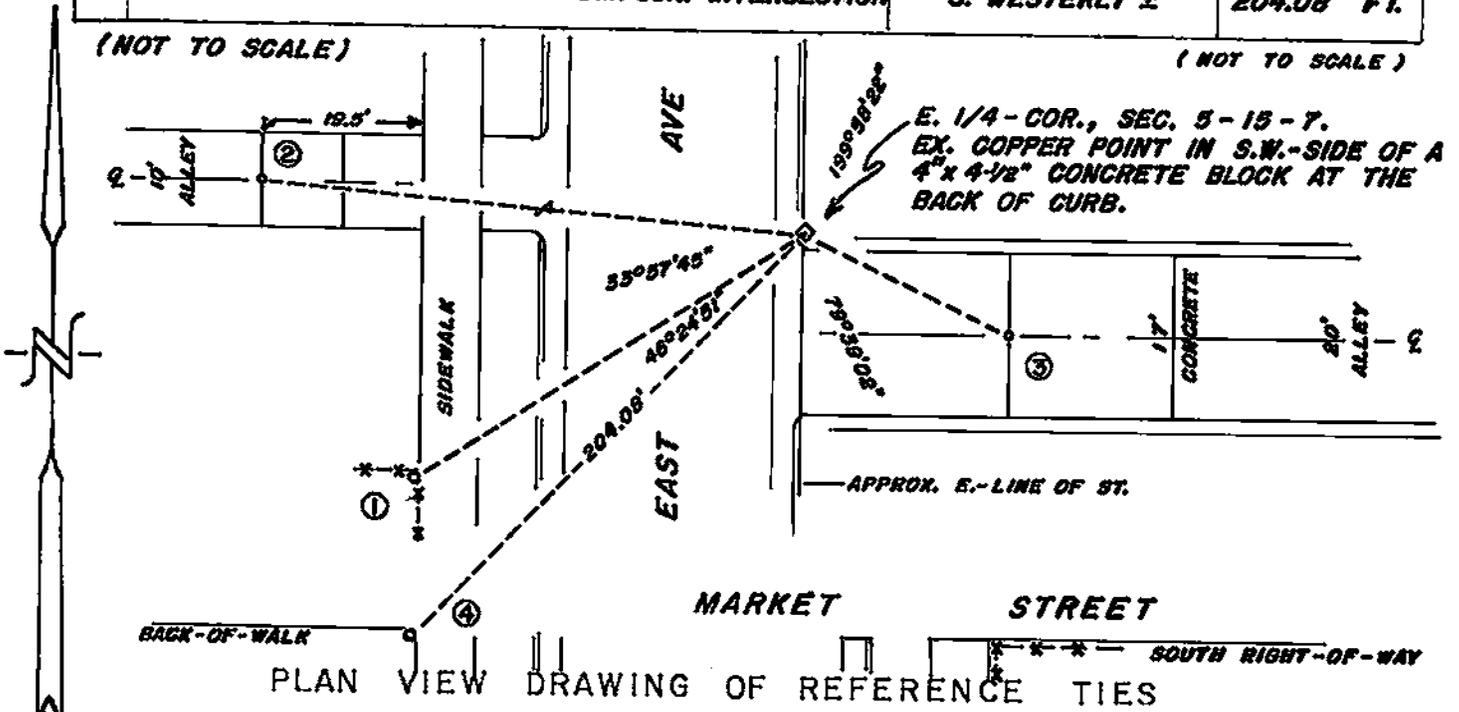


MAP SHOWING DISTANCE AND DIRECTION TO OTHER PUBLIC LAND SURVEY CORNERS USED FOR REESTABLISHING THE CORNER

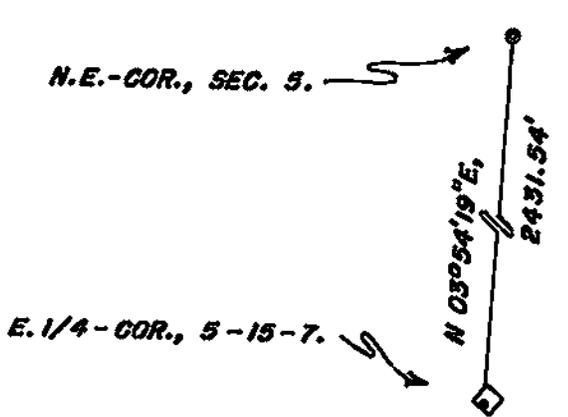

(GRID BEARINGS AND DISTANCES)
 (GRID FACTOR: 0.9999267)
 (NOT TO SCALE)

I, WILLIAM C. JUNG, COUNTY SURVEYOR
 HEREBY CERTIFY THAT THE CORNER LOCATION SHOWN ON THIS RECORD
 WAS DETERMINED BY ME OR UNDER MY DIRECTION AND CONTROL AND
 THAT THIS U. S. PUBLIC LAND SURVEY MONUMENT RECORD IS CORRECT
 AND COMPLETE TO THE BEST OF MY KNOWLEDGE AND BELIEF.

William C. Jung 1/16/06
 Signature Date

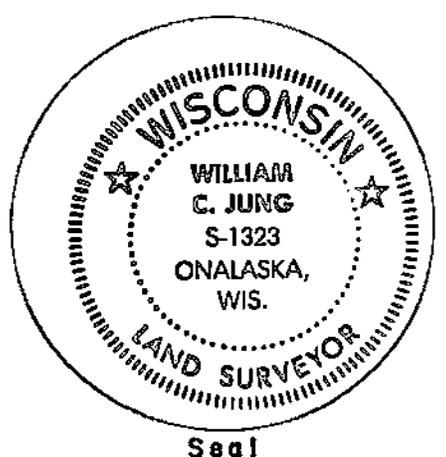

Seal