

U. S. PUBLIC LAND SURVEY MONUMENT RECORD

SECTION 5, TOWNSHIP 15 NORTH, RANGE 7 WEST

CITY of LA CROSSE
LA CROSSE COUNTY, WISCONSIN

5

COORDINATE SYSTEM	
NORTHING	657,743.21
EASTING	1,638,492.17
THETA ANGLE	
HORIZ. ORDER	
VERT. ORDER	
BEARINGS ARE REFERENCED TO: Wisconsin South Zone	
TYPE OF MONUMENT 3/4" x 30" Iron bar	

Describe any record evidence, monument evidence, testimonial evidence or any other material evidence you considered and whether the monument was found or restored through acceptance of an obliterated evidence location.

Due to upcoming street reconstruction, I tied out this corner (PK) as set by Maxwell (89) and accepted by Jung (96). Upon completion of street project, I reset this corner location using a 3/4" iron rebar.

Describe or show any material discrepancy between the location of the restored corner and that of the corner previously restored or reestablished.


After the old street surface was removed, I found the original stone. The stone was disturbed (lying diagonally & 2' north of tie location). Jung, Follansbee, and I searched for additional evidence but found nothing conclusive. Stone was removed from site and the corner was remonumented in the location previously set and tied by Maxwell (89).

October 12, 1998
David Karl, RLS




REFERENCE TIES

#	DESCRIPTION	BEARING	DISTANCE
1	Center of sanitary manhole @ intersection	W	77.84'
2	Center of water valve manhole cover	NW	47.04'
3	Found nail @ back of sidewalks	NW	56.91'
4	Center of water valve cover	SE	39.47'

PLAN VIEW OF REFERENCE TIES

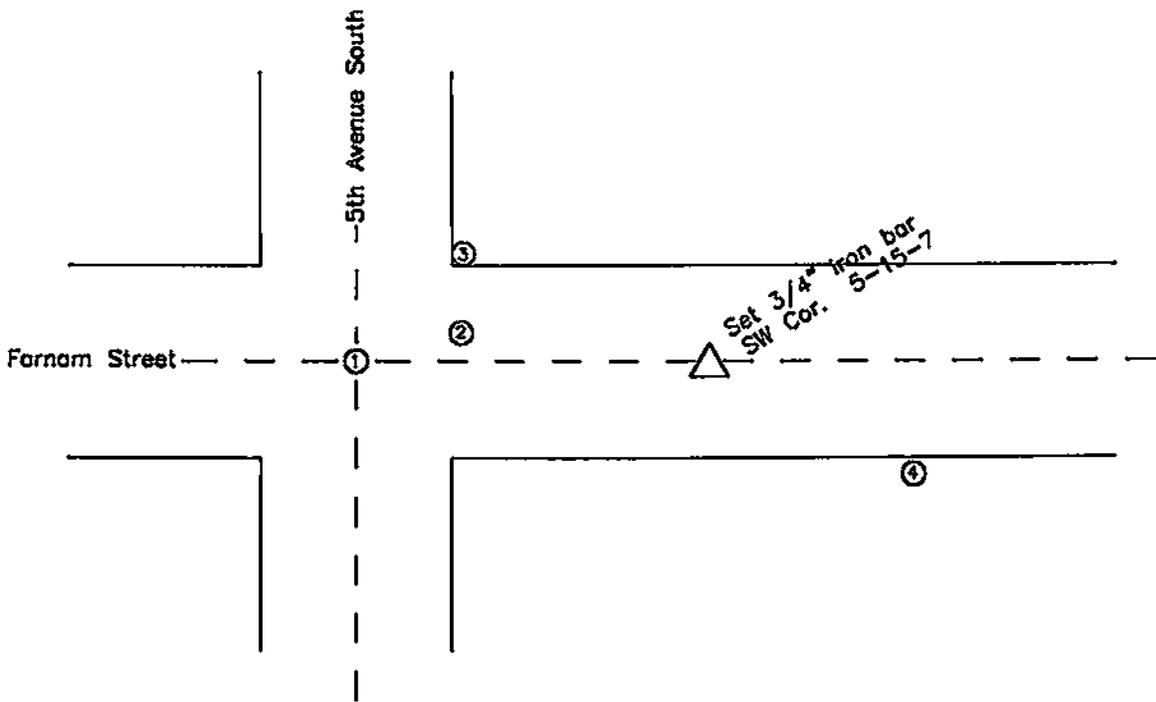

DISTANCE AND DIRECTION TO OTHER P.L.S.S. CORNERS USED

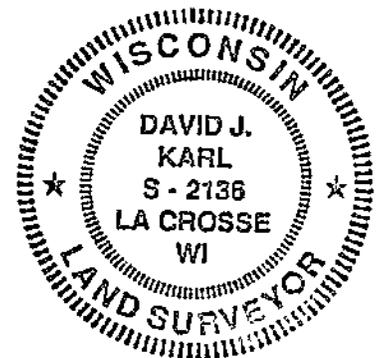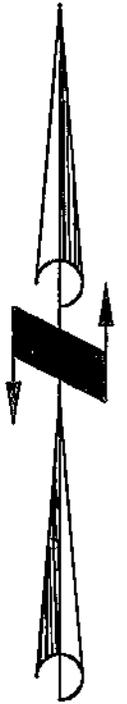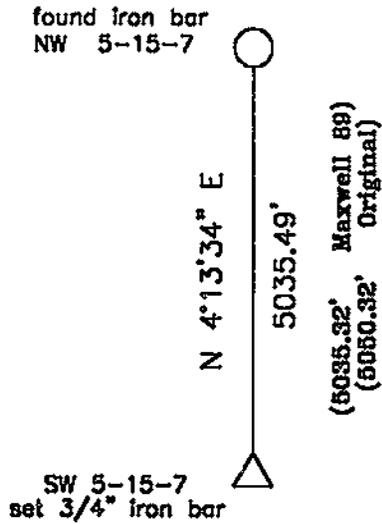


I, DAVID J. KARL, WISCONSIN REGISTERED LAND SURVEYOR #2136 CERTIFY THAT THE CORNER LOCATION SHOWN ON THIS RECORD WAS RESET OR DETERMINED BY ME OR UNDER MY DIRECTION AND CONTROL. I FURTHER CERTIFY THAT THIS DOCUMENT IS CORRECT AND COMPLETE TO THE BEST OF MY KNOWLEDGE.

1-26-99

David J. Karl

U. S. PUBLIC LAND SURVEY MONUMENT RECORD

SECTION 5 T 15 N, R 7 W, TOWN OF CITY OF LA CROSSE
 LA CROSSE COUNTY

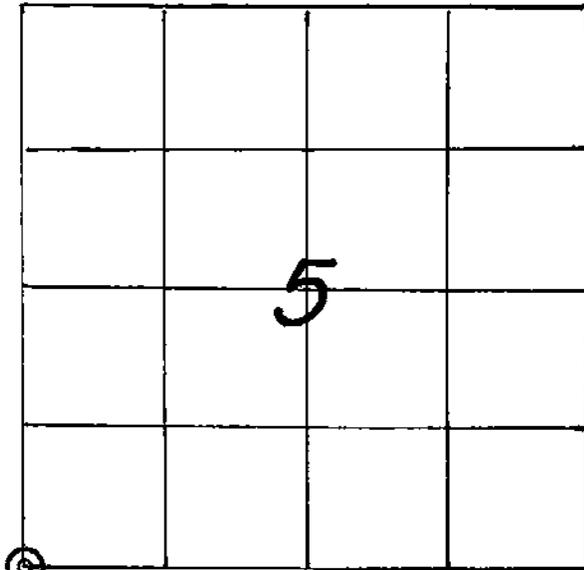

LOCATION OF LANDMARK

Crew: WILLIAM C. JUNG
 PETER F. FOLLANSBEE
 Date: 4/16/1996

WISCONSIN COORDINATE SYSTEM
North
East
Theta Angle
Horiz. Order
Vert. Order
TYPE OF LANDMARK
Existing P.K. Nail
BEARINGS ARE REFERENCED TO



Describe any record evidence, monument evidence, testimonial evidence or any other material evidence you considered and whether the monument was found or restored through acceptance of an obliterated evidence location.

Rodney Maxwell set a P.K. nail at this corner in 1989. My research and field survey work in the immediate corner area confirms in my opinion the location of Maxwell's corner. I therefore accepted this P.K. nail as the best evidence of the original section corner position.

Describe or show any material discrepancy between the location of the restored corner and that of the corner previously restored or reestablished.

None known.

DETAIL SHEET - SW-COR., SEC. 5-15-7.

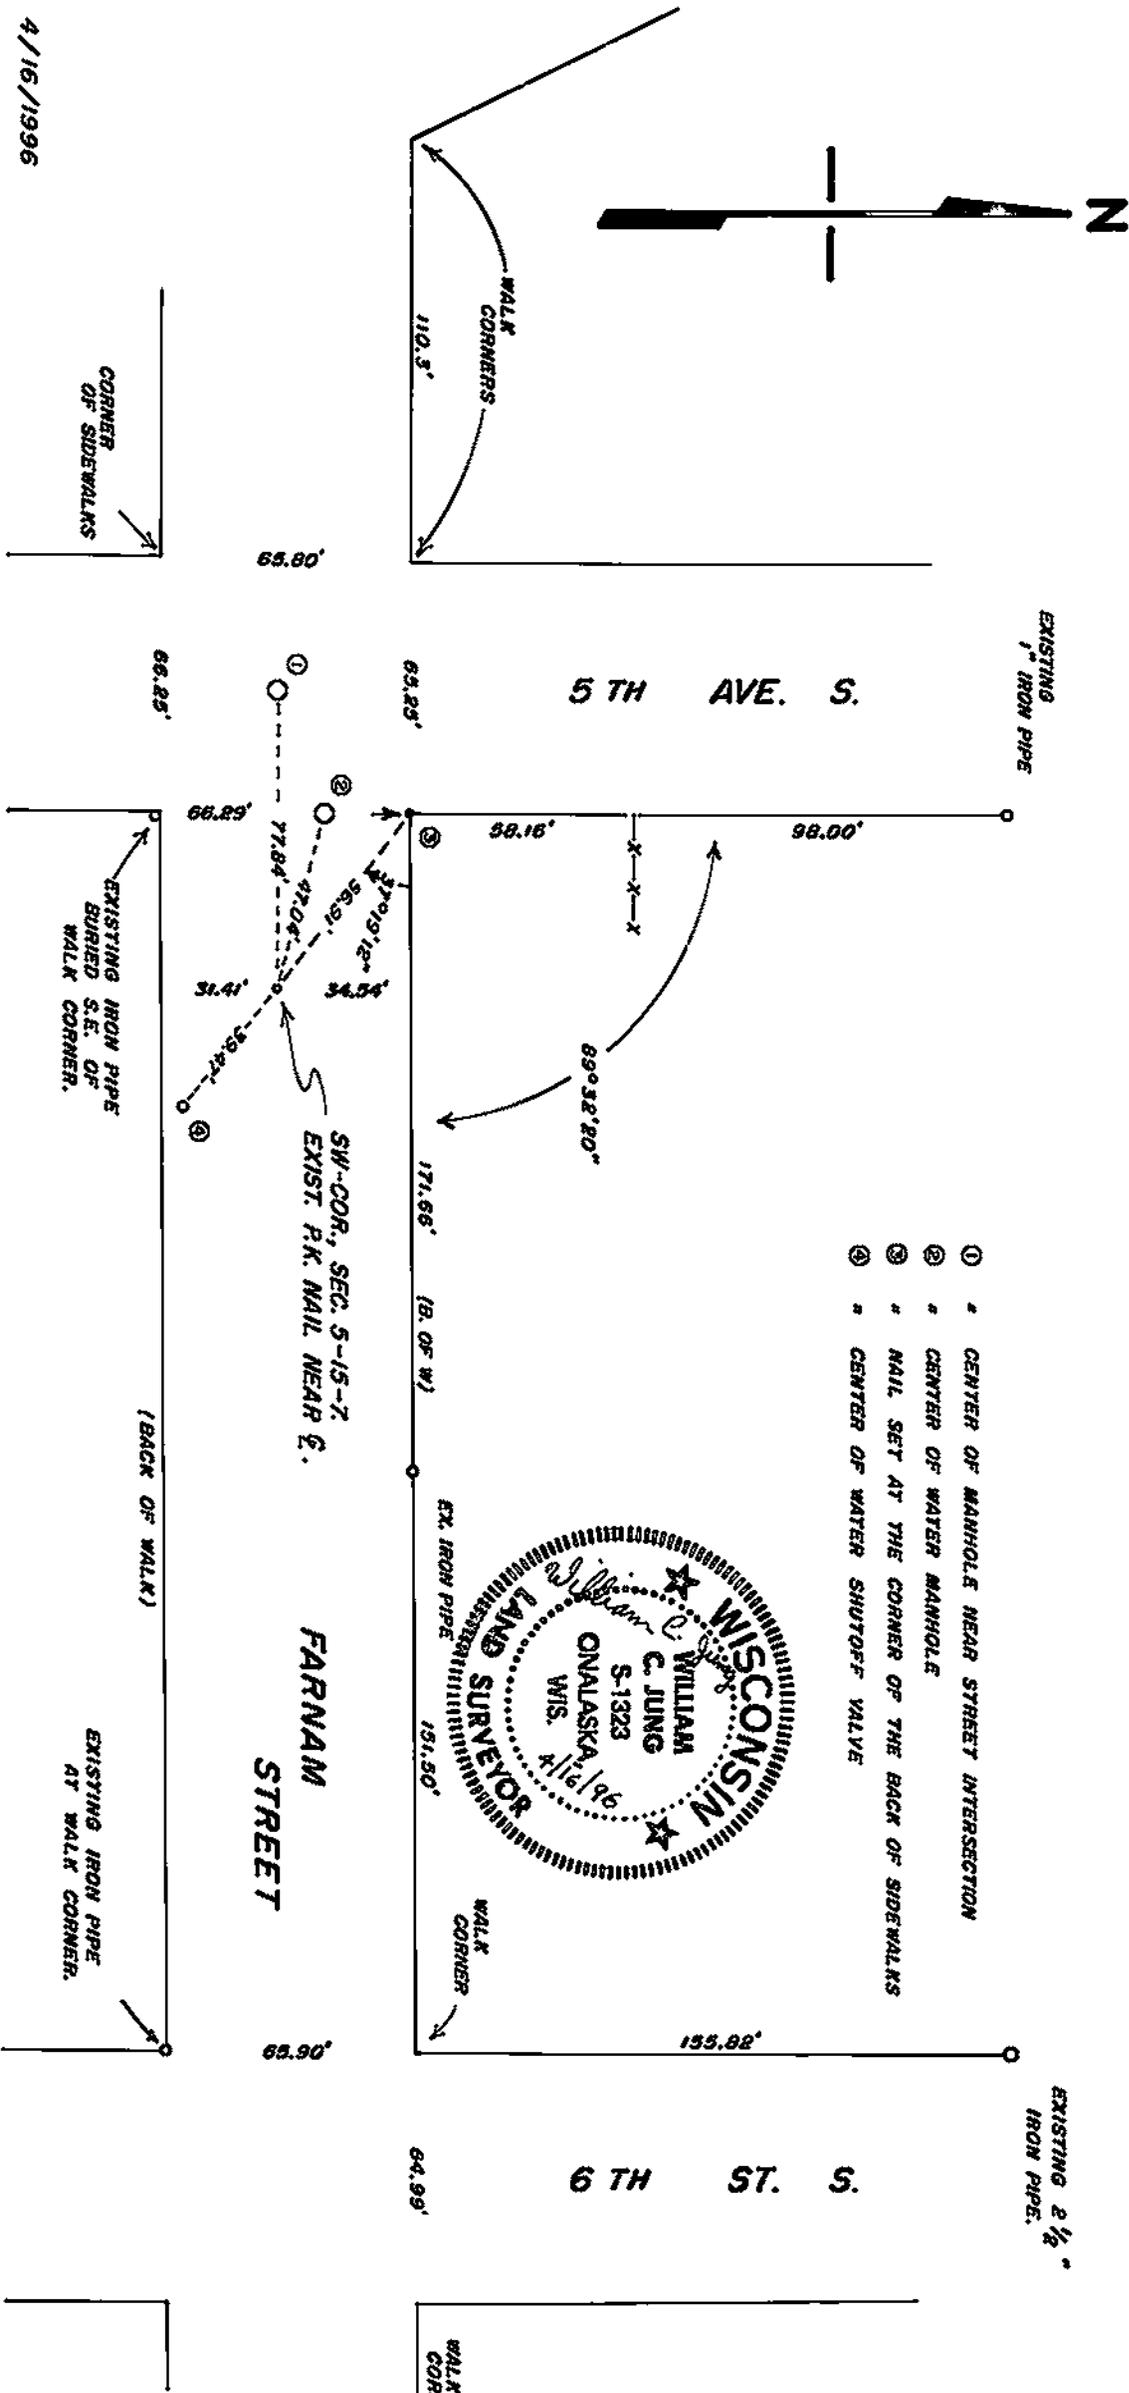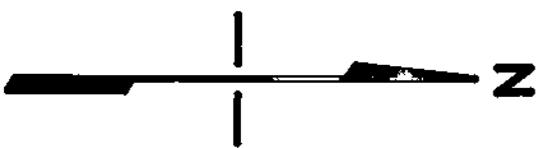

- ① * CENTER OF MANHOLE NEAR STREET INTERSECTION
- ② * CENTER OF WATER MANHOLE
- ③ * NAIL SET AT THE CORNER OF THE BACK OF SIDEWALKS
- ④ * CENTER OF WATER SHUTOFF VALVE

4/16/1996
 SCALE: 1" = 50'
 WILLIAM C. JUNG, COUNTY SURVEYOR

DRAWN BY: R.F. FOLLANSBEE, COUNTY SURVEYOR'S OFFICE