


21507062000

U. S. PUBLIC LAND SURVEY MONUMENT RECORD

SECTION 5 T 15 N, R 7 W, ~~TOWN OF~~ CITY OF LACROSSE

LA CROSSE COUNTY

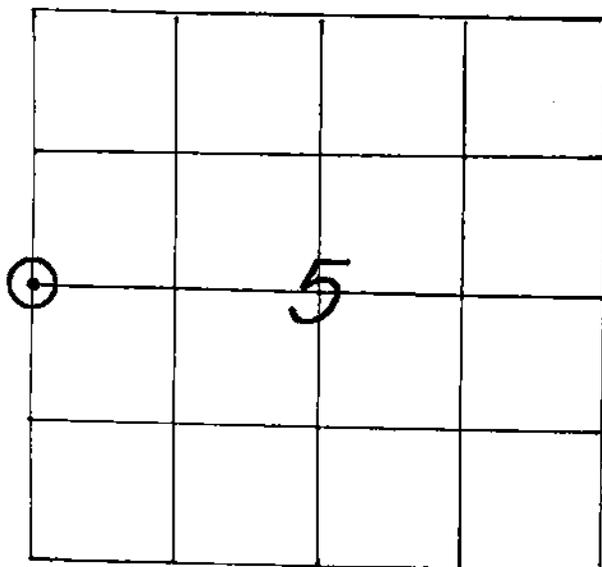

LOCATION OF LANDMARK

CREW: WILLIAM C. JUNG
 PETER F. FOLLANSBEE
 DATE: 4/10/2006

WISCONSIN COORDINATE SYSTEM	
North	660,394.996
East	1,638,685.678
Theta Angle	
Horiz. Order	
Vert. Order	
DATUM:	1983('91)
TYPE OF LANDMARK	
P.K. NAIL IN CONCRETE JOINT.	
BEARINGS ARE REFERENCED TO	
GRID NORTH AS PER SECTION DATA.	

Describe any record evidence, monument evidence, testimonial evidence or any other material evidence you considered and whether the monument was found or restored through acceptance of an obliterated evidence location.

To put this corner back in took a great deal of effort. The corner falls in an alley where it has long since disappeared. In our preliminary survey work, we not only surveyed out the block that the corner falls in, but also measured North to the North line of Division Street, East to the East side of 6th St., West to the alley west of the fire station, and South to the North line of Winnebago St. After reconstructing the original plats I found that the blocks and lots all measured long. Based on the evidence that *****

Describe or show any material discrepancy between the location of the restored corner and that of the corner previously restored or reestablished.

NONE KNOWN.


***** I found during the course of measuring up all these blocks, I set the 1/4 corner in the centerline of the alley at the location as shown on the old plats. This best fits the block and street measurements and the greater amount of occupation. The half miles North and South also fit very well for line and distance. We set a PK nail at the corner and also reset the block corners in this block. This survey involved a lot of work. I am convinced that this corner location marks the original corner location based on the evidence that Pete and I found.

RECORD OF DURABLE WITNESS MONUMENTS

(GROUND DIST.'s)


NO	DESCRIPTION	BEARING	DISTANCE
1	SET A P.K. NAIL IN ϵ AT NORTH END OF ALLEY	N 04°06'37"E (GRID)	183.33 FT.
2	SET A P.K. NAIL IN CONCRETE AT BLOCK LINE	S 89°06'08"E (GRID)	134.05 FT.
3	SET A P.K. NAIL IN ϵ AT SOUTH END OF ALLEY	S 04°05'07"W (GRID)	141.14 FT.
4	EX. 2" IRON PIPE 1.2 FT. WEST OF EDGE OF CONCRETE	S. WESTERLY \pm	21.32 FT.

(NOT TO SCALE)

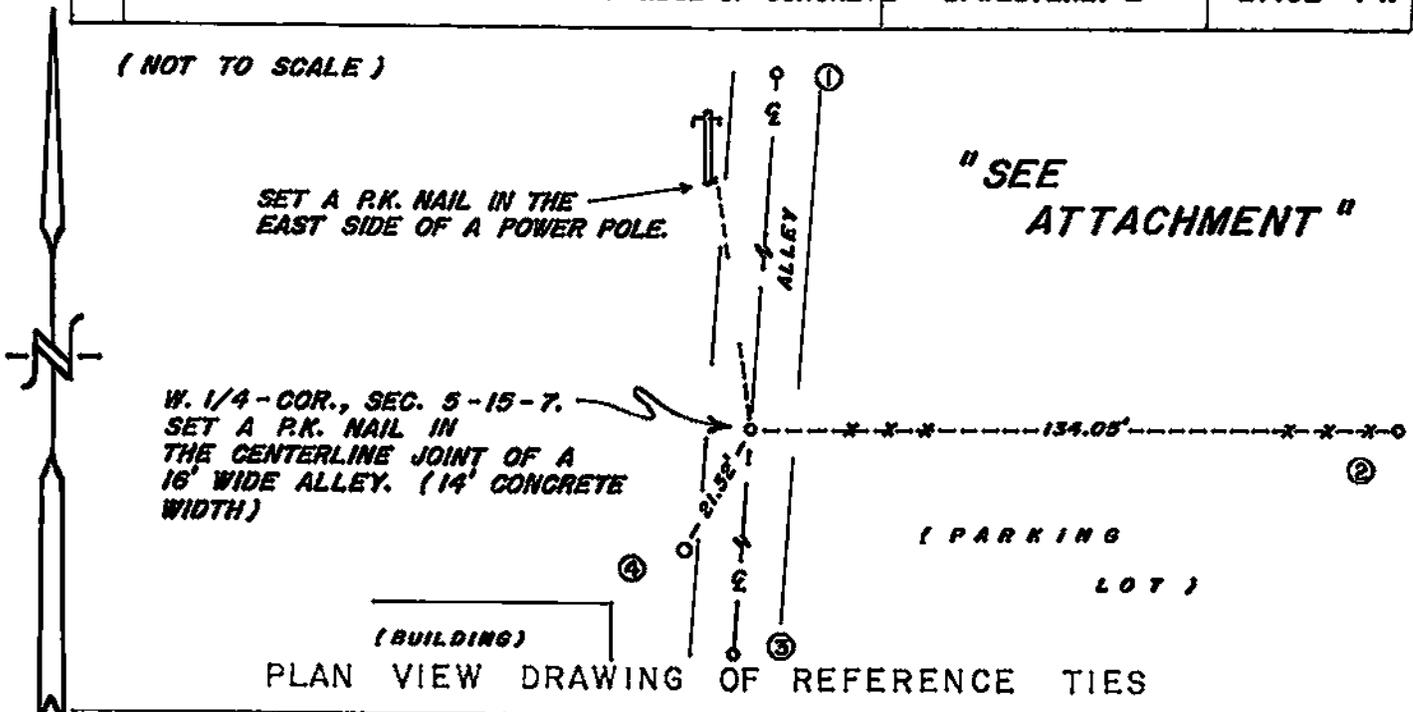

MAP SHOWING DISTANCE AND DIRECTION TO OTHER PUBLIC LAND SURVEY CORNERS USED FOR REESTABLISHING THE CORNER

(GRID BEARINGS AND DISTANCES)
(GRID FACTOR: 0.9999267)
(NOT TO SCALE)

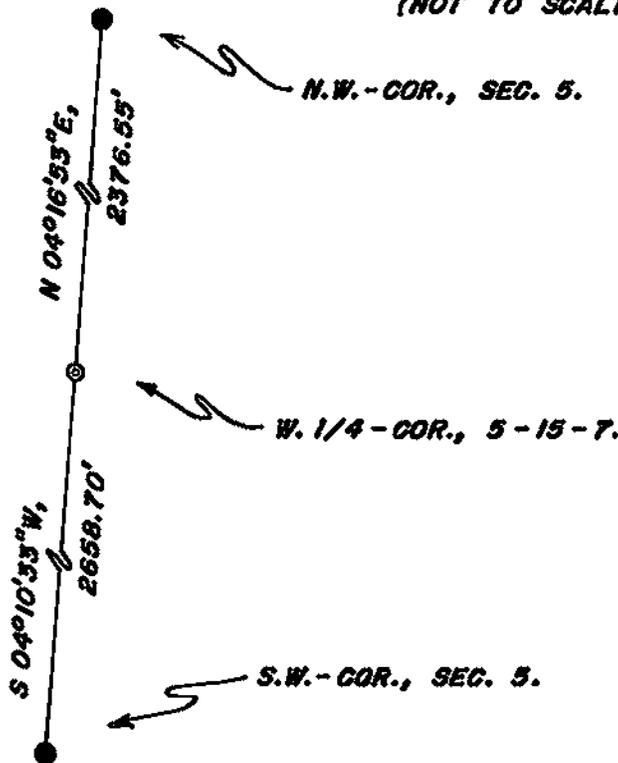



I, WILLIAM C. JUNG, COUNTY SURVEYOR
HEREBY CERTIFY THAT THE CORNER LOCATION SHOWN ON THIS RECORD WAS DETERMINED BY ME OR UNDER MY DIRECTION AND CONTROL AND THAT THIS U. S. PUBLIC LAND SURVEY MONUMENT RECORD IS CORRECT AND COMPLETE TO THE BEST OF MY KNOWLEDGE AND BELIEF.

William C. Jung 5/31/06
Signature Date



Seal

" ATTACHMENT "
FOR THE
W. 1/4-COR., SEC. 5-15-7.

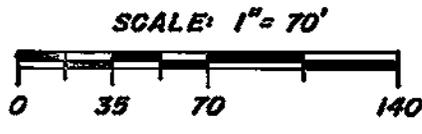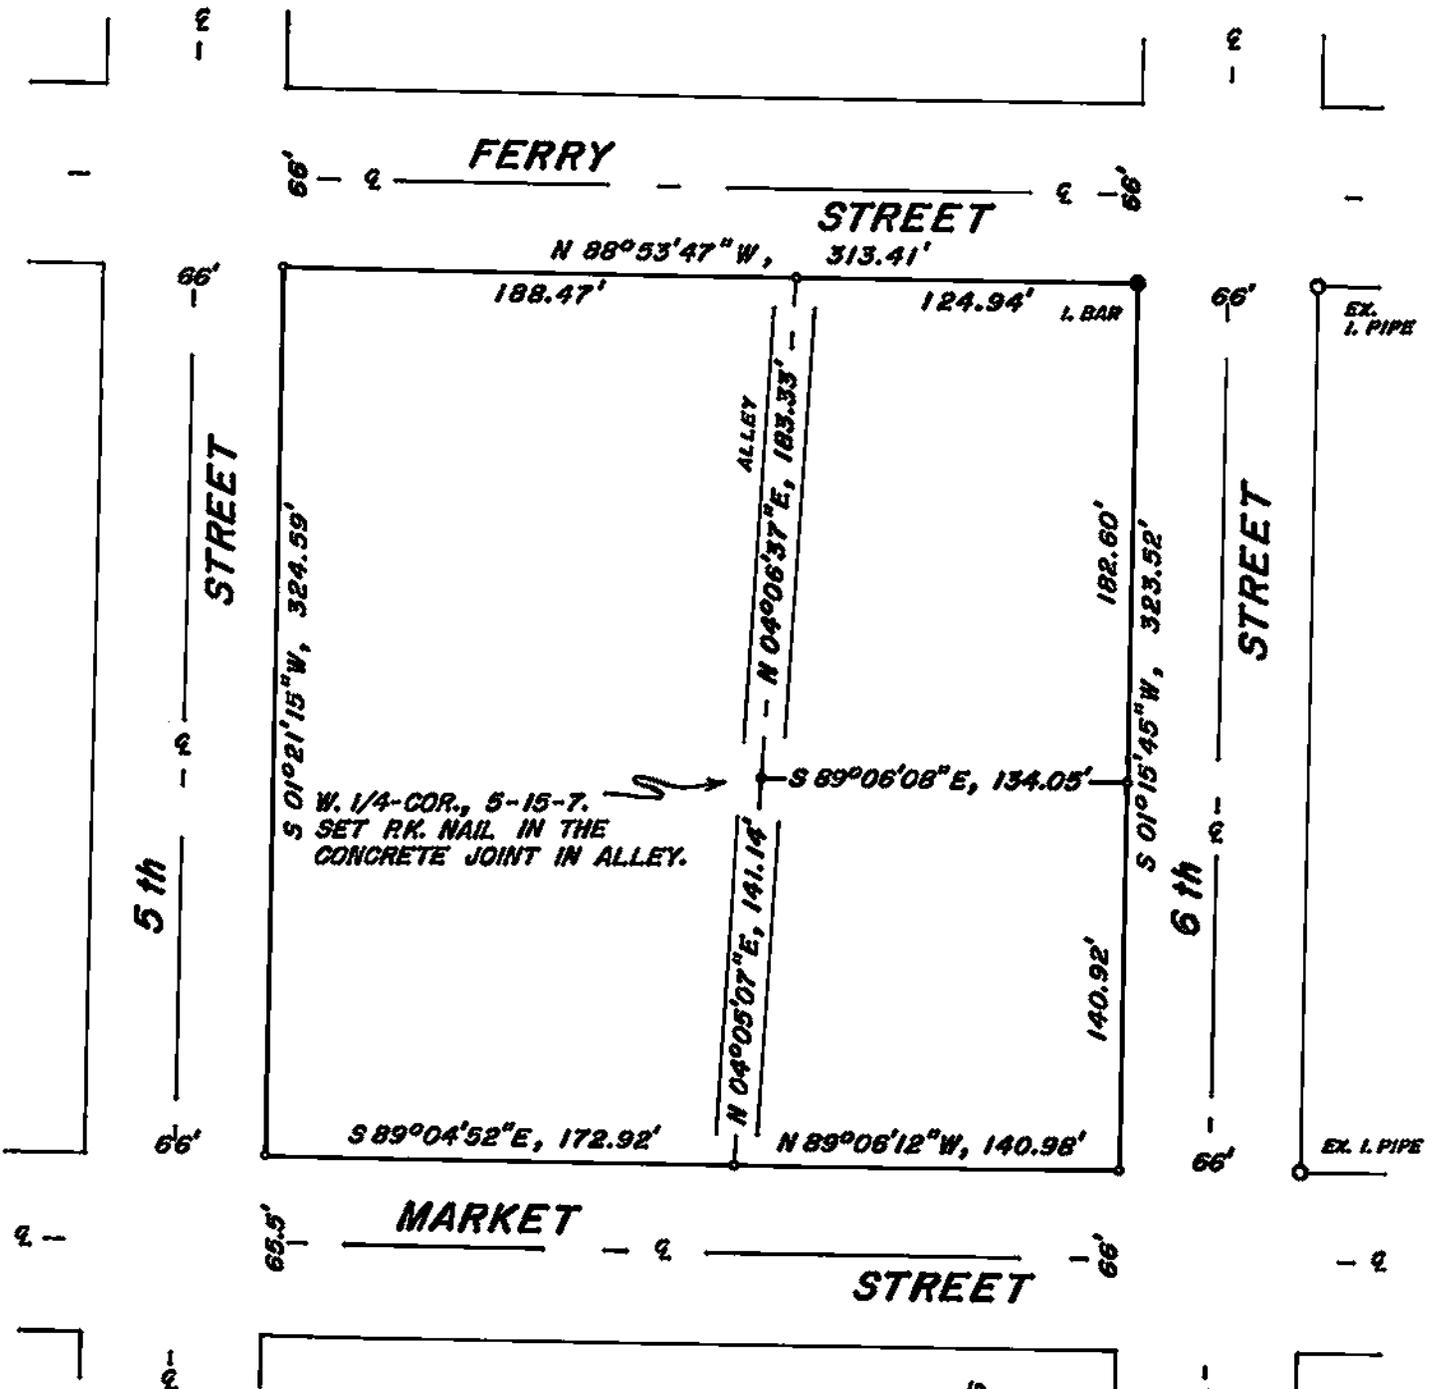

- LEGEND**
- = SET R.R. NAIL IN CONCRETE
 - = EXISTING IRON PIPE
 - = SET 3/4" x 30" I. BAR, 1.50 LBS/LIN. FT.

