


21507072000

U. S. PUBLIC LAND SURVEY MONUMENT RECORD

SECTION 8 T 15 N, R 7 W, ~~TOWN OF~~ CITY OF LACROSSE

LA CROSSE COUNTY

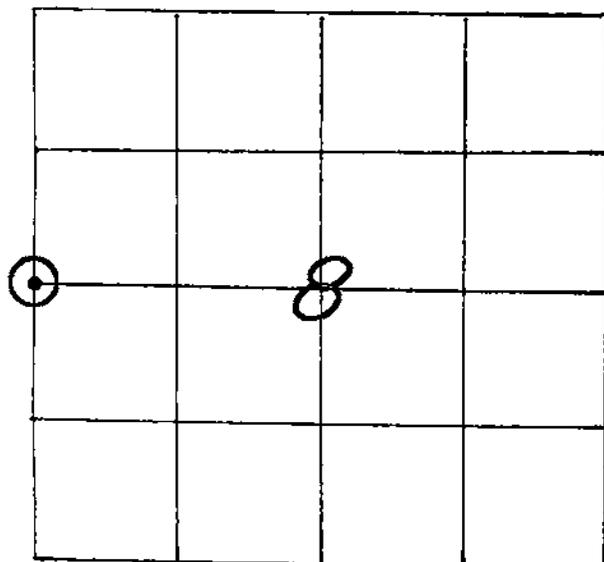

LOCATION OF LANDMARK

CREW: **WILLIAM G. JUNG**
PETER F. FOLLANSBEE
 DATE: **4/13/2006**

WISCONSIN COORDINATE SYSTEM	
North	655,092.896
East	1,638,510.626
Theta Angle	
Horiz. Order	
Vert. Order	
DATUM:	1983('91)
TYPE OF LANDMARK	
P.K. NAIL & CAP.	
BEARINGS ARE REFERENCED TO	
GRID NORTH AS PER SECTION DATA.	

Describe any record evidence, monument evidence, testimonial evidence or any other material evidence you considered and whether the monument was found or restored through acceptance of an obliterated evidence location.

On a CSM dated 7/4/83 Wil Clark shows an existing P.K. nail at this corner. After studying his survey and work file and other surveys of record, I agree with his conclusion that the existing P.K. nail was at the 1/4 corner location. The P.K. was later knocked out. We set a new P.K. nail and cap at Clark's location.


Describe or show any material discrepancy between the location of the restored corner and that of the corner previously restored or reestablished.

Some survey data of record would indicate that the corner should be 10.2 feet to the East. I do not agree with that conclusion.

RECORD OF DURABLE WITNESS MONUMENTS


NO.	DESCRIPTION	BEARING	DISTANCE
1	SET A DRILL HOLE IN TOP OF CONCRETE CURB	NORTHWEST ±	32.90 FT.
2	SET A DRILL HOLE IN TOP OF CONCRETE CURB	NORTH ±	20.45 FT.
3	CENTER OF AN EXISTING MANHOLE IN E. 7th ST.	EAST ±	63.21 FT.
4	EX. 2" IRON PIPE BURIED ON THE RIGHT-OF-WAY	S 00°31'58"E (GRID)	33.00 FT.

(NOT TO SCALE)

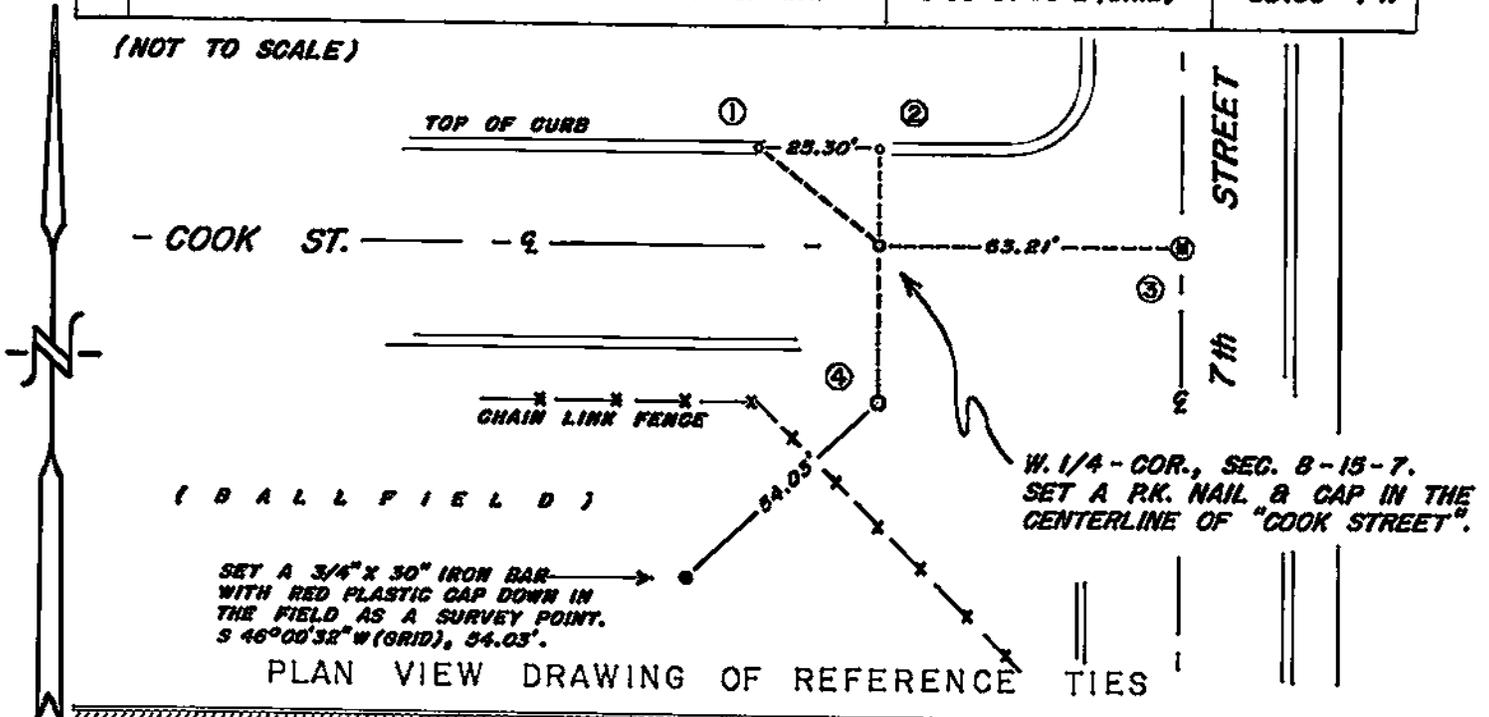

MAP SHOWING DISTANCE AND DIRECTION TO OTHER PUBLIC LAND SURVEY CORNERS USED FOR REESTABLISHING THE CORNER


(GRID BEARINGS AND DISTANCES)
(GRID FACTOR: 0.9999267)
(NOT TO SCALE)

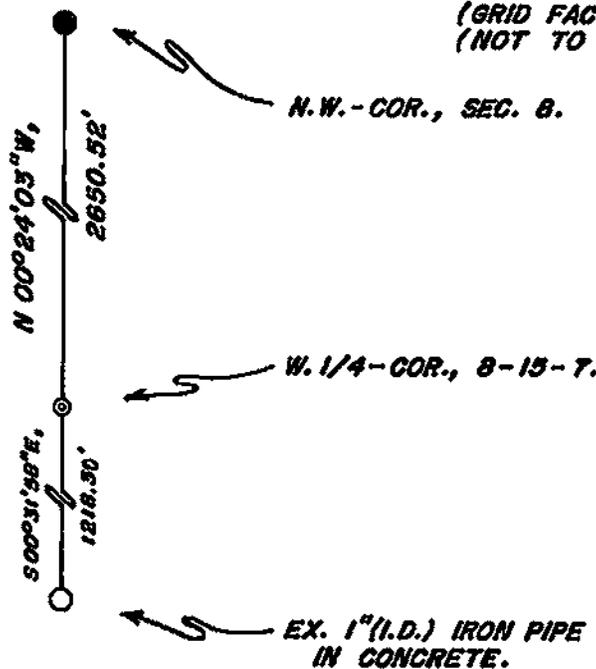

I, WILLIAM C. JUNG, COUNTY SURVEYOR
HEREBY CERTIFY THAT THE CORNER LOCATION SHOWN ON THIS RECORD WAS DETERMINED BY ME OR UNDER MY DIRECTION AND CONTROL AND THAT THIS U. S. PUBLIC LAND SURVEY MONUMENT RECORD IS CORRECT AND COMPLETE TO THE BEST OF MY KNOWLEDGE AND BELIEF.

William C. Jung
Signature

7/7/06
Date

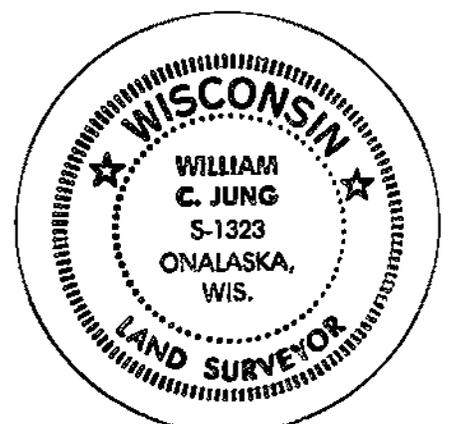

Seal