


21507080010

## U. S. PUBLIC LAND SURVEY MONUMENT RECORD

SECTION 8 T 15 N, R 7 W, CITY LA CROSSE  
 TOWN OF LA CROSSE  
 LA CROSSE COUNTY

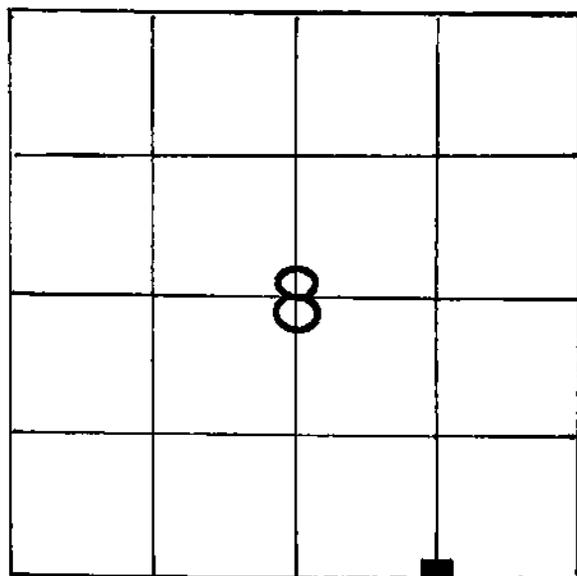

LOCATION OF LANDMARK

Crew: WILLIAM C. JUNG  
 PETER F. FOLLANSBEE

Date: 4/13/1992

Describe any record evidence, monument evidence, testimonial evidence or any other material evidence you considered and whether the monument was found or restored through acceptance of an obliterated evidence location.

I found the stone of record at the corner.

Describe or show any material discrepancy between the location of the restored corner and that of the corner previously restored or reestablished.

None Known.

WISCONSIN COORDINATE SYSTEM

North

East

Theta Angle

Horiz. Order

Vert. Order


TYPE OF LANDMARK

6" sq. Limestone in concrete.

BEARINGS ARE REFERENCED TO

RECORD OF DURABLE WITNESS MONUMENTS

NO	DESCRIPTION	BEARING	DISTANCE
1	Center of Manhole	Northwesterly $\pm$	27.65 Ft.
2	Center of Street Sign Post	Northwesterly $\pm$	47.09 Ft.
3	Top Nut of Fire Hydrant	Northeasterly $\pm$	59.15 Ft.
4	Center of Steel Fence Post	East $\pm$	81.19 Ft.

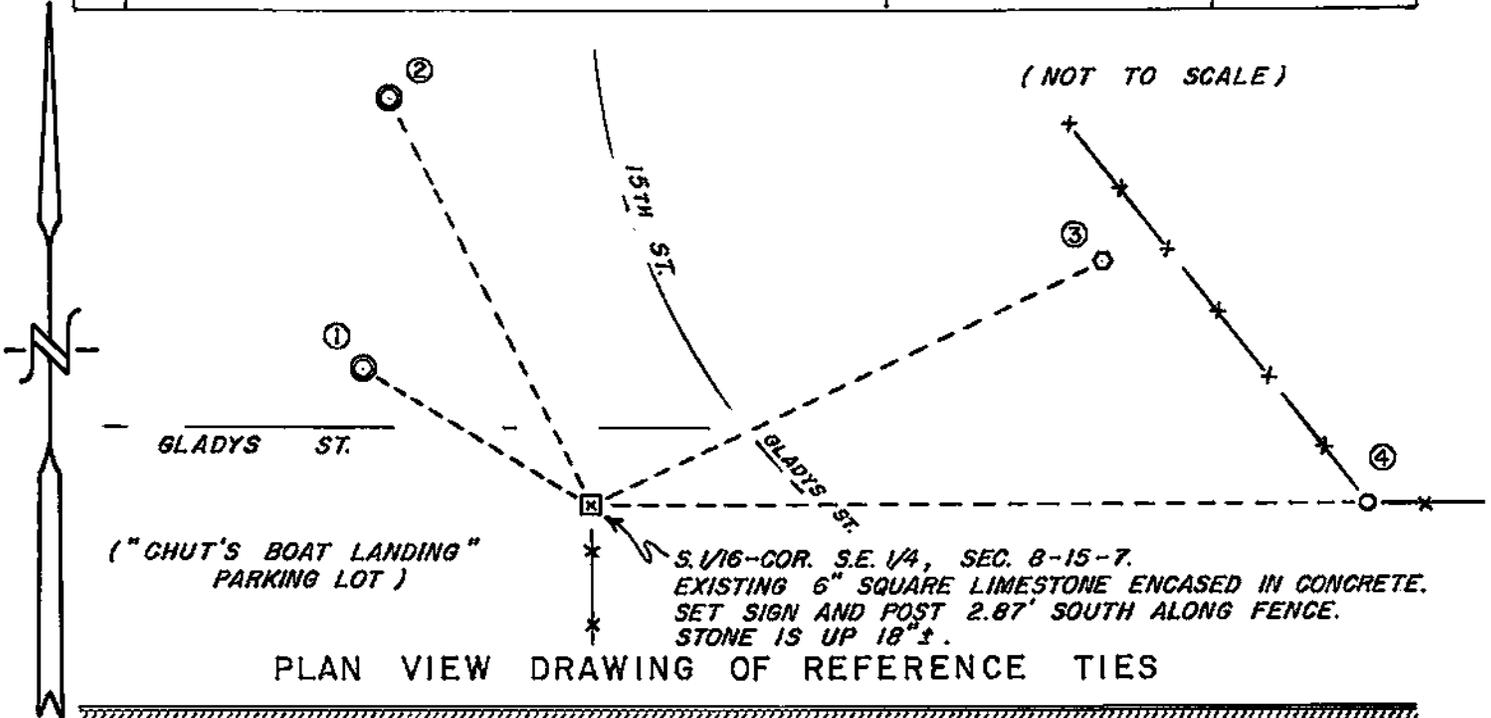


MAP SHOWING DISTANCE AND DIRECTION TO OTHER PUBLIC LAND SURVEY CORNERS USED FOR REESTABLISHING THE CORNER

NO SECTION MEASUREMENTS MADE BY ME AT THIS TIME. LOCATION CONFIRMED BY W. CLARK, R.L.S.

I, William C. Jung, Deputy County Surveyor  
HEREBY CERTIFY THAT THE CORNER LOCATION SHOWN ON THIS RECORD  
WAS DETERMINED BY ME OR UNDER MY DIRECTION AND CONTROL AND  
THAT THIS U. S. PUBLIC LAND SURVEY MONUMENT RECORD IS CORRECT  
AND COMPLETE TO THE BEST OF MY KNOWLEDGE AND BELIEF.


William C. Jung January 3, 1993  
Signature Date

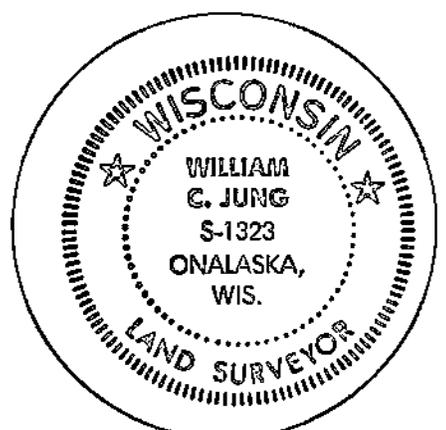

Seal

# Tie Sheet, City of La Crosse

Section 8 Township 15 N Range 7 W

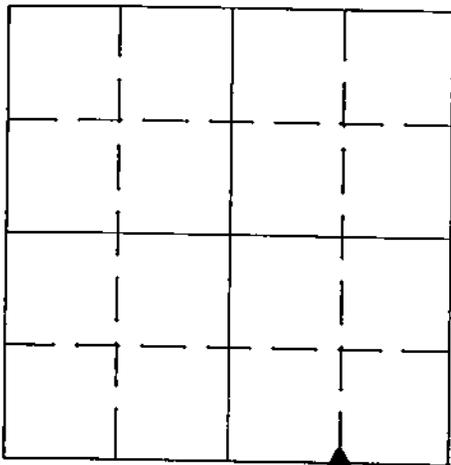


Project Section Corner  
 Sta No \_\_\_\_\_  
 Monument \_\_\_\_\_  
 Coord. System \_\_\_\_\_  
 North \_\_\_\_\_  
 East \_\_\_\_\_  
 Elev \_\_\_\_\_  
 Surveyor County

Comments:

Date \_\_\_\_\_

Space for copy of field notes or ties to above described monument:

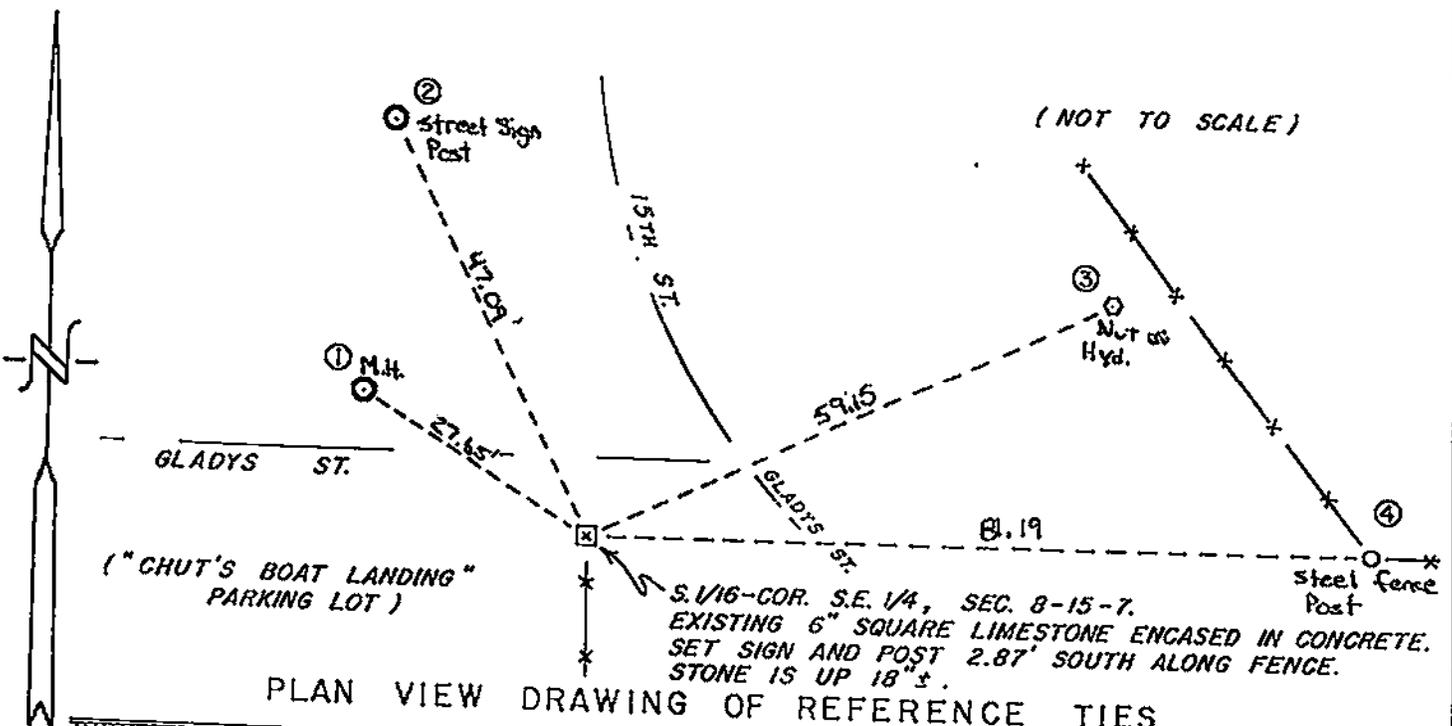

PLAN VIEW DRAWING OF REFERENCE TIES

MAP SHOWING DISTANCE AND DIRECTION TO OTHER PUBLIC LAND SURVEY CORNERS USED FOR REESTABLISHING THE CORNER