


U. S. PUBLIC LAND SURVEY MONUMENT RECORD

SECTION 8 T 15 N, R 7 W, CITY OF LA CROSSE
LACROSSE COUNTY, WISCONSIN

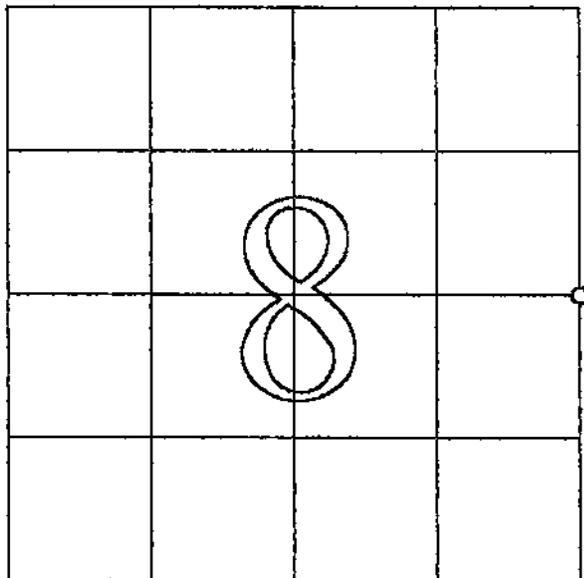

LOCATION OF LANDMARK

CREW: CHRIS FECHNER
JOSH NAVE

DATE: 09/19/2002

Describe any record evidence, monument evidence, testimonial evidence, or any other material evidence you considered and whether the monument was found or restored through acceptance of an obliterated evidence location.

THE PLAT OF GARDEN ADDITION SHOWS A STONE AT THIS CORNER LOCATION.
AFTER RETRACING BLOCK 7 OF GARDEN ADDITION, I SET THE CORNER AT THE
CENTERLINE INTERSECTIONS OF EAST AVENUE AND WESTON STREET.

Describe or show any material discrepancy between the location of the restored corner and that of the corner previously restored or reestablished.

NONE KNOWN

WISCONSIN COORDINATE SYSTEM

North

East

Theta Angle

Horiz. Order

Vert. Order


TYPE OF LANDMARK

MAG NAIL


BEARINGS ARE REFERENCED TO
K. DON PEDERSONS RETRACEMENT
OF THE WEST LINE OF THE NE 1/4
OF SECTION 8

RECORD OF DURABLE WITNESS MONUMENTS

NO	DESCRIPTION	BEARING	DISTANCE
1	SET 3/4" X 24" ROUND IRON BAR	N 50°56'47" E	42.80'
2	SET 3/4" X 24" ROUND IRON BAR	S 51°42'04" E	43.36'
3	SET 3/4" X 24" ROUND IRON BAR	S 51°36'05" W	42.87'
4	SET 3/4" X 24" ROUND IRON BAR	N 52°17'40" W	40.95'

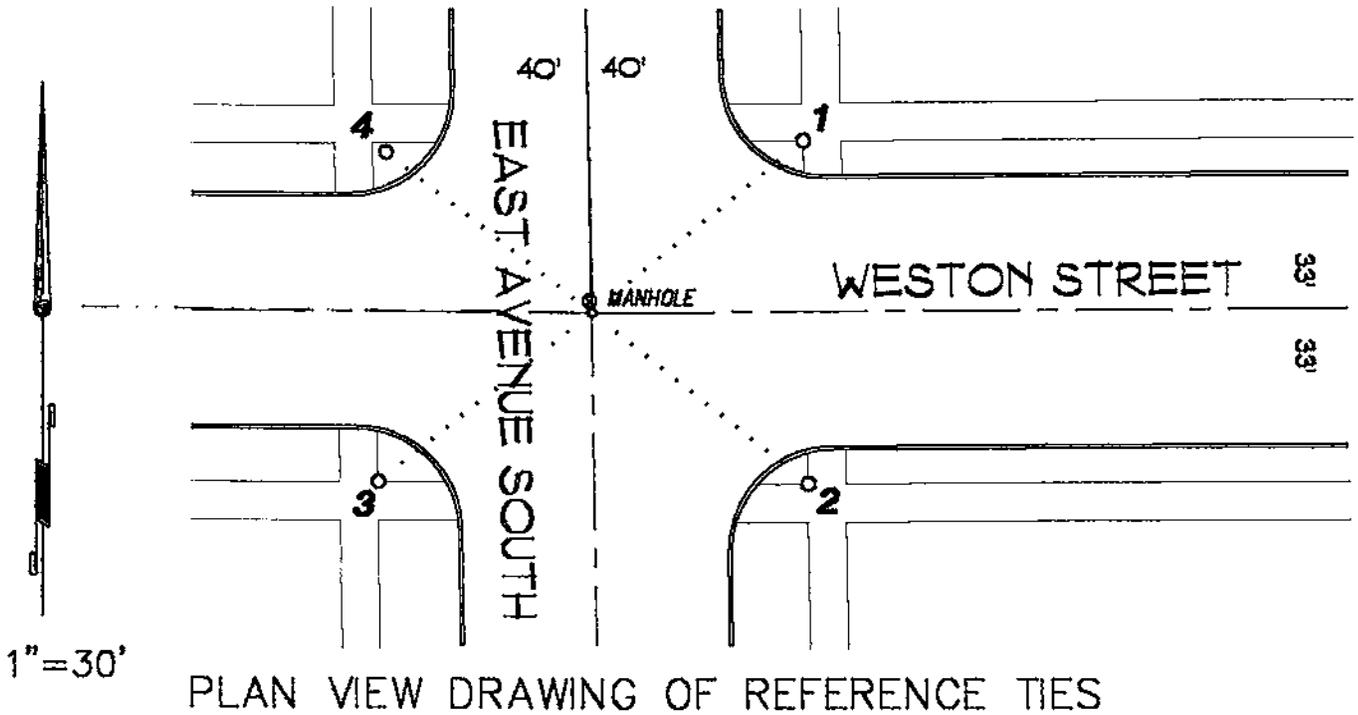

MAP SHOWING DISTANCE AND DIRECTION TO OTHER PUBLIC LAND SURVEY CORNERS USED FOR REESTABLISHING THE CORNER

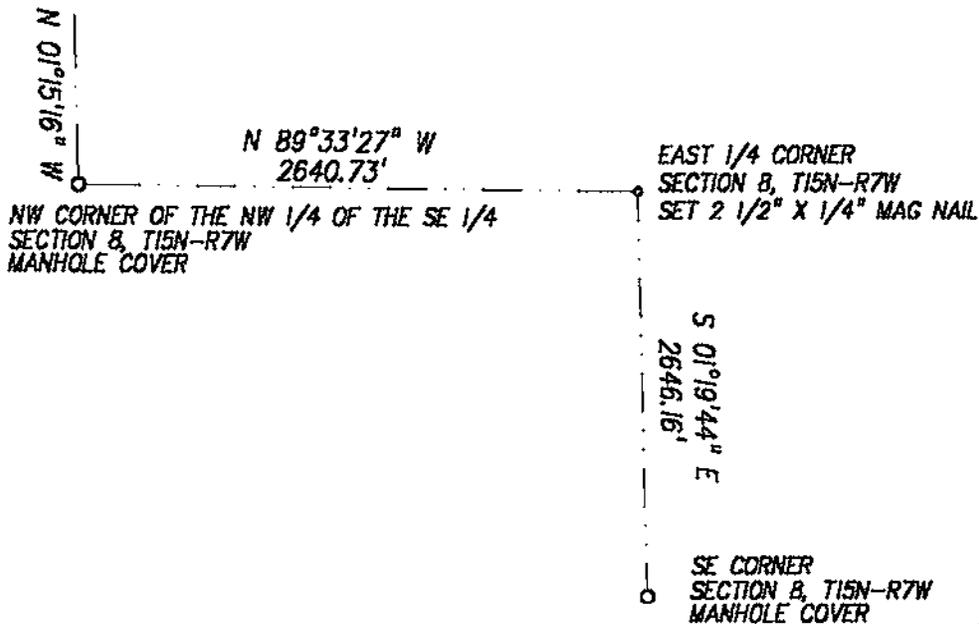


I, CHRISTOPHER W. FECHNER, RLS#2448
 HEREBY CERTIFY THAT THE CORNER LOCATION SHOWN ON THIS RECORD
 WAS DETERMINED BY ME OR UNDER MY DIRECTION AND CONTROL AND
 THAT THIS U. S. PUBLIC LAND SURVEY MONUMENT RECORD IS CORRECT
 AND COMPLETE TO THE BEST OF MY KNOWLEDGE AND BELIEF.

Christopher W. Fechner 10/01/82

Signature

Date

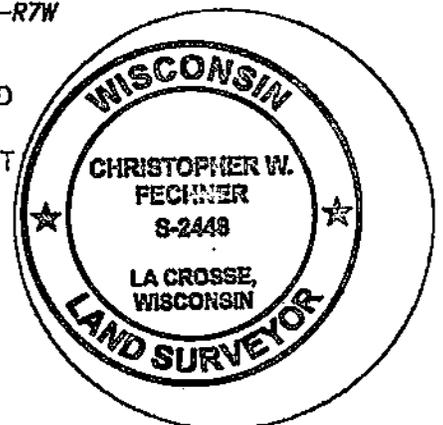

Seal