


U.S. PUBLIC LAND SURVEY MONUMENT RECORD

SECTION 8, T15N, R7W, CITY OF LA CROSSE
LA CROSSE COUNTY


CERTIFICATE

I, K. DON PEDERSON, DO HEREBY CERTIFY THAT ON THE 23RD DAY OF MAY, 2001 I FOUND NO EVIDENCE OF THE CENTER 1/4 CORNER OF SECTION 8, T15 N, R7 W, AND I REESTABLISHED SAID CORNER ACCORDING TO THE WISCONSIN STATUTES AS SHOWN AND DESCRIBED HEREON.

DATED THIS 5TH DAY OF JULY 2001

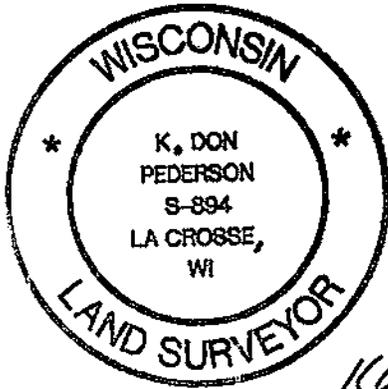

K. Don Pederson

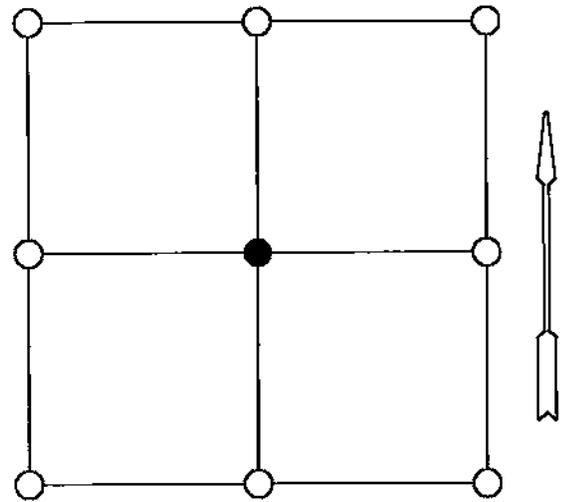

● = CORNER LOCATION
SECTION 8, T15N, R7W

HISTORY OF ORIGINAL CORNER ESTABLISHMENT:

DESCRIPTION OF CORNER EVIDENCE FOUND:

THE INTERSECTION OF CENTERLINES OF EXISTING STREETS AND THE NORTH LINE OF WESTON STREET (HALF STREET) IN SHOOTING PARK ADDITION (PLATTED IN 1919) WERE ESTABLISHED USING EXISTING MONUMENTS AND BEST EVIDENCE AVAILABLE. R.M. SCHELBLE AND F.J. KRAFT ESTABLISHED THE NORTH LINE OF SHOOTING PARK ADDITION ON JULY 30, 1954.

DESCRIPTION OF CORNER AND WITNESS MONUMENTS, REFERENCES AND ACCESSORIES USED TO PERPETUATE THE ORIGINAL OR REESTABLISHED LOCATION OF THIS CORNER:

WITNESSES TO CORNER LOCATION:

K. DON PEDERSON
PAUL CHAFER

SKETCH:

- T-1 49.36' N28°07'03"E
- T-2 86.52' N70°26'24"W
- T-3 52.42' S38°55'19"W
- T-4 86.25' S26°35'47"E

