

U. S. PUBLIC LAND SURVEY MONUMENT RECORD

SECTION 9, TOWNSHIP 15 NORTH, RANGE 7 WEST

CITY of LA CROSSE

LA CROSSE COUNTY, WISCONSIN

9

COORDINATE SYSTEM	
NORTHING	652,335.25
EASTING	1,649,205.72
THETA ANGLE	
HORIZ. ORDER	
VERT. ORDER	
BEARINGS ARE REFERENCED TO: Wisconsin South Zone	
TYPE OF MONUMENT 3/4" x 30" iron bar	

Describe any record evidence, monument evidence, testimonial evidence or any other material evidence you considered and whether the monument was found or restored through acceptance of an obliterated evidence location.

Jung had recently reset this corner using a PK nail. Prior to road reconstruction, I checked his ties and set two additional ones. After the work was completed, I reset this corner using a 3/4" iron rebar.


Describe or show any material discrepancy between the location of the restored corner and that of the corner previously restored or reestablished.

The gas valve tied out by Jung is currently not at the surface and the manhole used as a tie was reset, thus the distance has changed.


REFERENCE TIES

#	DESCRIPTION	BEARING	DISTANCE
1	Center of base of fire hydrant	NW	44.57'
2	Center of water valve cap	NW	39.20'
3	Drill hole in concrete walk	SE	53.98'
4	Drill hole in concrete walk	E	23.45'

PLAN VIEW OF REFERENCE TIES

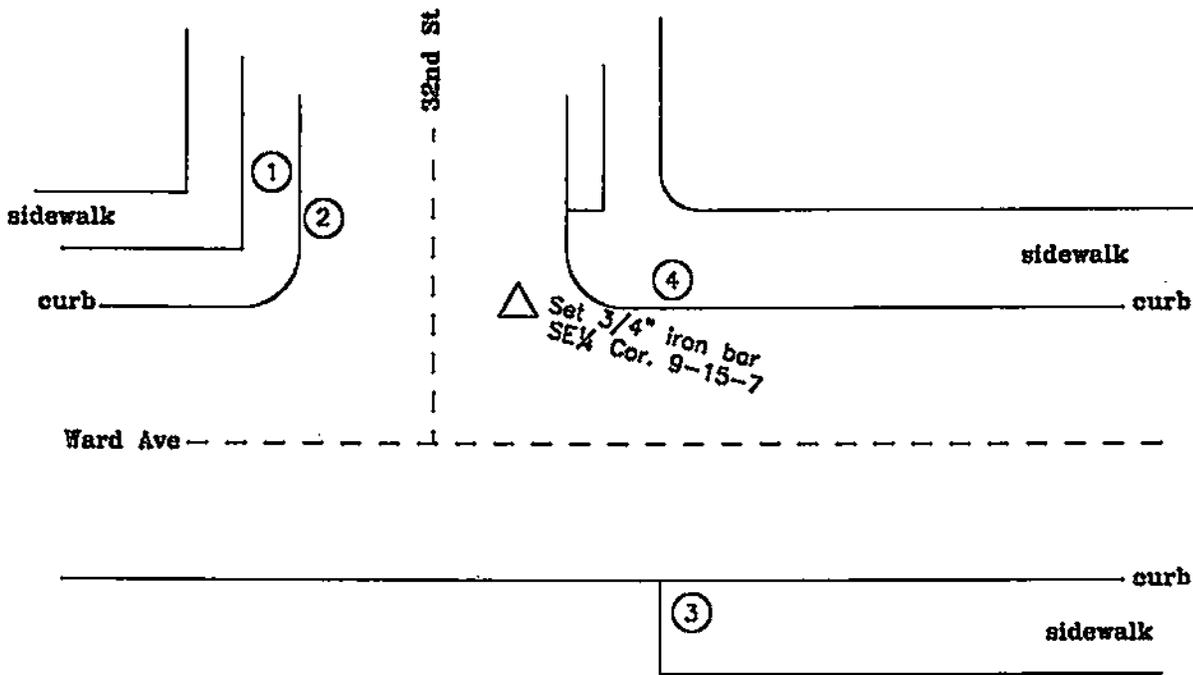

DISTANCE AND DIRECTION TO OTHER P.L.S.S. CORNERS USED

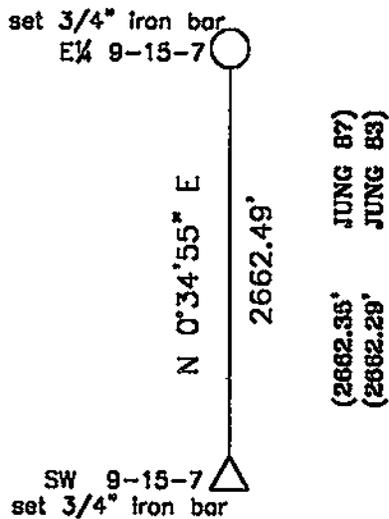


I, DAVID J. KARL, WISCONSIN REGISTERED LAND SURVEYOR #2136 CERTIFY THAT THE CORNER LOCATION SHOWN ON THIS RECORD WAS RESET OR DETERMINED BY ME OR UNDER MY DIRECTION AND CONTROL. I FURTHER CERTIFY THAT THIS DOCUMENT IS CORRECT AND COMPLETE TO THE BEST OF MY KNOWLEDGE.

1-26-99

David J. Karl

U. S. PUBLIC LAND SURVEY MONUMENT RECORD

SECTION 9 T 15 N, R 7 W, ~~TOWN OF~~ CITY OF LACROSSE
 LA CROSSE COUNTY

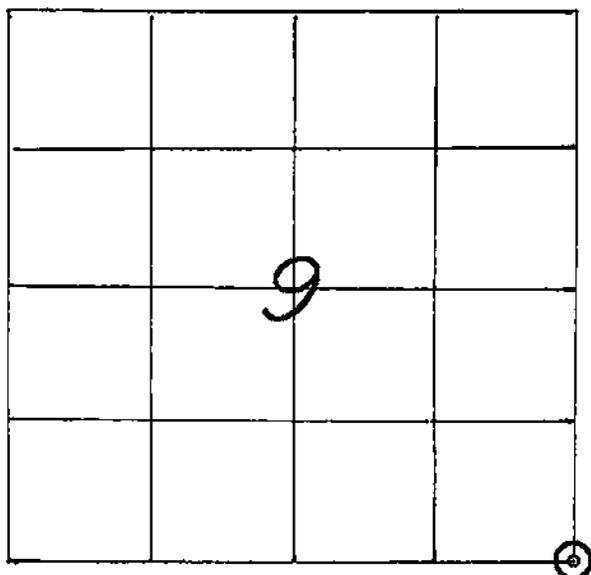

LOCATION OF LANDMARK

CREW: WILLIAM C. JUNG
 PETER F. FOLLANSBEE
 DATE: 8/29/1997

WISCONSIN COORDINATE SYSTEM

North

East

Theta Angle

Horiz. Order

Vert. Order

TYPE OF LANDMARK

P.K. NAIL.

BEARINGS ARE REFERENCED TO

Assumed

Describe any record evidence, monument evidence, testimonial evidence or any other material evidence you considered and whether the monument was found or restored through acceptance of an obliterated evidence location.

The railroad spike that I tied off in 1983 had been knocked out. I set a P.K. nail at the old location.

Describe or show any material discrepancy between the location of the restored corner and that of the corner previously restored or reestablished.

NONE KNOWN.

LaCrosse County U.S. Public Land Survey Monument Record

RECORD OF LAND CORNER PERPETUATION

No. _____

STATE OF WISCONSIN

County of Monroe } ss.

William C. Jung hereby certify that the information shown hereon correctly describes the original corner, resurvey information, evidence found, type of monument found or placed, and witness monuments and accessories used to perpetuate the location of the original or established corner.

Dated this 26th day of August, 1983

at Tomah, Wisconsin.

William C. Jung
Registered Land Surveyor 1323

Title

COUNTY LaCrosse		
TOWN City of LaCrosse		
HIGHWAY Near the intersection of 32nd Street and Ward Avenue		
SECTION 9	TOWNSHIP T15N	RANGE R7W
TYPE OF LANDMARK Railroad Spike		


Date of Survey, August 18, 1983

Drafted by Jung


Date August 26, 1983

Witness to corner:
Dalls Wilhite

Southeast Corner-Sec.9-T15N-R7W

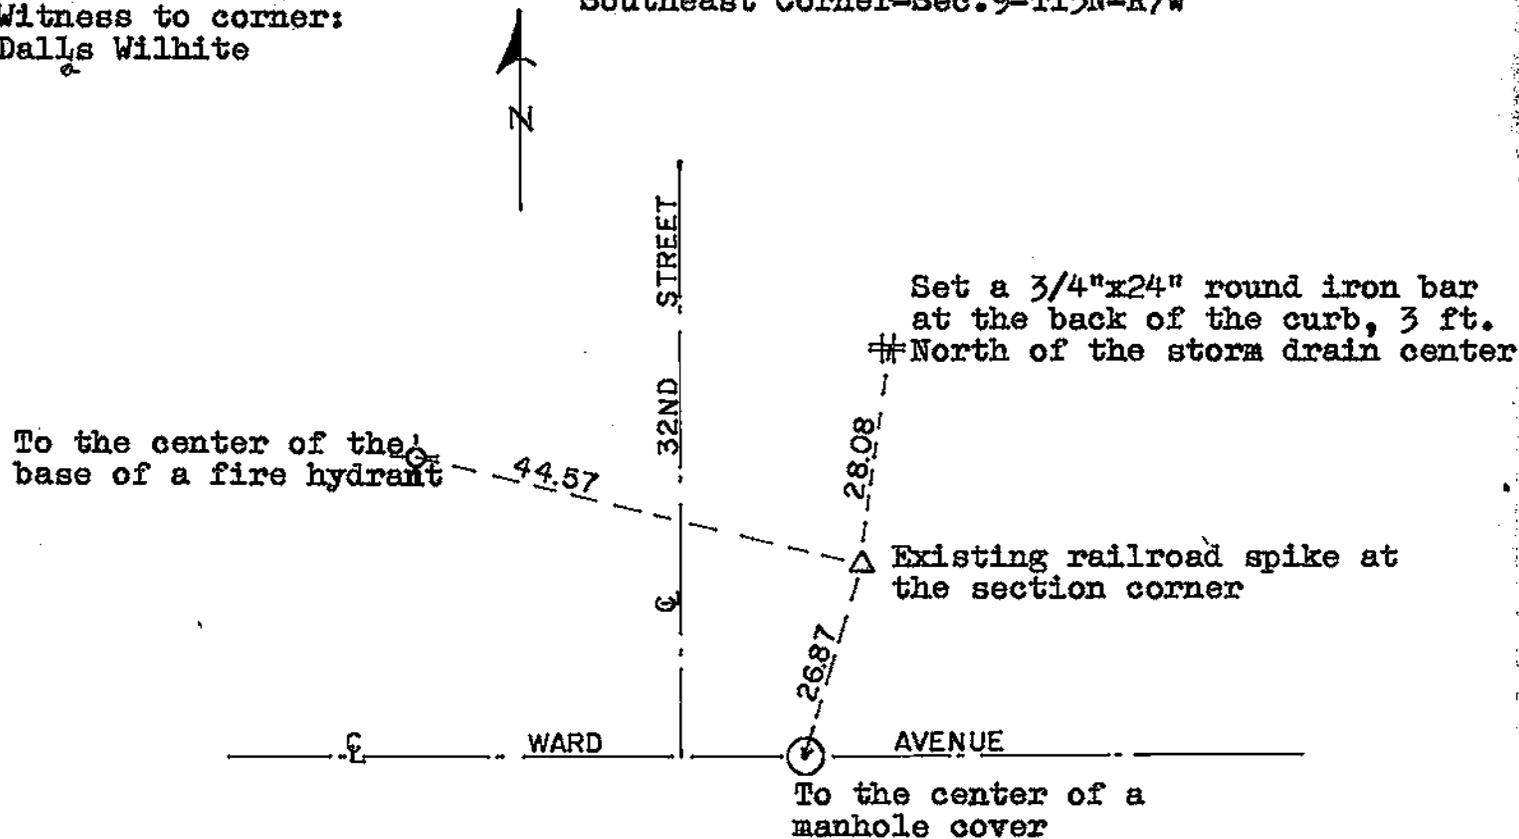

WISCONSIN COORDINATE SYSTEM	
North	Zone
East	
Elevation	Theta Angle
Vertical control order	
Horizontal control order	

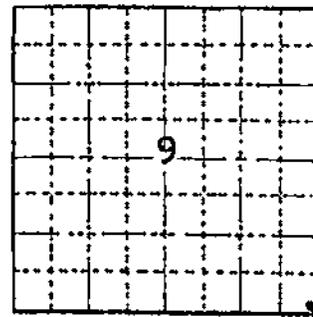

REMARKS: I found a railroad spike at the section corner. This spike had been set by Wilbur Clark. It was also used as the corner by surveyors from the Department of Transportation when they were traversing in Section 9. My computations also show that this corner as set fits the corner location of "Second Addition to the Green Acres Addition", "First Addition to Wedgewood Terrace Addition", and "Starlite Addition".

LOCATION SKETCH

(Location of landmark indicated by "x")

9 10 R.R. SPIKE SET FROM S.E. BLOCK CORNER.
 16 15 ← SEC. CORNER AT WARD AVE. & 32ND ST.

N 652,339.100 } U.S.C.E.
 E 1,680,731.195 }

5,342.544' ✓ } U.S.C.E.
 N 2°-13'-48.6" E }

5,342.61' } CITY OF LA CROSSE.
 N 0°-26'-22" E }

STONE MONUMENT -
 SECTION CORNER SOUTH OF
 ← BROADVIEW PLACE ON WEST R.R. R.D.W. LINE.

16 15
 21 22 N 647,000.603 } U.S.C.E.
 E 1,680,523.295 }

- 647,000.603	:	1,680,731.195
+ 652,339.100	:	- 1,680,523.295
5,338.497 ✓	:	207.900 ✓

