


U. S. PUBLIC LAND SURVEY MONUMENT RECORD

SECTION 16 T 15 N, R 7 W, TOWN OF SHELBY/CITY OF LACROSSE  
LA CROSSE COUNTY

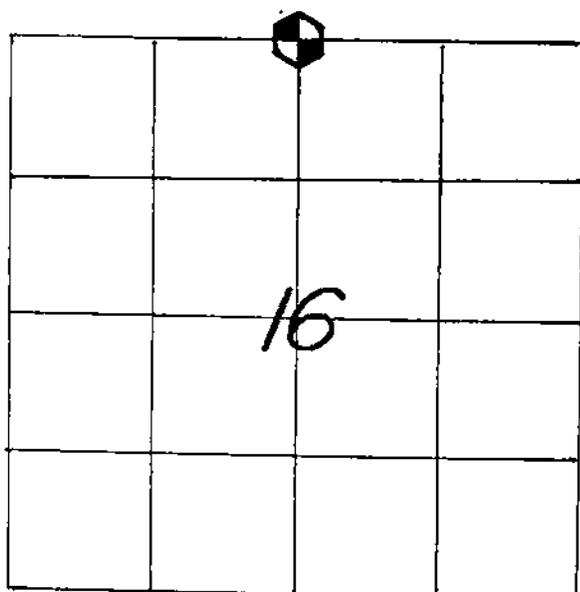

LOCATION OF LANDMARK

CREW: WILLIAM C. JUNG  
PETER F. FOLLANSBEE  
DATE: 6/17/05

WISCONSIN COORDINATE SYSTEM	
North	652,277.93
East	1,646,529.39
Theta Angle	
Horiz. Order	
Vert. Order	
83(91) datum	

TYPE OF LANDMARK  
**BRASS GAP LUNDE MARKER.**

BEARINGS ARE REFERENCED TO  
WILBUR L. CLARK'S TIE SHEET DATED  
9-29-1989. (WESTERLY R/W OF U.S.H. 14  
& 61, AND "SEMINARY PARK" ADDN.,  
ALONG MORMON GOULEE ROAD.,  
RECORDED BEARING OF S 36°-38' E.)

Describe any record evidence, monument evidence, testimonial evidence or any other material evidence you considered and whether the monument was found or restored through acceptance of an obliterated evidence location.


The P.K. nail was knocked out due to road construction. We set a brass capped Lunde marker at the corner and took new ties. During construction we searched the corner location for an old monument in the subsurface. We did not find anything. Any marker there would have been destroyed years earlier when a NW-SE underground concrete utility conduit was put in. We found the conduit abandoned.

Describe or show any material discrepancy between the location of the restored corner and that of the corner previously restored or reestablished.

None known.

RECORD OF DURABLE WITNESS MONUMENTS


NO	DESCRIPTION	BEARING	DISTANCE
1	W.ERLY CORNER OF "TRANE CREDIT UN." BRICK PLANTER	N 25°06'E ±	42.67 FT.
2	EX. 2-3/8" I.D. STEEL PIPE AT BACK OF SIDEWALK	N 36°02'E ±	30.52 FT.
3	SET SMALL DRILL HOLE 0.17' BACK OF BRICK EDGE	N 40°37'E ±	40.94 FT.
4	S.ERLY CORNER OF "TRANE CREDIT UN." BRICK PLANTER	N 56°28'E ±	42.03 FT.

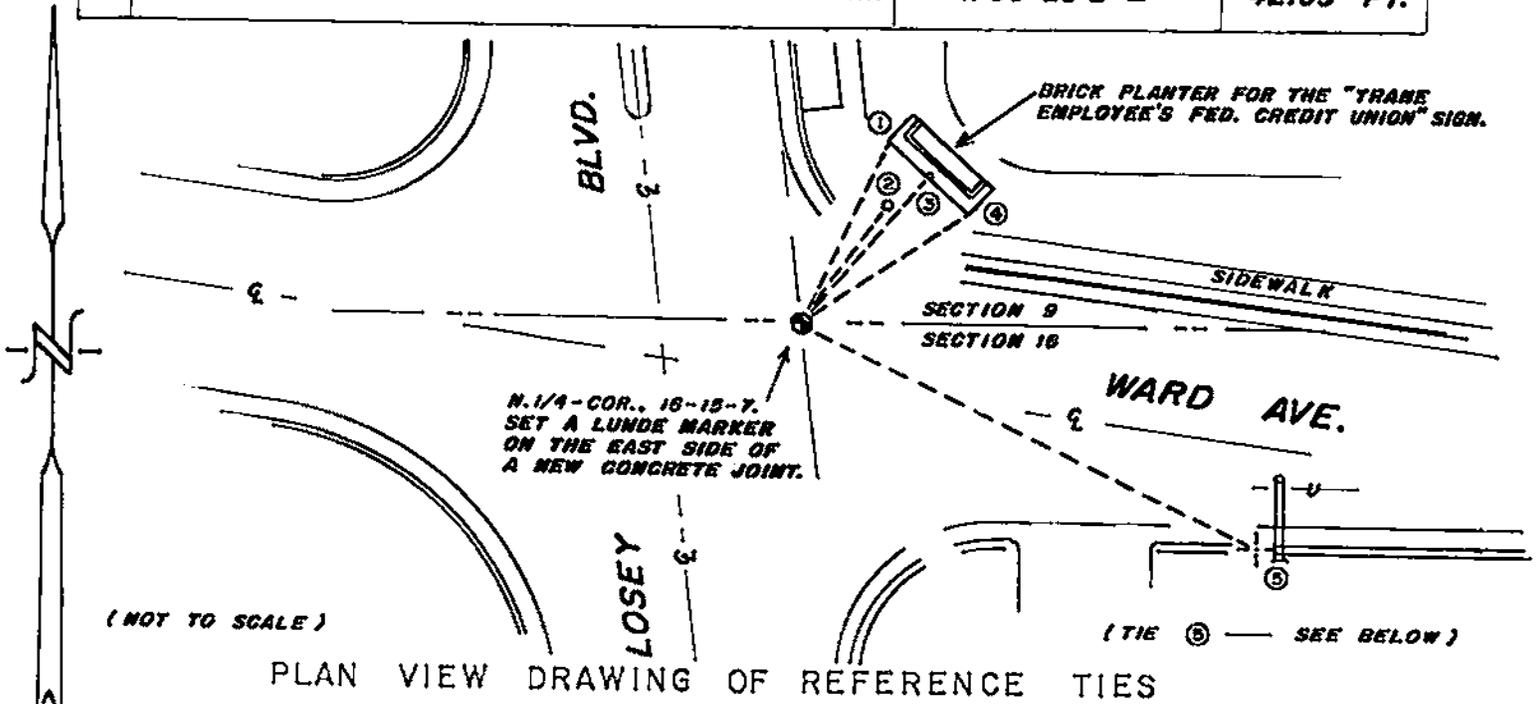

MAP SHOWING DISTANCE AND DIRECTION TO OTHER PUBLIC LAND SURVEY CORNERS USED FOR REESTABLISHING THE CORNER


5	EXIST. DRILL HOLE, TOP OF CURB, EAST OF DRIVEWAY & 3'± WEST OF A POWER POLE	S 64°47'E ±	106.40 FT.
6			

WILBUR L. CLARK MEASUREMENTS.  
NOT TO SCALE.

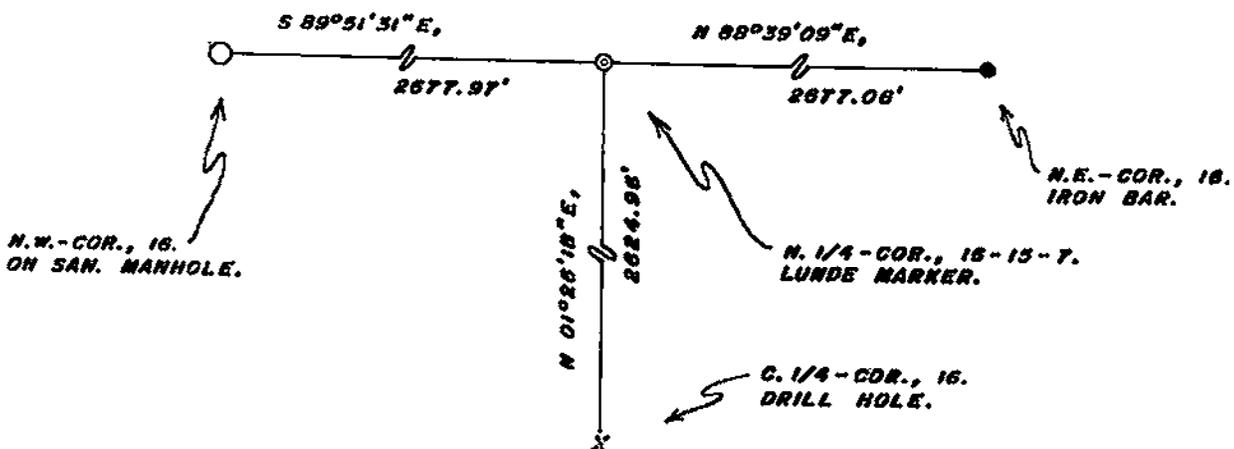

I, WILLIAM C. JUNG, COUNTY SURVEYOR  
HEREBY CERTIFY THAT THE CORNER LOCATION SHOWN ON THIS RECORD WAS DETERMINED BY ME OR UNDER MY DIRECTION AND CONTROL AND THAT THIS U. S. PUBLIC LAND SURVEY MONUMENT RECORD IS CORRECT AND COMPLETE TO THE BEST OF MY KNOWLEDGE AND BELIEF.


William C. Jung 3/1/06  
Signature Date

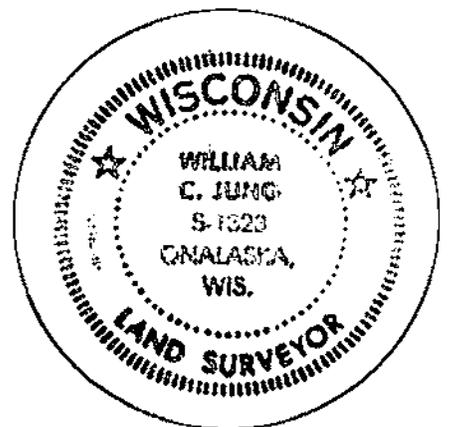

Seal

## U. S. PUBLIC LAND SURVEY MONUMENT RECORD

SECTION 16 T 15 N, R 7 W, TOWN OF SHELBY/CITY OF LACROSSE  
LA CROSSE COUNTY

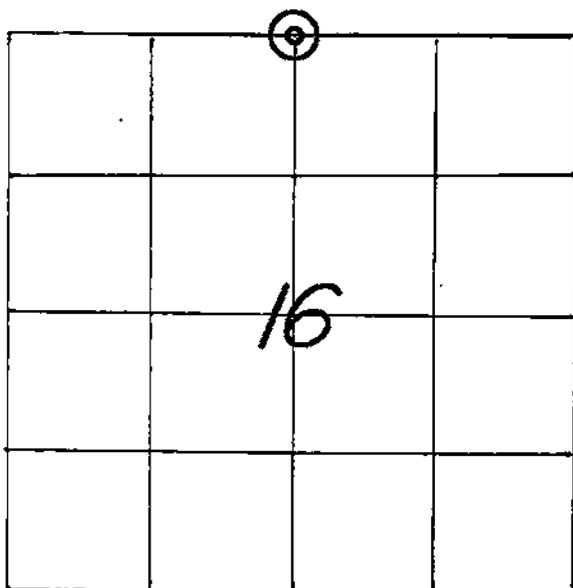

LOCATION OF LANDMARK

CREW: WILLIAM C. JUNG  
PETER F. FOLLANSBEE  
DATE: 6/11/2002

## WISCONSIN COORDINATE SYSTEM

North

East

Theta Angle

Horiz. Order

Vert. Order

## TYPE OF LANDMARK

P.K. NAIL IN PAVEMENT CRACK.

BEARINGS ARE REFERENCED TO  
WILBUR L. CLARK'S TIE SHEET DATED  
9-29-1989. (WESTERLY R/W OF U.S.H. 14  
& 61, AND "SEMINARY PARK" ADDN.,  
ALONG MORMON COULEE ROAD.,  
RECORDED BEARING OF S 36°-38' E.)

Describe any record evidence, monument evidence, testimonial evidence or any other material evidence you considered and whether the monument was found or restored through acceptance of an obliterated evidence location.

The monument of record had been knocked out. I set a P.K. nail and cap at the corner using Clark's ties from 1989.


Describe or show any material discrepancy between the location of the restored corner and that of the corner previously restored or reestablished.

There is an existing P.K. nail 0.23 feet South of our corner. I do not agree with the other P.K. nail.

VOID  
weg

RECORD OF DURABLE WITNESS MONUMENTS


NO	DESCRIPTION	BEARING	DISTANCE
1	W.'ERLY CORNER OF "TRANE CREDIT UN." BRICK PLANTER	N 25°05'47" E	42.65 FT.
2	EX. 2-3/8" I.D. STEEL PIPE AT BACK OF SIDEWALK	N 36°01'36" E	30.51 FT.
3	SET SMALL DRILL HOLE 0.17' BACK OF BRICK EDGE	N 40°37'08" E	40.93 FT.
4	S.'ERLY CORNER OF "TRANE CREDIT UN." BRICK PLANTER	N 56°28'02" E	42.05 FT.

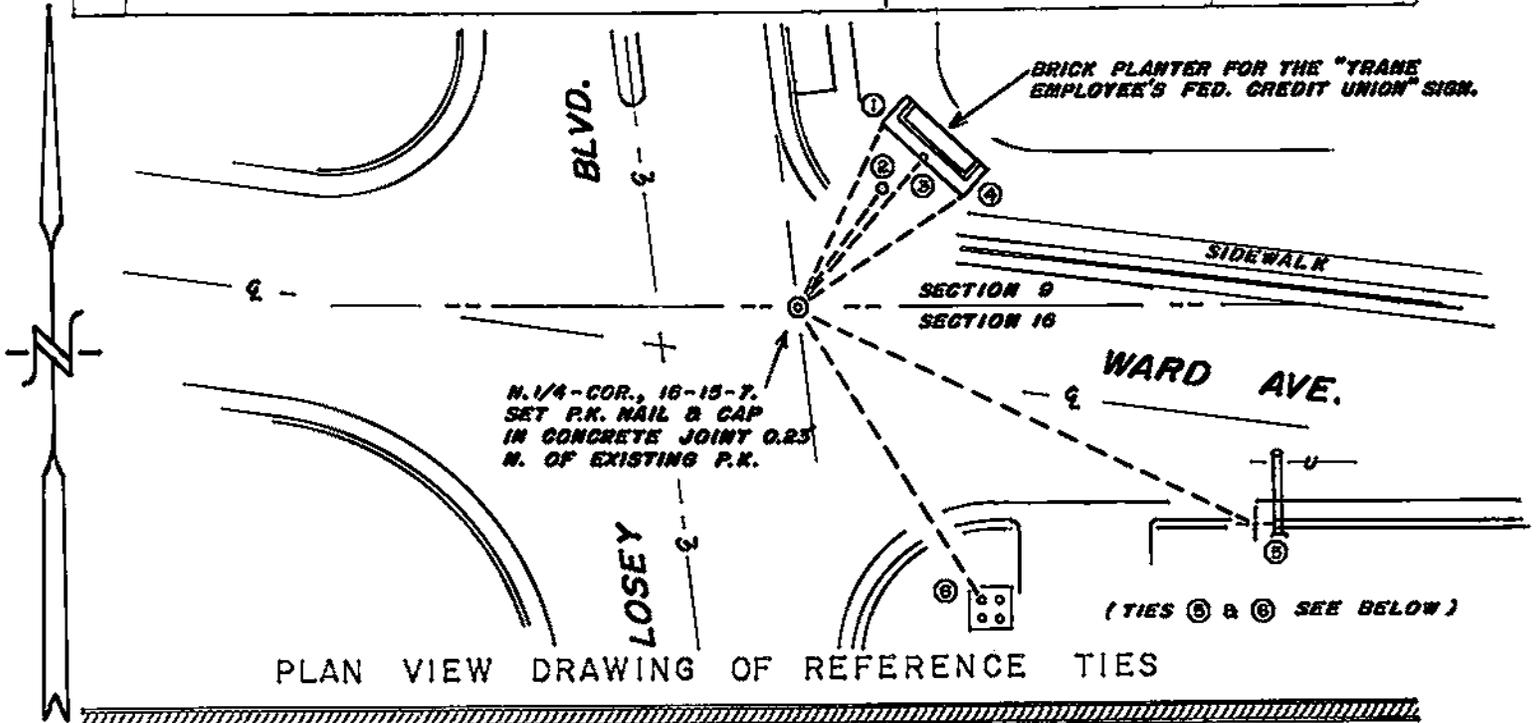

MAP SHOWING DISTANCE AND DIRECTION TO OTHER PUBLIC LAND SURVEY CORNERS USED FOR REESTABLISHING THE CORNER

5	EXIST. DRILL HOLE, TOP OF CURB, EAST OF DRIVEWAY & 3'± WEST OF A POWER POLE	S 64°46'39" E	106.52 FT.
6	N.W. BOLT OF CONC. SIGN BASE, "DAYTON TIRES", "FRANK - LEN, INC."	S 32°05'52" E	72.24 FT.

WILBUR L. CLARK MEASUREMENTS.  
NOT TO SCALE.

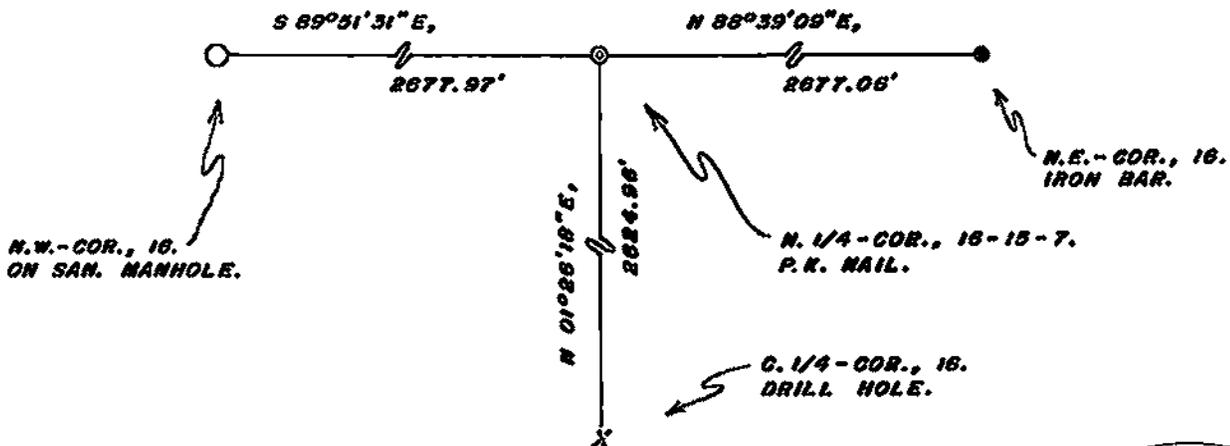

I, WILLIAM C. JUNG, COUNTY SURVEYOR  
HEREBY CERTIFY THAT THE CORNER LOCATION SHOWN ON THIS RECORD WAS DETERMINED BY ME OR UNDER MY DIRECTION AND CONTROL AND THAT THIS U. S. PUBLIC LAND SURVEY MONUMENT RECORD IS CORRECT AND COMPLETE TO THE BEST OF MY KNOWLEDGE AND BELIEF.


William C. Jung 10/17/02  
Signature Date



Seal

U. S. PUBLIC LAND SURVEY MONUMENT RECORD

SECTION 16 T 15 N, R 7 W, <sup>CITY</sup> TOWN OF LA CROSSE.  
 LA CROSSE COUNTY

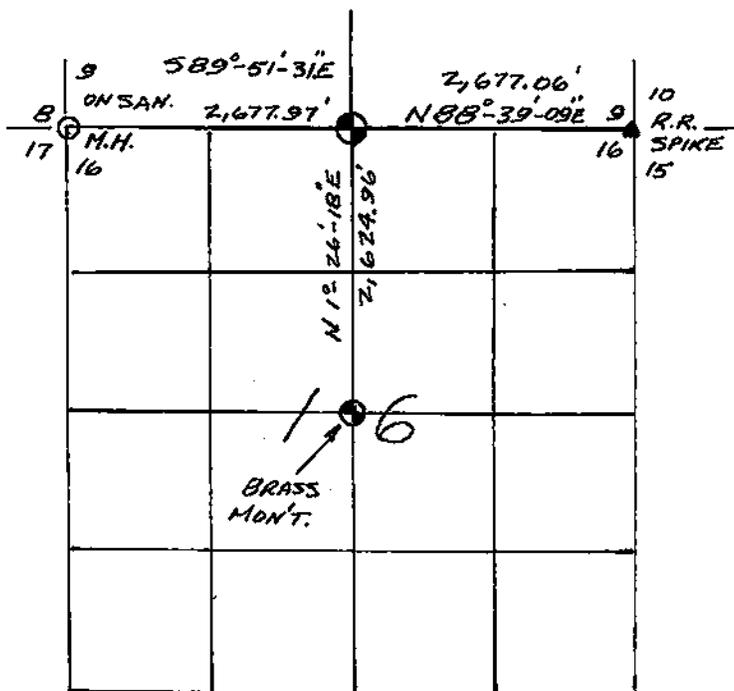

LOCATION OF LANDMARK  
N. 1/4 CORNER, SECTION 16.

WISCONSIN COORDINATE SYSTEM

North  
 East  
 Theta Angle  
 Horiz. Order  
 Vert. Order

TYPE OF LANDMARK  
3 5/8" φ BRASS MONUMENT.

BEARINGS ARE REFERENCED TO  
 WESTERLY RIGHT OF WAY OF U.S.H.  
 14 & 6, AND "SEMINARY PARK" ADDN.,  
 ALONG MORMON COULEE ROAD;  
RECORD BEARING OF 536°-38'E.

Describe any record evidence, monument evidence, testimonial evidence or any other material evidence you considered and whether the monument was found or restored through acceptance of an obliterated evidence location.

3 5/8" φ BRASS MONUMENT FOUND IN CONC. PAVT.  
(SET BY D.O.T.?)

Describe or show any material discrepancy between the location of the restored corner and that of the corner previously restored or reestablished.


NOT KNOWN

RECORD OF DURABLE WITNESS MONUMENTS

NO	DESCRIPTION	BEARING	DISTANCE
1	W'LY CORNER, BRICK PLANTER; SIGN FOR "TRANE EMPLOYEE'S FED. CREDIT UNION".	N25°-06'E	42.68'
2	2 3/8" Ø I.D. STEEL PIPE AT BACK OF SIDEWALK.	N36°-01'-36"E	30.51'
3	S'LY CORNER, BRICK PLANTER; SIGN FOR TRANE C.U.	N56°-25'-36"E	42.10'
4	N.W. BOLT, CONC. SIGN BASE, "DAYTON TIRES", "FRANK-LEN, INC."	S30°±E	72.25'
5	DRILL HOLE, TOP OF CURB, E. OF DRIVE & 3'± W. OF POWER POLE.	S64°-46'-42"E	106.54'


PLAN VIEW DRAWING OF REFERENCE TIES (SEE BELOW.)

MAP SHOWING DISTANCE AND DIRECTION TO OTHER PUBLIC LAND SURVEY CORNERS USED FOR REESTABLISHING THE CORNER - N/A.

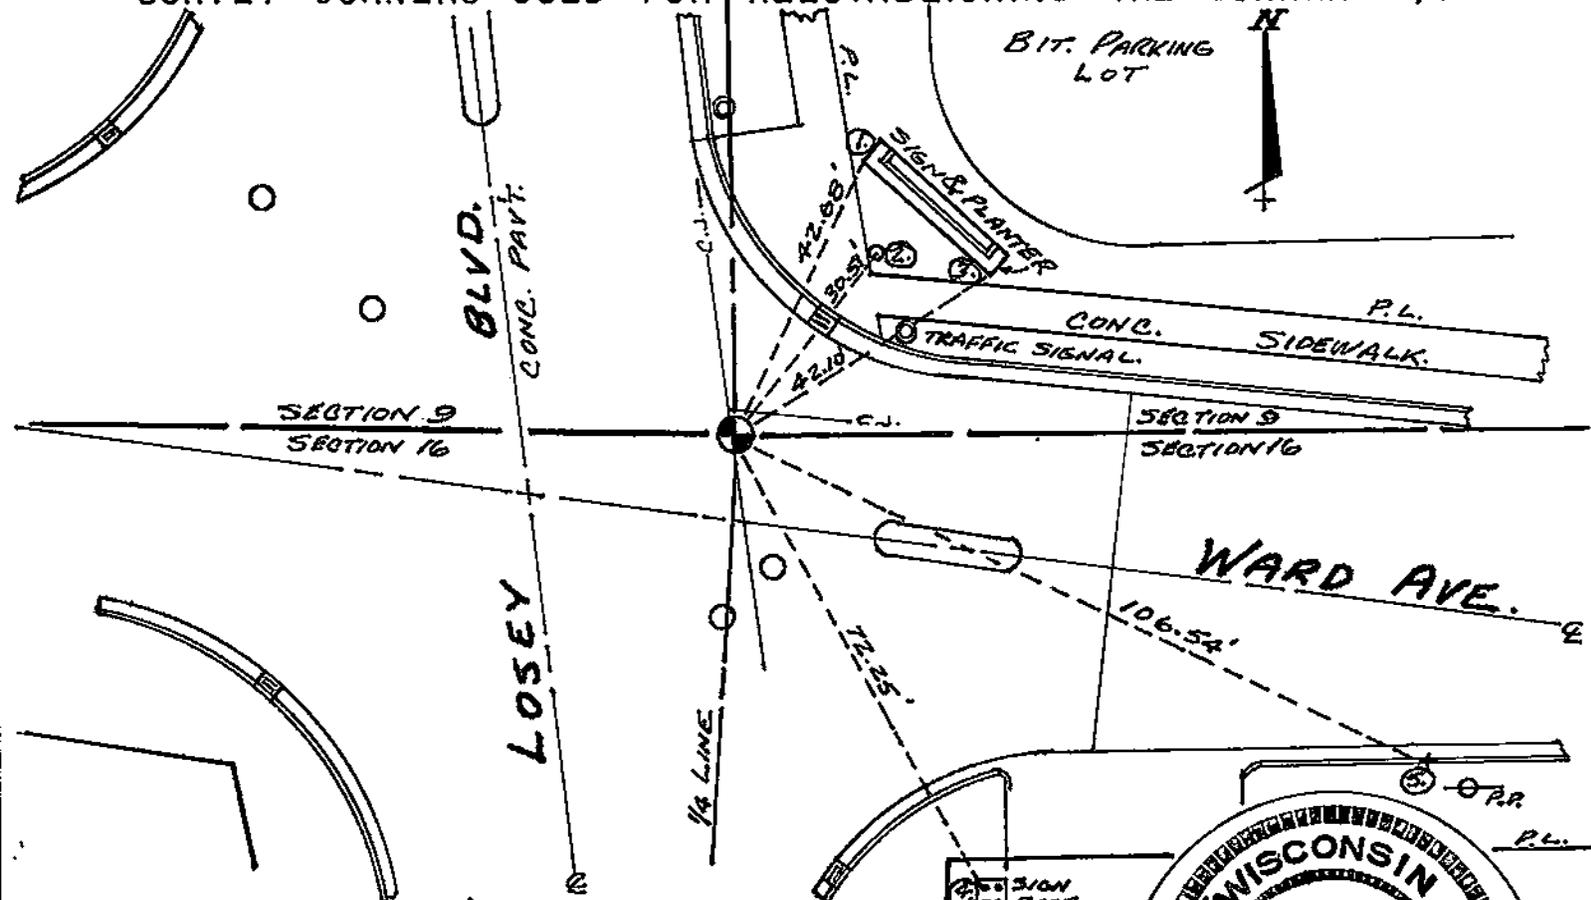

I, WILBUR L. CLARK.  
 HEREBY CERTIFY THAT THE CORNER LOCATION SHOWN ON THIS RECORD WAS DETERMINED BY ME OR UNDER MY DIRECTION AND CONTROL AND THAT THIS U. S. PUBLIC LAND SURVEY MONUMENT RECORD IS CORRECT AND COMPLETE TO THE BEST OF MY KNOWLEDGE AND BELIEF.

Wilbur L. Clark, 9-29-1989.  
 Signature R.L.S. 914. Date

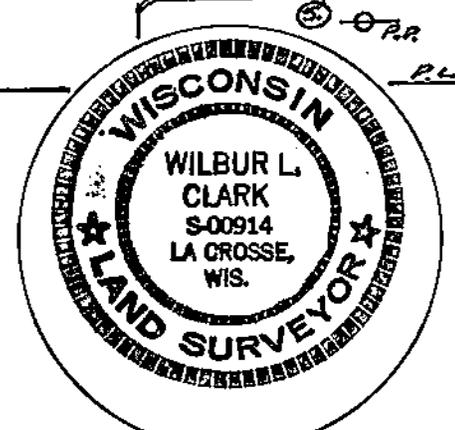

Seal

FORM NO. 710

# PRESERVATION OF LANDMARKS

PAGE \_\_\_\_\_

SECTION 59,635(7) WISCONSIN STATUTES

COUNTY LA CROSSE

CITY LA CROSSE

TOWN LA CROSSE



HIGHWAY LOSEY BLVD.

SECTION NO. 9


T. 15 N., R. 7 E.

TYPE OF LANDMARK SE COR, SE 1/4-SW 1/4

LOCATION INDICATED ON SKETCH X

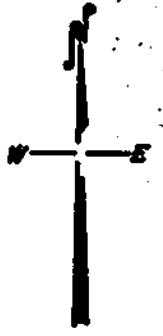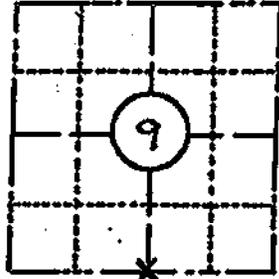

LOCATION SKETCH

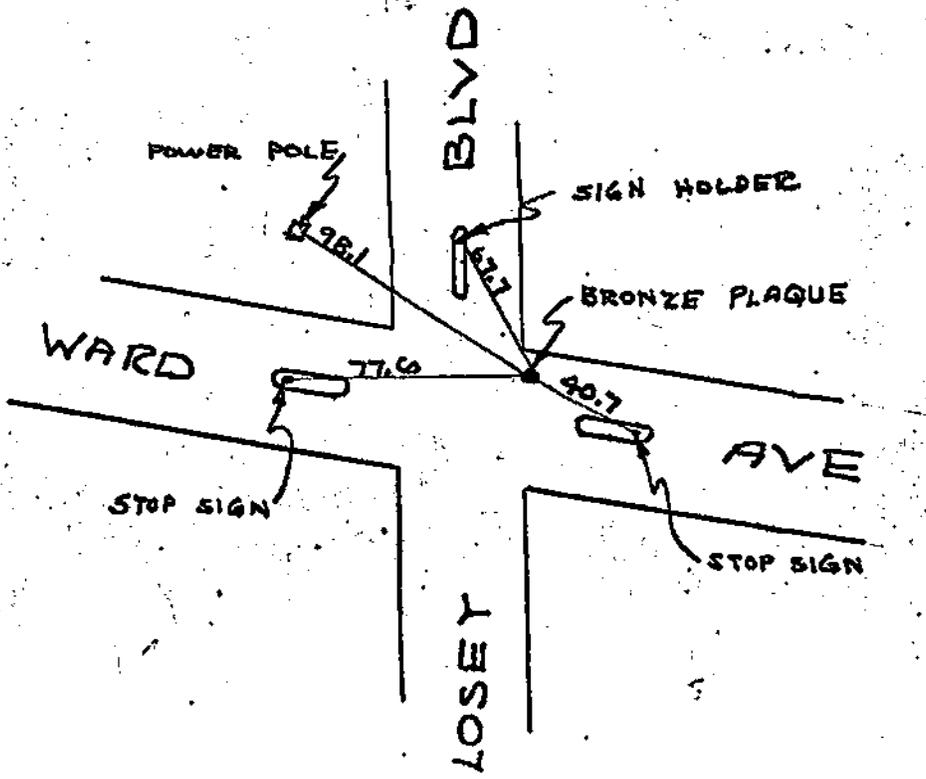

*This space for copy of field notes or ties to the above described landmarks*

Field notes or records filed in book no. 403 F (CENTERLINE BOOK)  
at the DIST HIGHWAY COMM. office.

City of LA CROSSE, LA CROSSE County.

Located or established by W R ARGALL, 1958

Title ENGP

County Clerk's Office \_\_\_\_\_ County, Wis. } ss

Received for record \_\_\_\_\_, 19\_\_\_\_

Copy sent to County Surveyor \_\_\_\_\_, 19\_\_\_\_

County Clerk

FORM NO. 710

**PRESERVATION OF LANDMARKS**

PAGE

SECTION 59,635(7) WISCONSIN STATUTES

COUNTY LA CROSSE

CITY LA CROSSE

TOWN LA CROSSE


HIGHWAY LOSEY BLVD.

SECTION NO. 9


T. 15 N., R. 7 E.

TYPE OF LANDMARK SE COR, SE 1/4-SW 1/4

LOCATION INDICATED ON SKETCH X

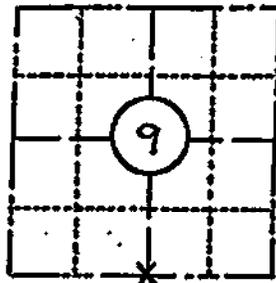

LOCATION SKETCH

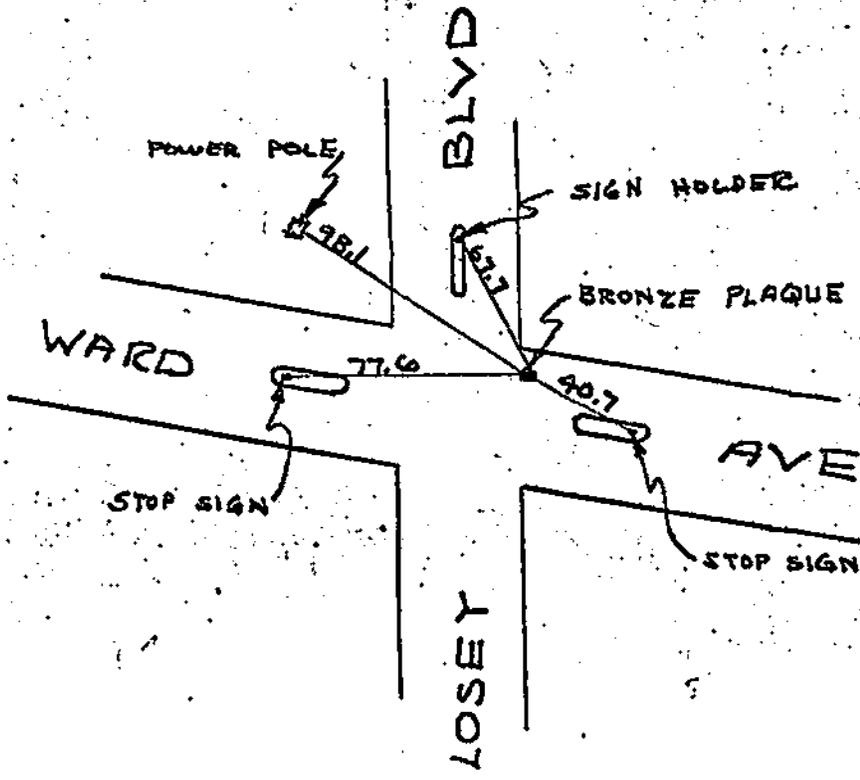

This space for copy of field notes or ties to the above described landmarks

Field notes or records filed in book no. 403 F (CENTERLINE BOOK)

at the DIST HIGHWAY COMM. office.

City of LA CROSSE, LA CROSSE County.

Located or established by H R ARGALL, 1958

Title ENGR

County Clerk's Office \_\_\_\_\_ County, Wis. } ss


Received for record \_\_\_\_\_, 19\_\_\_\_

Copy sent to County Surveyor \_\_\_\_\_, 19\_\_\_\_

County Clerk

# Tie Sheet, City of La Crosse

Section 16 Township 15 N Range 7 W

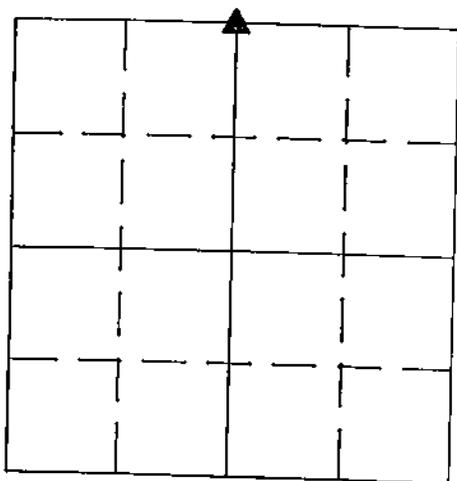

Project Section Corner  
 Sta No \_\_\_\_\_  
 Monument \_\_\_\_\_  
 Coord. System \_\_\_\_\_  
 North \_\_\_\_\_  
 East \_\_\_\_\_  
 Elev \_\_\_\_\_  
 Surveyor County

Comments:

Date \_\_\_\_\_

Space for copy of field notes or ties to above described monument:

