

## U. S. PUBLIC LAND SURVEY MONUMENT RECORD

SECTION 9, TOWNSHIP 15 NORTH, RANGE 7 WEST

CITY of LA CROSSE

LA CROSSE COUNTY, WISCONSIN


9

COORDINATE SYSTEM	
NORTHING	654,997.60
EASTING	1,649,178.67
THETA ANGLE	
HORIZ. ORDER	
VERT. ORDER	
BEARINGS ARE REFERENCED TO: Wisconsin South Zone	
TYPE OF MONUMENT 3/4" x 30" iron bar	

Describe any record evidence, monument evidence, testimonial evidence or any other material evidence you considered and whether the monument was found or restored through acceptance of an obliterated evidence location.

Jung set a nail & cap at this corner in 1983 and it has been used in later surveys. I found the nail and ties prior to street reconstruction. I reset this corner with a 3/4" bar upon completion of street project.

Describe or show any material discrepancy between the location of the restored corner and that of the corner previously restored or reestablished.


none known

October 12, 1998  
David Karl, RLS



REFERENCE TIES

#	DESCRIPTION	BEARING	DISTANCE
1	Center of manhole lid	NW	16.91'
2	Drill hole in base of sign	NE	50.12' (slope)
3	PK in 11" tree (ground level on sw side)	SE	53.03'
4	1" iron pipe	W	33.01"
5	RR spike	E	33.04"

PLAN VIEW OF REFERENCE TIES

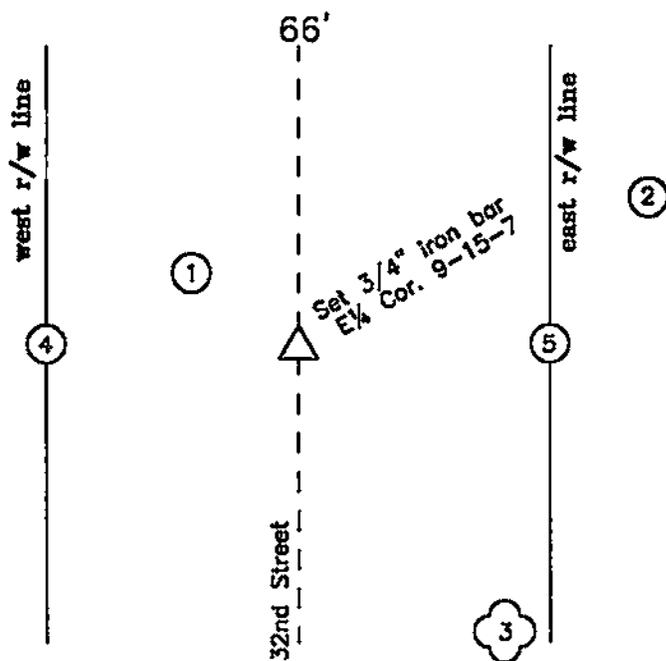

DISTANCE AND DIRECTION TO OTHER P.L.S.S. CORNERS USED

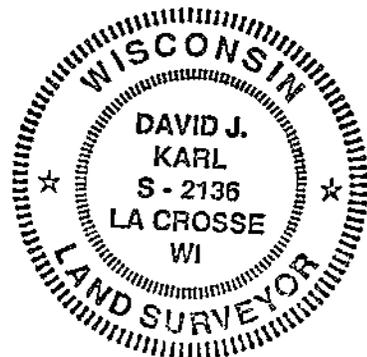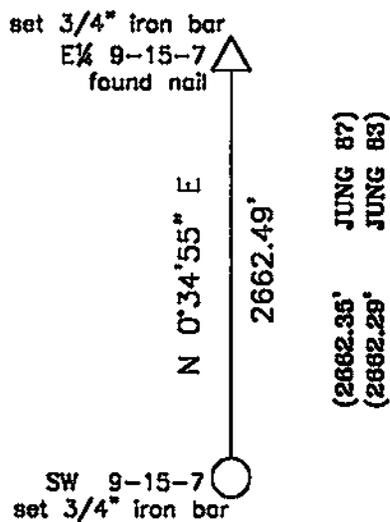

I, DAVID J. KARL, WISCONSIN REGISTERED LAND SURVEYOR #2136 CERTIFY THAT THE CORNER LOCATION SHOWN ON THIS RECORD WAS RESET OR DETERMINED BY ME OR UNDER MY DIRECTION AND CONTROL. I FURTHER CERTIFY THAT THIS DOCUMENT IS CORRECT AND COMPLETE TO THE BEST OF MY KNOWLEDGE.


1-26-99

*David J. Karl*

## U. S. PUBLIC LAND SURVEY MONUMENT RECORD

SECTION 9 T 15 N, R 7 W, <sup>City</sup> TOWN OF LaCrosse

LA CROSSE COUNTY

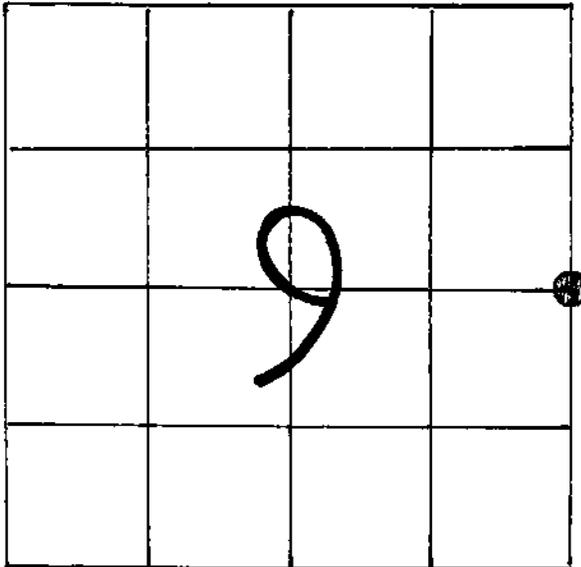

LOCATION OF LANDMARK

WISCONSIN COORDINATE SYSTEM

North

East

Theta Angle

Horiz. Order

Vert. Order

TYPE OF LANDMARK

Existing nail and cap

BEARINGS ARE REFERENCED TO

Crew: William C. Jung  
Peter F. Follansbee

Date: 8/26/97

Describe any record evidence, monument evidence, testimonial evidence or any other material evidence you considered and whether the monument was found or restored through acceptance of an obliterated evidence location.


I set a nail and cap at this corner in August of 1983. It has since been used as the corner by other surveyors. I set the corner using pipes that I found in the lots to the NW and SW.

Describe or show any material discrepancy between the location of the restored corner and that of the corner previously restored or reestablished.

None known.

RECORD OF DURABLE WITNESS MONUMENTS


NO	DESCRIPTION	BEARING	DISTANCE
1	To the center of a manhole	-----	16.91
2	To drill hole in the S. base of an office sign	-----	slope=50.12
3	To a railroad spike behind the sidewalk	-----	33.04
4	To a p.k. nail in an unblazed 11" tree	-----	53.025

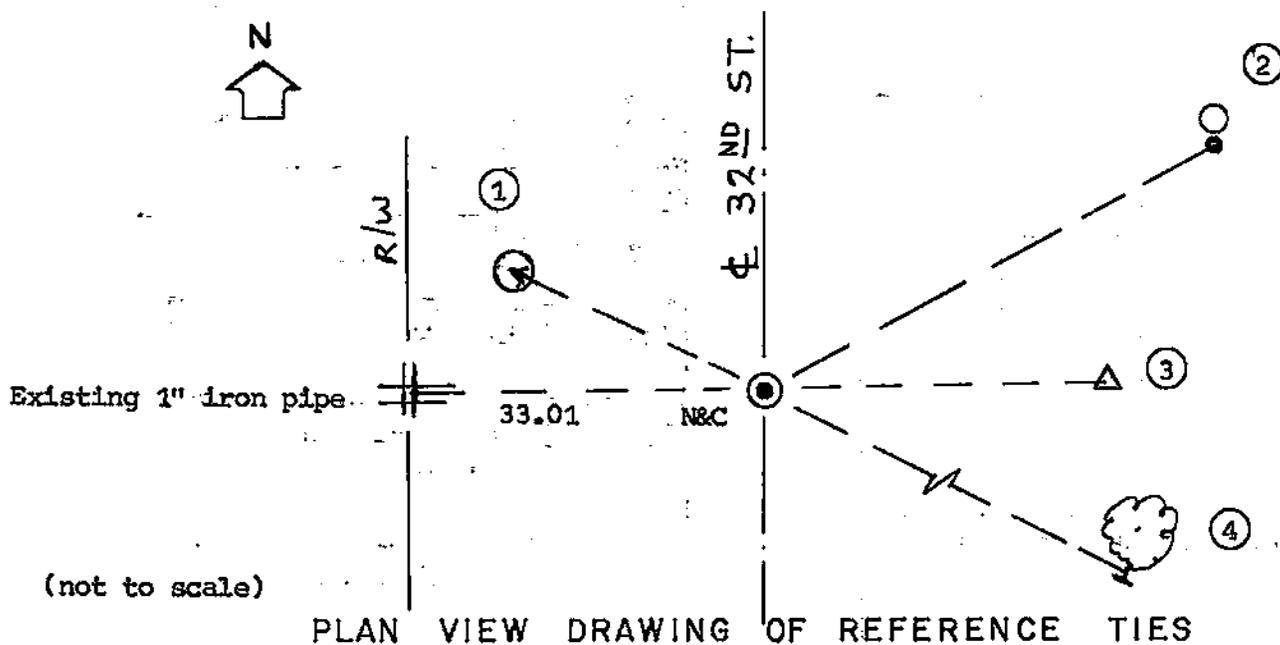

PLAN VIEW DRAWING OF REFERENCE TIES

MAP SHOWING DISTANCE AND DIRECTION TO OTHER PUBLIC LAND SURVEY CORNERS USED FOR REESTABLISHING THE CORNER

(not to scale)

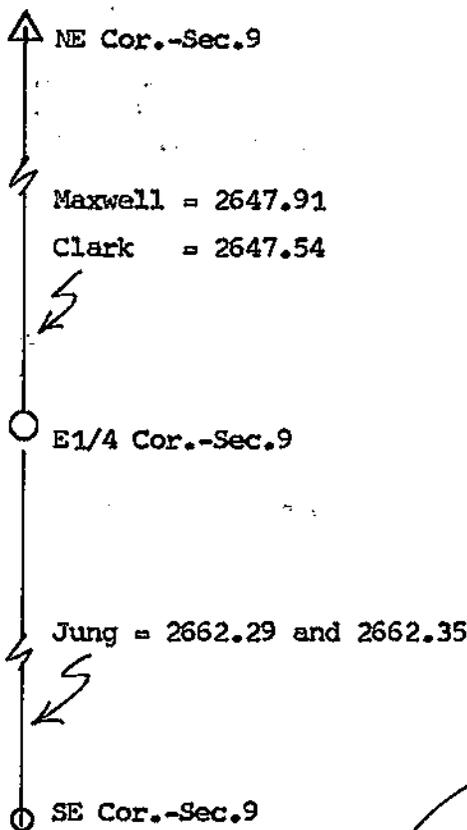

I, William C. Jung, County Surveyor  
 HEREBY CERTIFY THAT THE CORNER LOCATION SHOWN ON THIS RECORD  
 WAS DETERMINED BY ME OR UNDER MY DIRECTION AND CONTROL AND  
 THAT THIS U. S. PUBLIC LAND SURVEY MONUMENT RECORD IS CORRECT  
 AND COMPLETE TO THE BEST OF MY KNOWLEDGE AND BELIEF.

William C. Jung 2/10/98  
 Signature Date



Seal