


U. S. PUBLIC LAND SURVEY MONUMENT RECORD

SECTION 10 T 15 N, R 7 W, TOWN OF SHELBY

LA CROSSE COUNTY

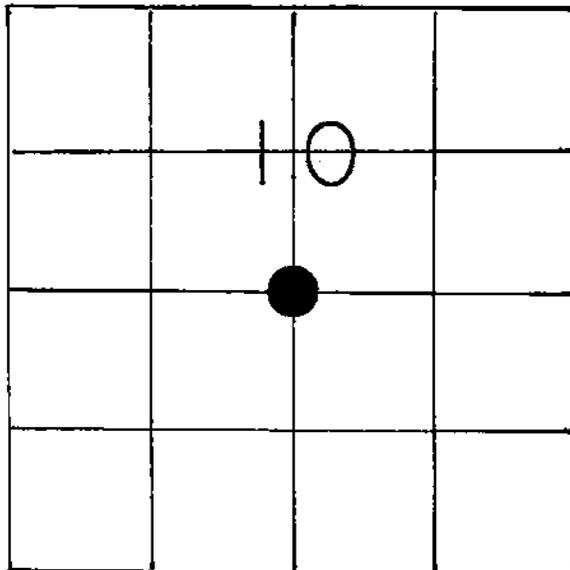

LOCATION OF LANDMARK

WISCONSIN COORDINATE SYSTEM

North

East

Theta Angle

Horiz. Order

Vert. Order

TYPE OF LANDMARK Corner is 0.03ft. N.

~~DRILL HOLE (10' So. OF CENTERLINE)~~ of PK

BEARINGS ARE REFERENCED TO & cap

ASSUMED BEARINGS

CREW: WILLIAM C. JUNG
 PETER F. FOLLANSBEE
 9-04-1987

Crew: William C. Jung
 Peter F. Follansbee
 6-26-95 and 4-17-96 and 4/28/00

Describe any record evidence, monument evidence, testimonial evidence or any other material evidence you considered and whether the monument was found or restored through acceptance of an obliterated evidence location.

Fred Kraft shows a drill hole at this corner 10' South of the centerline. DOT R/W maps also show this corner as being 10' South of the centerline as does the plat of Wedgewood Terrace Addition. I found this drill hole at the corner. Steve Solberg and I both have since used the drill hole as the Center 1/4 Corner for surveys that we are doing to the South.

1-3-97: This drill hole has repeatedly been used as the C1/4 corner over the years.


Describe or show any material discrepancy between the location of the restored corner and that of the corner previously restored or reestablished.

In 1980 Joe Murphy shows a 60D spike at the corner. I found a spike 2.4' West of the drill hole. I do not know if this drill hole is at the intersection of the 1/4 lines. The drill hole in my opinion must be used as the Center 1/4 Corner however as it has been used as such in many surveys. It also fits the occupied line to the South very well.

4/28/00: The drill hole was covered by asphalt overlay during recent construction. Set a P.K. nail and cap 0.03 ft. South of the actual corner.

RECORD OF DURABLE WITNESS MONUMENTS
MAGNETIC

NO	DESCRIPTION	BEARING	DISTANCE
1	EXIST. HOLE IN CONCRETE (survey point only)	N 87 W	44.34 Ft.
2	CENTER OF MANHOLE COVER	N 05 E	61.97 Ft.
3	CENTER OF MANHOLE COVER	S 53 E	48.97 Ft. 18.9'
4	EXISTING 1 3/4" IRON PIPE (FLUSH) UNDER WALK NEW BAR IN	S 04 E	39.88 Ft. 40.15'
5	NEW NE CORNER OF IRON CATCH BASIN GRATE	S 52 W	25.83 Ft. 27.02'

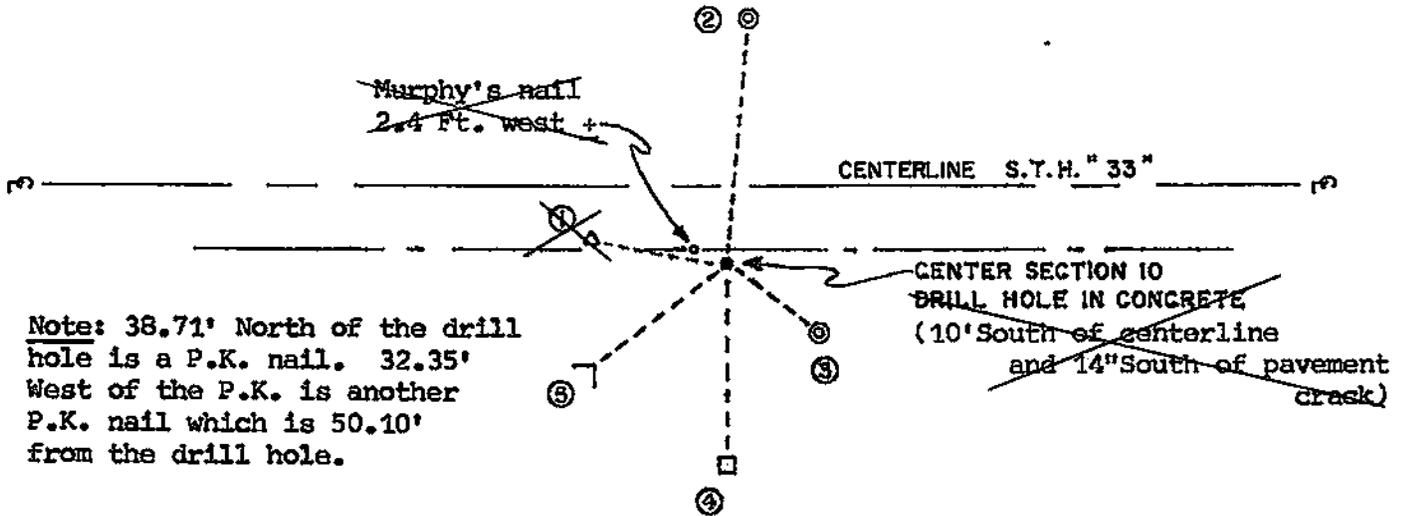


(not to scale)

PLAN VIEW DRAWING OF REFERENCE TIES

MAP SHOWING DISTANCE AND DIRECTION TO OTHER PUBLIC LAND SURVEY CORNERS USED FOR REESTABLISHING THE CORNER

(NOT TO SCALE)

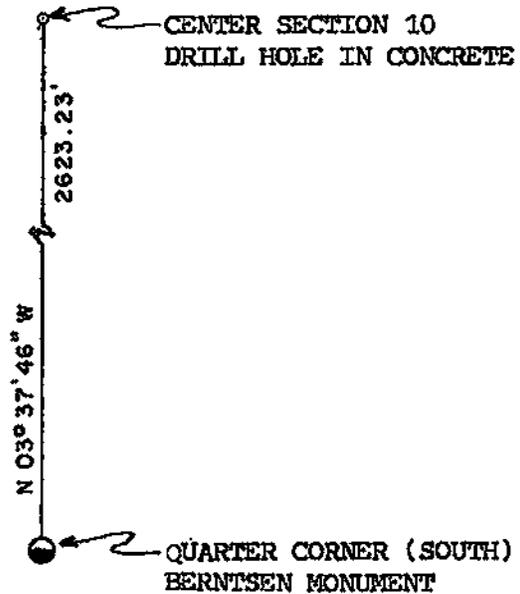


I, WILLIAM C. JUNG
HEREBY CERTIFY THAT THE CORNER LOCATION SHOWN ON THIS RECORD
WAS DETERMINED BY ME OR UNDER MY DIRECTION AND CONTROL AND
THAT THIS U. S. PUBLIC LAND SURVEY MONUMENT RECORD IS CORRECT
AND COMPLETE TO THE BEST OF MY KNOWLEDGE AND BELIEF.

William C. Jung Deputy County Surveyor, January 7, 1988
Signature Date

Revised: 1/3/97 *wej*
" 12/28/00 *wej*



Seal

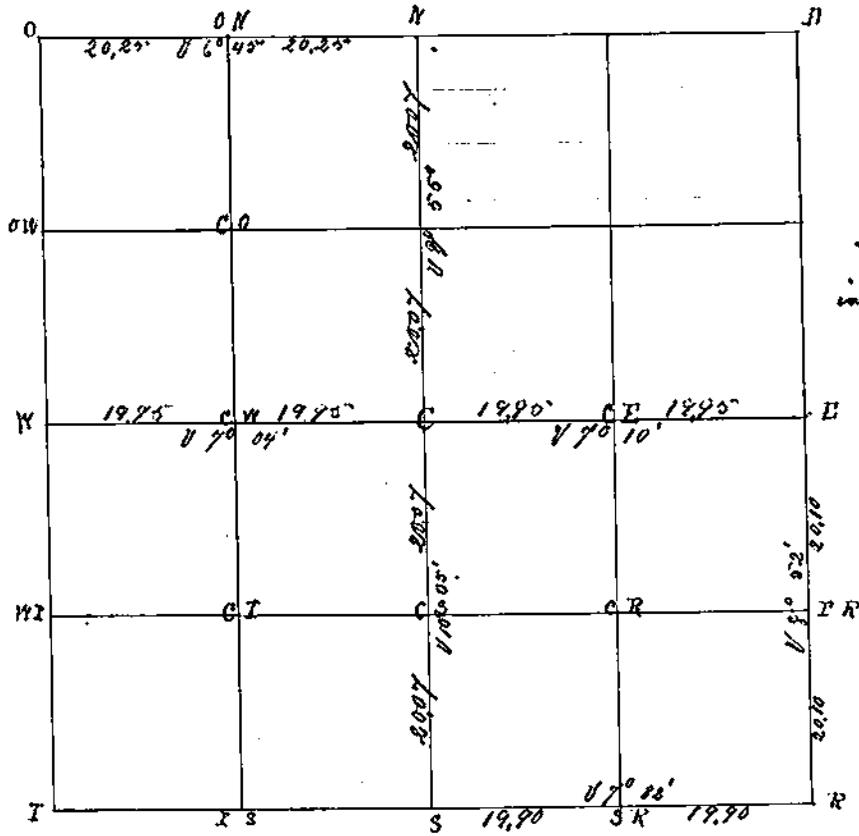

Feb. 26th 1878

Ran from O to W, S to N, C to E, S to R, O to N, C to W, O to N,

- Corner
- .C
- C.S.
- C.W.
- C.O.
- O.N.
- C.E.
- C.R.
- S.R.
- E.R.

- Oak & S 74 1/2° E 77
- " " 6 8 41 1/2° W 58
- Stake
- Stake
- Stake
- Stake + { Hard W. oak 14 x 8 N 20° W 23
- " " 12 8 8 3/4 W 32
- Stake
- Stake
- Stake + Hickory & S 47 1/4° E 166
- Stake

Jos. P. Paradise & Co. Surveyors