


21507110000

U. S. PUBLIC LAND SURVEY MONUMENT RECORD

SECTION 12 T 15 N, R 7 W, TOWN OF SHELBY

LA CROSSE COUNTY

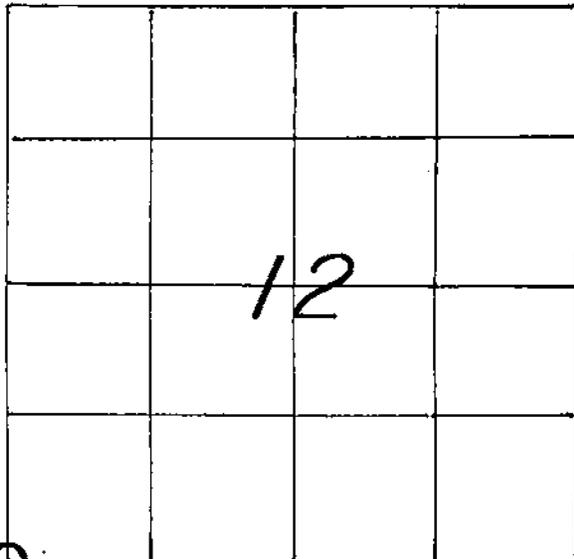

WISCONSIN COORDINATE SYSTEM

North

East

Theta Angle

Horiz. Order

Vert. Order

TYPE OF LANDMARK

EXISTING 2-1/2" IRON PIPE.

BEARINGS ARE REFERENCED TO

LOCATION OF LANDMARK

CREW: *WILLIAM C. JUNG**PETER F. FOLLANSBEE*DATE: *6/29/1998*

Describe any record evidence, monument evidence, testimonial evidence or any other material evidence you considered and whether the monument was found or restored through acceptance of an obliterated evidence location.

I found an existing iron pipe at the corner. This pipe had been used in previous survey work. I accepted it as the best available evidence of the original government corner position.


Describe or show any material discrepancy between the location of the restored corner and that of the corner previously restored or reestablished.

None known.

RECORD OF DURABLE WITNESS MONUMENTS

| NO | DESCRIPTION | MAGNETIC | |
|----|----------------------------------|----------|-----------|
| | | BEARING | DISTANCE |
| 1 | NAIL IN S.-SIDE 10" BURR OAK | S 85° W | 23.37 FT. |
| 2 | NAIL IN S.E.-SIDE 7-1/2" HICKORY | N 55° E | 10.73 FT. |
| 3 | NAIL IN N.E.-SIDE 9" WHITE OAK | S 37° E | 42.11 FT. |
| 4 | NAIL IN W.-SIDE 17" WHITE OAK | S 21° E | 54.77 FT. |

(NOT TO SCALE)

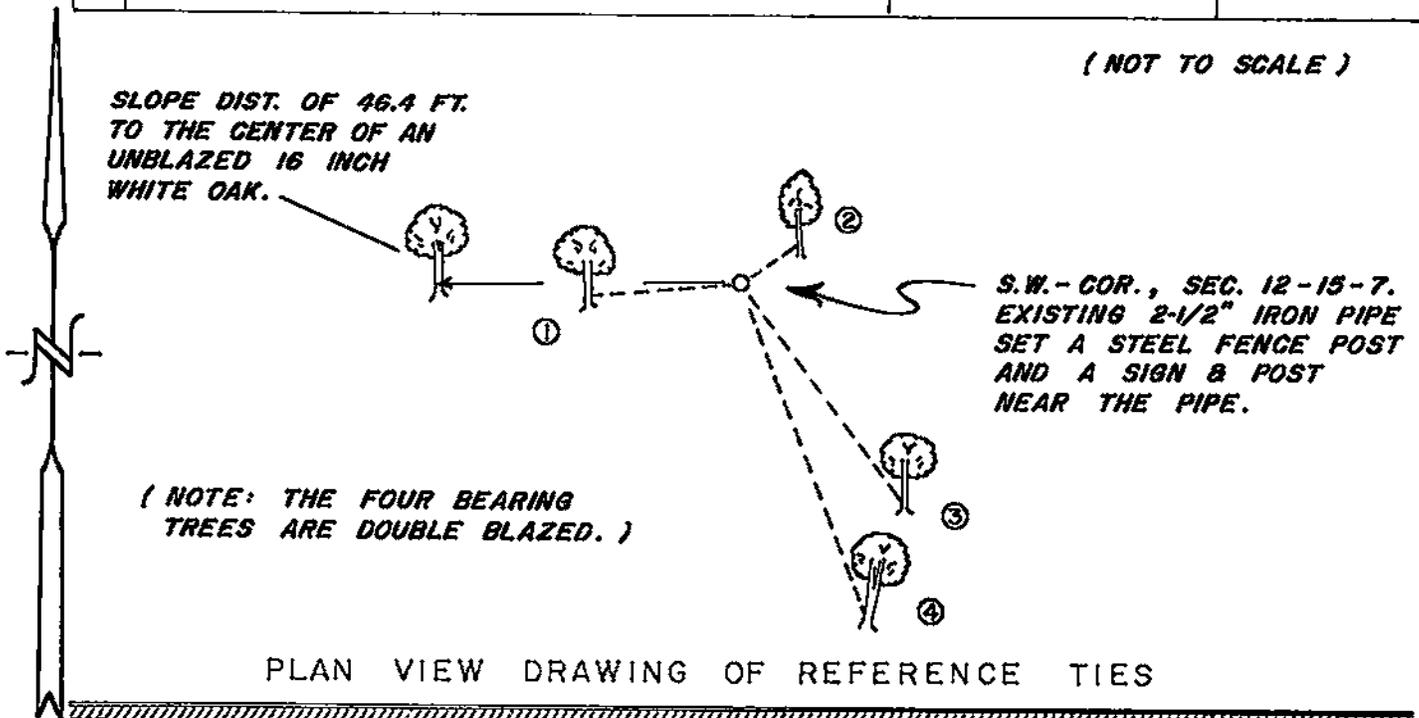

MAP SHOWING DISTANCE AND DIRECTION TO OTHER PUBLIC LAND SURVEY CORNERS USED FOR REESTABLISHING THE CORNER

No section measurements were made by me at this time. The position of this corner was confirmed by others with previous survey work.

I, WILLIAM C. JUNG, COUNTY SURVEYOR
 HEREBY CERTIFY THAT THE CORNER LOCATION SHOWN ON THIS RECORD WAS DETERMINED BY ME OR UNDER MY DIRECTION AND CONTROL AND THAT THIS U. S. PUBLIC LAND SURVEY MONUMENT RECORD IS CORRECT AND COMPLETE TO THE BEST OF MY KNOWLEDGE AND BELIEF.

William C. Jung 1/13/99
 Signature Date



Seal