


21507112000

U. S. PUBLIC LAND SURVEY MONUMENT RECORD

SECTION 12 T 15 N, R 7 W, TOWN OF SHELBY

LA CROSSE COUNTY

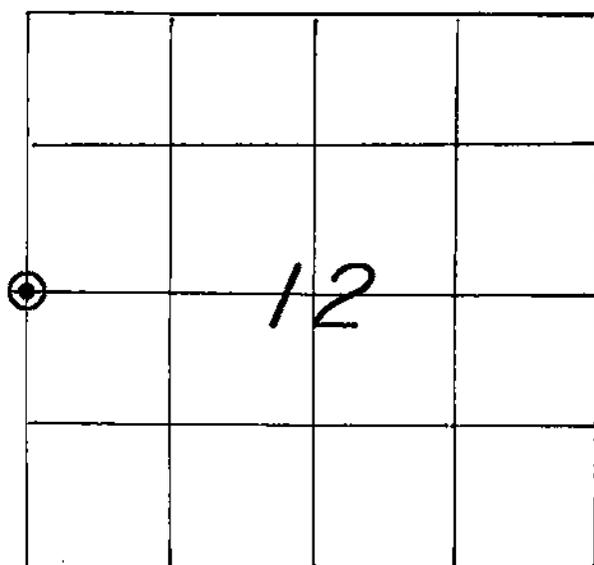

WISCONSIN COORDINATE SYSTEM

North

East

Theta Angle

Horiz. Order

Vert. Order

TYPE OF LANDMARK

3/4" x 30" I.B. WITH ALUM. CAP IN EX. I.P.

BEARINGS ARE REFERENCED TO

LOCATION OF LANDMARK

CREW: *WILLIAM C. JUNG**PETER F. FOLLANSBEE*DATE: *6/29/1998*

Describe any record evidence, monument evidence, testimonial evidence or any other material evidence you considered and whether the monument was found or restored through acceptance of an obliterated evidence location.

I found an existing iron pipe at the corner. This pipe had been used in previous survey work. I accepted it as the best available evidence of the original government corner position. After plumbing the pipe up, I set a 3/4" iron bar with cap inside of it and mounded the corner up.


Describe or show any material discrepancy between the location of the restored corner and that of the corner previously restored or reestablished.

None known.

RECORD OF DURABLE WITNESS MONUMENTS

MAGNETIC

NO	DESCRIPTION	BEARING	DISTANCE
1	REMOVED AND RESET EX. PK. IN N.E.-SIDE 6-1/2" HICKORY	N 50° W	31.20 FT.
2	TOP OF EXISTING IRON PIPE, UP 11"	N 88° E	SL. = 64.20'
3	NAIL IN W.-SIDE 12-1/2" NUT TREE	S 02° W	24.77 FT.
4	NAIL IN N.W.-SIDE 13-1/2" OAK	S 69° W	16.94 FT.

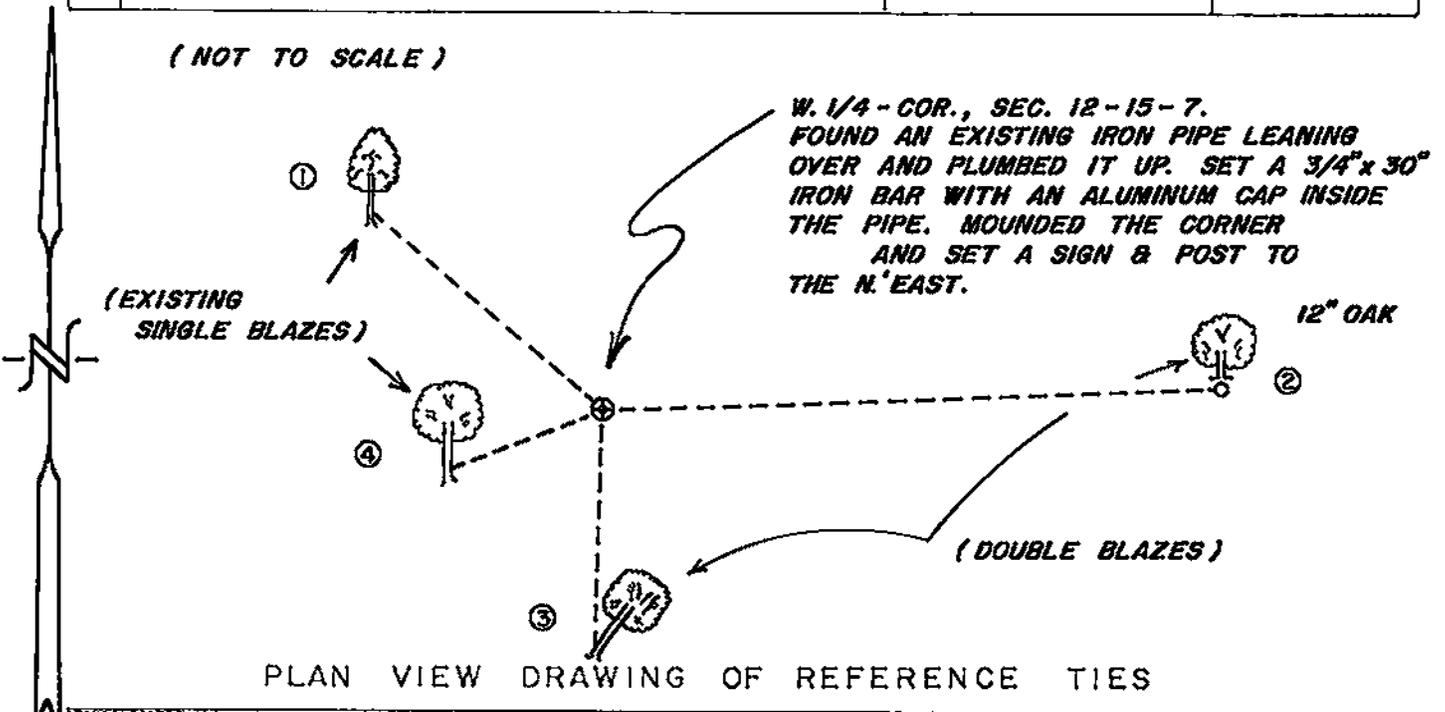


MAP SHOWING DISTANCE AND DIRECTION TO OTHER PUBLIC LAND SURVEY CORNERS USED FOR REESTABLISHING THE CORNER

No section measurements were made by me at this time. The position of this corner was confirmed by others with previous survey work.

I, WILLIAM C. JUNG, COUNTY SURVEYOR
 HEREBY CERTIFY THAT THE CORNER LOCATION SHOWN ON THIS RECORD
 WAS DETERMINED BY ME OR UNDER MY DIRECTION AND CONTROL AND
 THAT THIS U. S. PUBLIC LAND SURVEY MONUMENT RECORD IS CORRECT
 AND COMPLETE TO THE BEST OF MY KNOWLEDGE AND BELIEF.

William C. Jung 1/ 13/99
 Signature Date

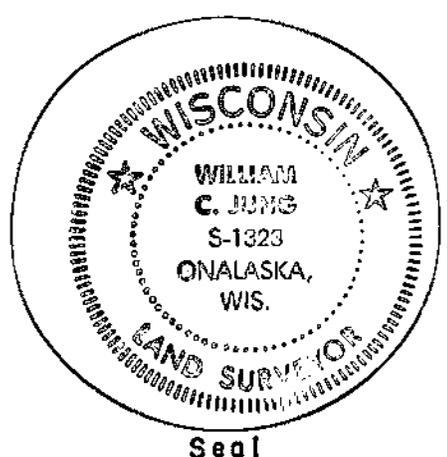

Seal