


21507120020

## U. S. PUBLIC LAND SURVEY MONUMENT RECORD

SECTION 12 T 15 N, R 7 W, TOWN OF SHELBY

LA CROSSE COUNTY

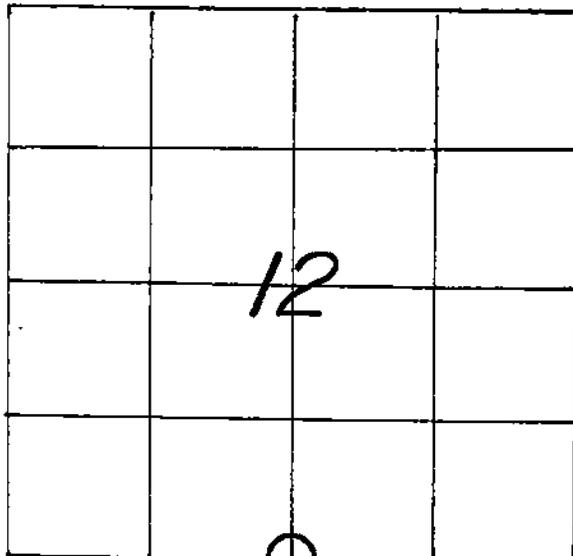

LOCATION OF LANDMARK

CREW: WILLIAM C. JUNG  
 PETER F. FOLLANSBEE  
 DATE: 9/15/2008

WISCONSIN COORDINATE SYSTEM	
North	652,054.7 ±
East	1,662,292.9 ±
Theta Angle	
Horiz. Order	
Vert. Order	
DATUM:	1983('91)
TYPE OF LANDMARK	
1" O.D. IRON PIPE.	
BEARINGS ARE REFERENCED TO	
GRID NORTH AS PER SECTION DATA.	

Describe any record evidence, monument evidence, testimonial evidence or any other material evidence you considered and whether the monument was found or restored through acceptance of an obliterated evidence location.


Gary Watts set an iron pipe at this corner in 1981. I accepted his pipe as the corner and tied it off.

Describe or show any material discrepancy between the location of the restored corner and that of the corner previously restored or reestablished.

**NONE KNOWN.**


RECORD OF DURABLE WITNESS MONUMENTS

NO	DESCRIPTION	MAGNETIC	
		BEARING	DISTANCE
1	SET A NAIL IN N.W.-SIDE OF A 15-1/2" ASH	S 83° W	SLOPE = 56.87'
2	SET A NAIL IN E.-SIDE OF AN 11" BASSWOOD	N 23° W	40.02 FT.
3	SET A NAIL IN S.W.-SIDE OF AN 11" BOX ELDER	S 71° E	34.91 FT.
4	SET A NAIL IN N.E.-SIDE OF A 6-1/2" BASSWOOD	S 45° E	44.20 FT.

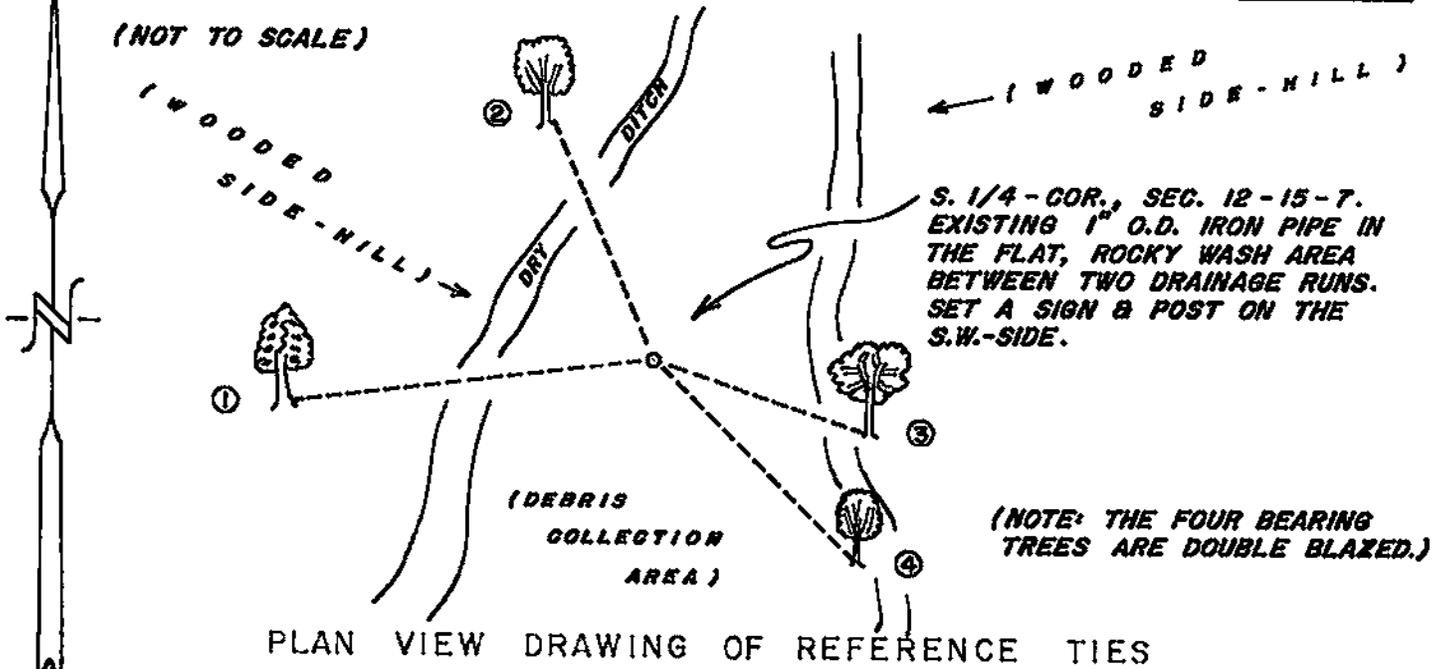

MAP SHOWING DISTANCE AND DIRECTION TO OTHER PUBLIC LAND SURVEY CORNERS USED FOR REESTABLISHING THE CORNER

± (GRID BEARINGS AND DISTANCES)  
 (G.A. WATTS MEASUREMENTS)  
 (NOT TO SCALE)

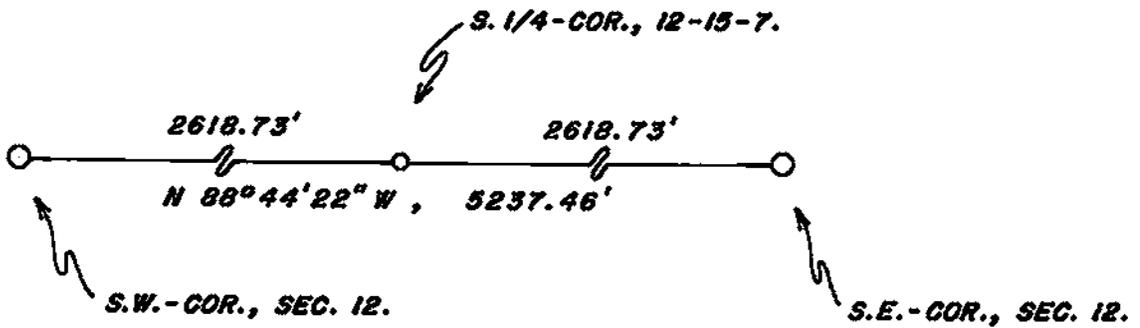

I, WILLIAM C. JUNG, COUNTY SURVEYOR  
 HEREBY CERTIFY THAT THE CORNER LOCATION SHOWN ON THIS RECORD  
 WAS DETERMINED BY ME OR UNDER MY DIRECTION AND CONTROL AND  
 THAT THIS U. S. PUBLIC LAND SURVEY MONUMENT RECORD IS CORRECT  
 AND COMPLETE TO THE BEST OF MY KNOWLEDGE AND BELIEF.

William C. Jung                      10/29/08  
 Signature                                      Date



Seal