


U. S. PUBLIC LAND SURVEY MONUMENT RECORD

SECTION 12 T 15 N, R 7 W, TOWN OF SHELBY

LA CROSSE COUNTY

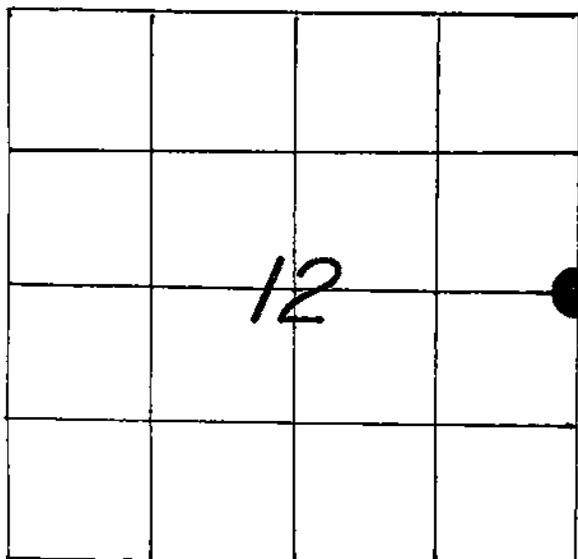

WISCONSIN COORDINATE SYSTEM
North
East
Theta Angle
Horiz. Order
Vert. Order
TYPE OF LANDMARK
<i>1/4" IRON BAR.</i>
BEARINGS ARE REFERENCED TO

LOCATION OF LANDMARK

CREW: *WILLIAM C. JUNG*  
*PETER F. FOLLANSBEE*  
 DATE: *3/09/2005*

Describe any record evidence, monument evidence, testimonial evidence or any other material evidence you considered and whether the monument was found or restored through acceptance of an obliterated evidence location.

Gary Watts set an iron pipe at this corner in 1981. It was then used as the corner in subsequent surveys done by Watts and others. The pipe falls in a gully or washout and apparently fell victim to erosion. Paul Fairchild set an iron bar at Watts' old location. I agree with <sup>this</sup> corner location and tied off Fairchild's iron bar.

Describe or show any material discrepancy between the location of the restored corner and that of the corner previously restored or reestablished.

None known.

