


21507130000

U. S. PUBLIC LAND SURVEY MONUMENT RECORD

SECTION 24 T 15 N, R 7 W, TOWN OF SHELBY

LA CROSSE COUNTY

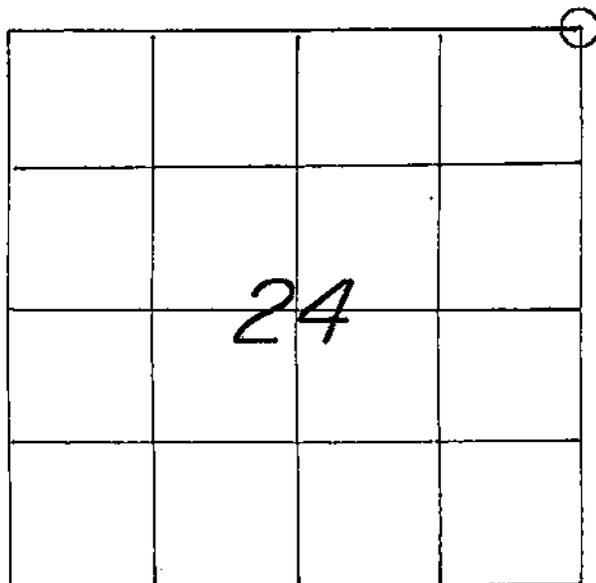

LOCATION OF LANDMARK

CREW: WILLIAM C. JUNG
 PETER F. FOLLANSBEE
 DATE: 6/14/1999

83(91)

WISCONSIN COORDINATE SYSTEM	
North	646,758.799
East	1,664,827.750
Theta Angle	
Horiz. Order	
Vert. Order	
TYPE OF LANDMARK	
EXISTING 3" IRON PIPE.	
BEARINGS ARE REFERENCED TO	
Grid	

Describe any record evidence, monument evidence, testimonial evidence or any other material evidence you considered and whether the monument was found or restored through acceptance of an obliterated evidence location.


We found an existing iron pipe at the occupied fence corner. This pipe had been used as the corner in many previous surveys. I accepted the pipe as the best available evidence of the original government survey.

Describe or show any material discrepancy between the location of the restored corner and that of the corner previously restored or reestablished.


NONE KNOWN.

RECORD OF DURABLE WITNESS MONUMENTS

NO	DESCRIPTION	BEARING	DISTANCE
1	SET A R.K. NAIL IN S.E.-SIDE OF A 5" TREE	N.°EASTERLY ±	6.53 FT.
2	SET A NAIL IN S.-SIDE OF A SMALL ELM	EAST ±	16.15 FT.
3	EXISTING IRON PIPE WITH HOFMEISTER'S PLUG	EAST ±	25.51 FT.
4	EXISTING IRON PIPE WITH HOFMEISTER'S PLUG	SOUTH ±	25.25 FT.

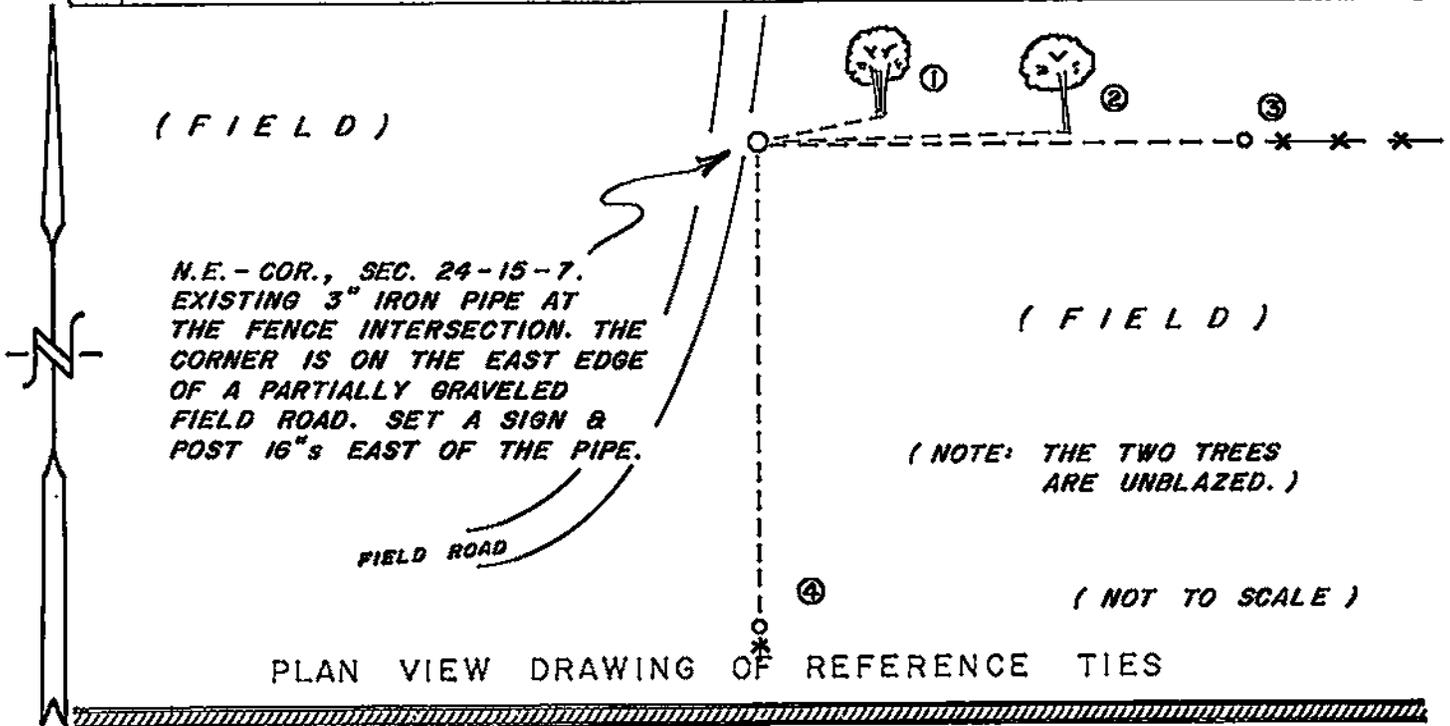

MAP SHOWING DISTANCE AND DIRECTION TO OTHER PUBLIC LAND SURVEY CORNERS USED FOR REESTABLISHING THE CORNER (not to scale)

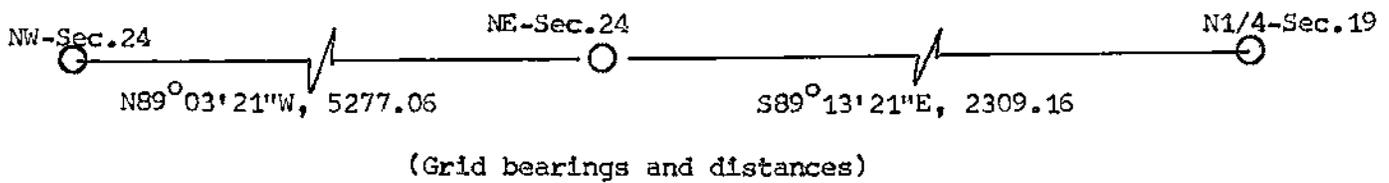

I, WILLIAM C. JUNG, COUNTY SURVEYOR
HEREBY CERTIFY THAT THE CORNER LOCATION SHOWN ON THIS RECORD
WAS DETERMINED BY ME OR UNDER MY DIRECTION AND CONTROL AND
THAT THIS U. S. PUBLIC LAND SURVEY MONUMENT RECORD IS CORRECT
AND COMPLETE TO THE BEST OF MY KNOWLEDGE AND BELIEF.

William C. Jung 2/1/00
Signature Date



Seal