


**21507142000**

U. S. PUBLIC LAND SURVEY MONUMENT RECORD

SECTION 13 T 15 N, R 7 W, TOWN OF SHELBY  
 LA CROSSE COUNTY

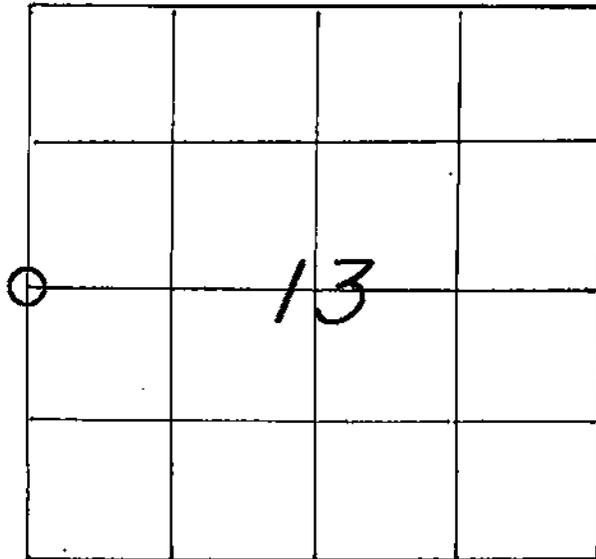

WISCONSIN COORDINATE SYSTEM
North
East
Theta Angle
Horiz. Order
Vert. Order
TYPE OF LANDMARK EXISTING 1-1/2" IRON PIPE.
BEARINGS ARE REFERENCED TO

LOCATION OF LANDMARK

CREW: WILLIAM C. JUNG  
 PETER F. FOLLANSBEE  
 DATE: 6/30/1998

Describe any record evidence, monument evidence, testimonial evidence or any other material evidence you considered and whether the monument was found or restored through acceptance of an obliterated evidence location.


I found an existing iron pipe at the old occupied fence corner. This pipe had been used in previous survey work. I accepted it as the best available evidence of the original government corner position.

Describe or show any material discrepancy between the location of the restored corner and that of the corner previously restored or reestablished.

None known.

RECORD OF DURABLE WITNESS MONUMENTS  
MAGNETIC

NO	DESCRIPTION	BEARING	DISTANCE
1	NAIL IN THE N.-SIDE 18" NUT TREE P	N 81° W	27.91 FT.
2	RESET A P.K. NAIL IN S.W.-SIDE 27" OAK	NORTH ±	15.98 FT.
3	NAIL IN THE N.E.-SIDE 11-1/2" OAK	S 46° E	31.84 FT.
4	NAIL IN THE N.E.-SIDE 14" CHERRY	S 08° E	36.70 FT.

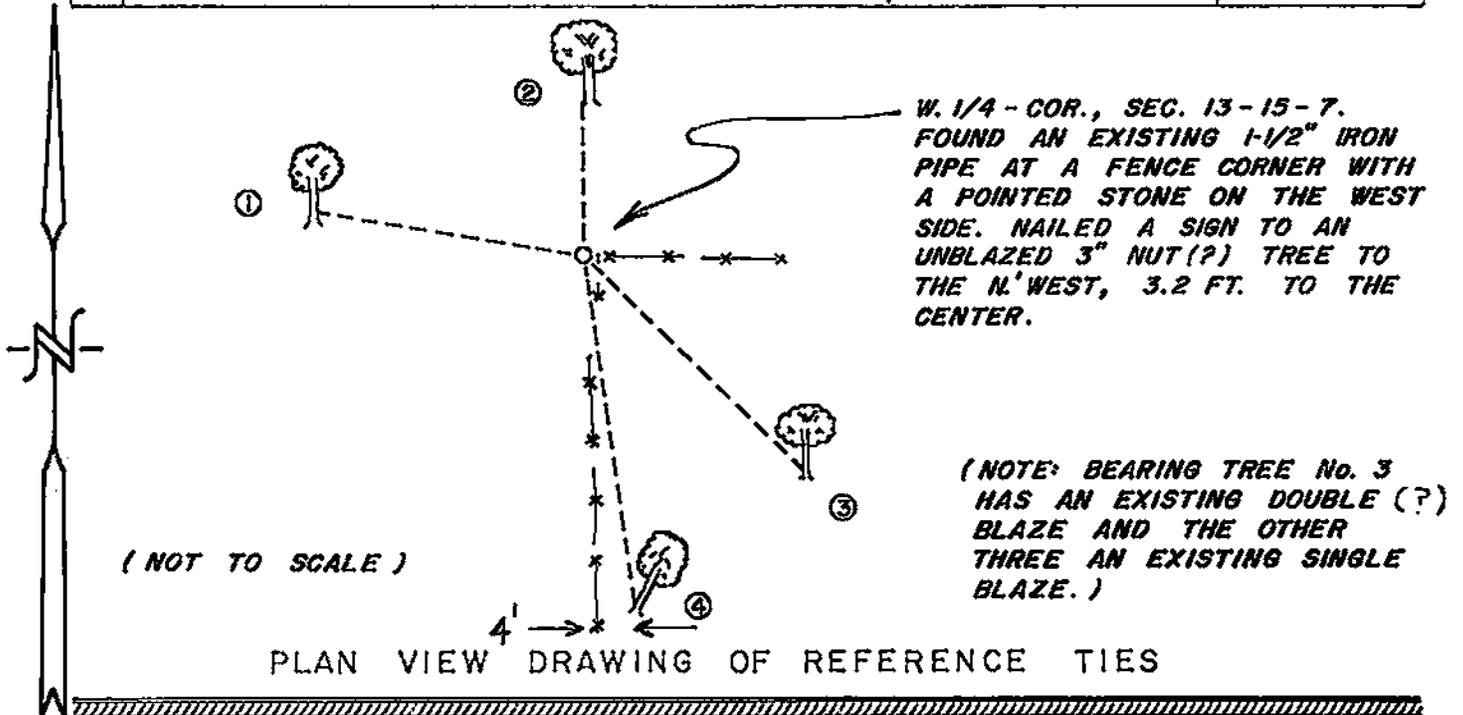


MAP SHOWING DISTANCE AND DIRECTION TO OTHER PUBLIC LAND SURVEY CORNERS USED FOR REESTABLISHING THE CORNER

No section measurements were made by me at this time. The position of this corner was confirmed by others with previous survey work.

I, WILLIAM C. JUNG, COUNTY SURVEYOR  
HEREBY CERTIFY THAT THE CORNER LOCATION SHOWN ON THIS RECORD WAS DETERMINED BY ME OR UNDER MY DIRECTION AND CONTROL AND THAT THIS U. S. PUBLIC LAND SURVEY MONUMENT RECORD IS CORRECT AND COMPLETE TO THE BEST OF MY KNOWLEDGE AND BELIEF.

William C. Jung 1/13/99  
Signature Date

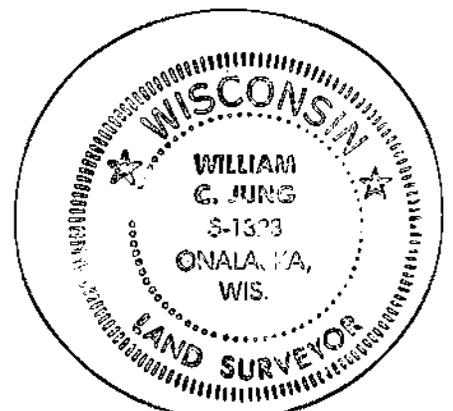

Seal