

RECEIVED
 JUL 20 2005
 COUNTY SURVEYOR'S OFFICE

LA CROSSE COUNTY CERTIFIED U.S. PUBLIC LAND SURVEY MONUMENT RECORD

INSTRUCTIONS: THIS RECORD SHALL SHOW THE LOCATION OF THE CORNER AND SHALL INCLUDE ALL OF THE FOLLOWING ELEMENTS (A-I)

(A) IDENTIFY THE CORNER BY REFERENCE TO THE U.S. PUBLIC LAND SURVEY SYSTEM

■ = CORNER MONUMENT RESTORED

WITNESSES TO CORNER LOCATION:

- 1) Robert M. Lampman
- 2) Jessica A. Zamor

WIS. STATE PLANE GRID COORDINATES - NAD83(1991) - SURVEY FEET


NORTHING: 646991.781
 EASTING: 1661644.879

GEOGRAPHIC COORDINATES - WGS84/GRS80 - NAD83(1991)

Lat: 43°46'07.98978" N
 Lon: 91°11'58.44469" W

LA CROSSE COUNTY GRID COORDINATES - NAD83(1991) - SURVEY FEET

NORTHING: 115859.559
 EASTING: 458934.076

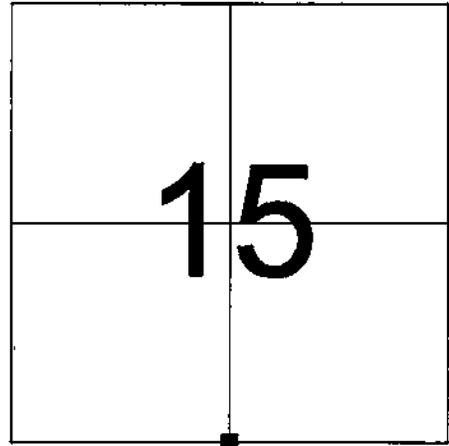

SECTION 15
 TOWN 15 NORTH, RANGE 7 WEST

(B) DESCRIBE ANY RECORD EVIDENCE, MONUMENT EVIDENCE, OCCUPATIONAL EVIDENCE, TESTIMONIAL EVIDENCE OR ANY OTHER MATERIAL EVIDENCE YOU CONSIDERED, AND WHETHER THE MONUMENT WAS FOUND OR PLACED.

Found an existing 60 penny nail at the section corner. The found nail matched with information from Gregory J. Hofmeister's subdivision of Section 22 as shown on a Certified Survey Map prepared by Mr. Hofmeister in 1979. Located existing monuments set by Hofmeister at the NE corner of Section 22 and the NW Corner of the NE 1/4 of the NE 1/4 of Section 22. The found nail matched these monuments such that the existing forty corner monument fell on line and half way between the nail and the NE corner of Section 22. Hofmeister recorded the distance along the North line of the NE 1/4 of the NE 1/4 of Section 22 at 1332.63 feet. The measured distance between the NE corner of Section 22 and the found spike was 2685.20 feet (LaCrosse County Grid).

A tall 2" iron pipe was also found lying on the ground west of the nail. It seems likely that the 2" iron pipe formerly existed at the section corner and was the monument located by Hofmeister at the time of his survey. The 60 penny nail apparently represented another surveyor's attempt to reestablish the location of the disturbed pipe.


Accepted the location of the found nail as the best available evidence of the original government corner location. Replaced said nail with an aluminum capped 3/4" x 30" iron bar as shown below.

(C) IN THE PLAN VIEW DRAWING BELOW, PROVIDE REFERENCE TIES TO AT LEAST 4 WITNESS MONUMENTS OR, IF THE LOCATION IS WITHIN A MUNICIPALITY, TO AT LEAST 2 WITNESS MONUMENTS. (WITNESS MONUMENTS SHALL BE MADE OF CONCRETE, NATURAL STONE, IRON, OR OTHER EQUALLY DURABLE MATERIAL.) DESCRIBE WITNESS MONUMENTS.

(D) SHOW A PLAN VIEW DRAWING, DEPICTING THE RELEVANT MONUMENTS AND REFERENCE TIES, WHICH IS SUFFICIENTLY DETAILED TO ENABLE ACCURATE RELOCATION OF THE CORNER MONUMENT IF IT IS DISTURBED.

LEGEND

- SET 3/4" X 30" ROUND IRON BAR WITH ALUMINUM CAP AT SECTION CORNER LOCATION
- SET 3/4" x 24" ROUND IRON BAR AS WITNESS MONUMENT

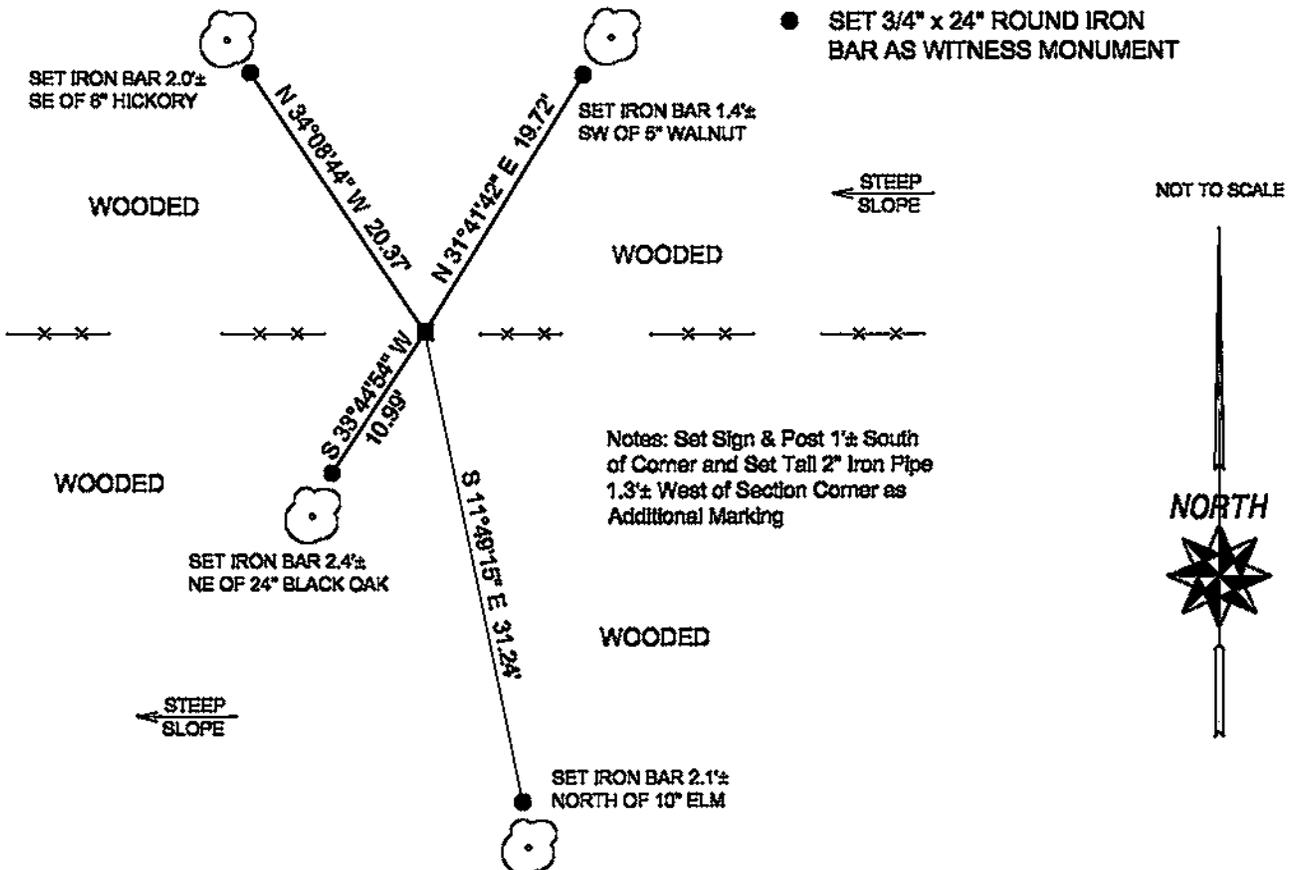

(E) DESCRIBE ANY MATERIAL DISCREPANCY BETWEEN THE LOCATION OF THE CORNER AS RESTORED OR REESTABLISHED AND THE LOCATION OF THAT CORNER AS PREVIOUSLY RESTORED OR REESTABLISHED BY DISTANCE AND DIRECTION. SHOW THE DISCREPANCY ON THE PLAN VIEW DRAWING UNDER (D), ABOVE. SHOW THE DISTANCES BETWEEN THE CORNER AS PREVIOUSLY RESTORED OR REESTABLISHED AND (1) THE CORNER AS RESTORED OR REESTABLISHED, AND (2) TO AT LEAST 2 OF THE WITNESS MONUMENTS AS SHOWN ON THE DRAWING IN (D), ABOVE.

N/A

(F) WAS THE CORNER RESTORED THROUGH ACCEPTANCE OF (1) AN OBLITERATED EVIDENCE LOCATION, OR (2) A FOUND PERPETUATED LOCATION?

(1) A FOUND PERPETUATED LOCATION

(G & H) WAS THE CORNER REESTABLISHED THROUGH LOST CORNER PROPORTIONATE METHODS? IF SO SHOW THE METHOD, INCLUDING THE DIRECTIONS AND DISTANCES TO OTHER PUBLIC LAND SURVEY CORNERS USED AS EVIDENCE OR USED FOR PROPORTIONING IN DETERMINING THE CORNER LOCATION.

N/A

(**) ANY ADDITIONAL INFORMATION RELATED TO CORNER LOCATION

CORNER HISTORY:

- Original government corner location established by A.L.Brown in 1846.
- At least one older subdivision plat in Section 22 calls for a 2" iron pipe at the section corner location.
- Gregory J. Hofmeister subdivided Section 22 in 1979.

(I) I, JESSICA A. ZAMOR, CERTIFY THAT THE LOCATION SHOWN ON THIS RECORD WAS DETERMINED BY ME OR UNDER MY DIRECTION AND CONTROL AND THAT THIS U.S. PUBLIC LAND SURVEY MONUMENT RECORD IS CORRECT AND COMPLETE TO THE BEST OF MY KNOWLEDGE AND BELIEF.

Jessica A. Zamor
SIGNATURE

7-16-2005
DATE

AFFIX LAND SURVEYOR SEAL

