


21507152000

U. S. PUBLIC LAND SURVEY MONUMENT RECORD

SECTION 14 T 15 N, R 7 W, TOWN OF Shelby

LA CROSSE COUNTY

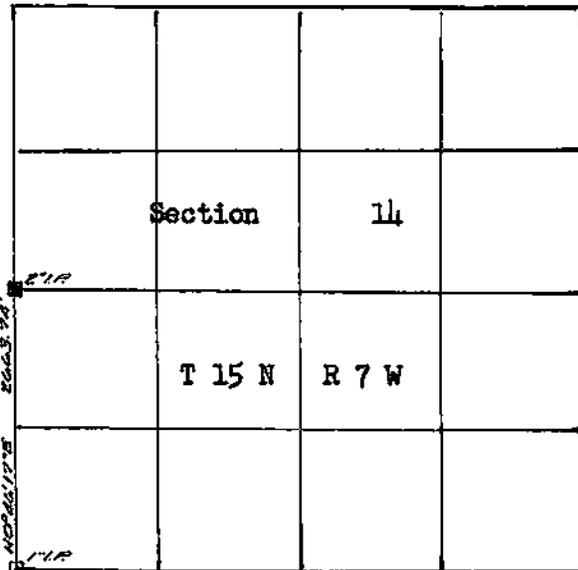

LOCATION OF LANDMARK

WISCONSIN COORDINATE SYSTEM

North

East

Theta Angle

Horiz. Order

Vert. Order

TYPE OF LANDMARK

West 1/4 Corner (2" Iron Pipe)

BEARINGS ARE REFERENCED TO
the west line of the SW 1/4

Describe any record evidence, monument evidence, testimonial evidence or any other material evidence you considered and whether the monument was found or restored through acceptance of an obliterated evidence location.


Found existing 2" iron pipe at the WL/4 corner of Section 14. This Corner was used on former surveys as performed by Gregory J. Hofmeister.

Describe or show any material discrepancy between the location of the restored corner and that of the corner previously restored or reestablished.

N/A

RECORD OF DURABLE WITNESS MONUMENTS

NO	DESCRIPTION	BEARING	DISTANCE
1	12" BIRCH	NORTH	19.56'
2	4" CHERRY	N65°W	22.88'
3	4" WALNUT	N35°W	30.05'
4	4" BL. OAK	N30°W	6.05'

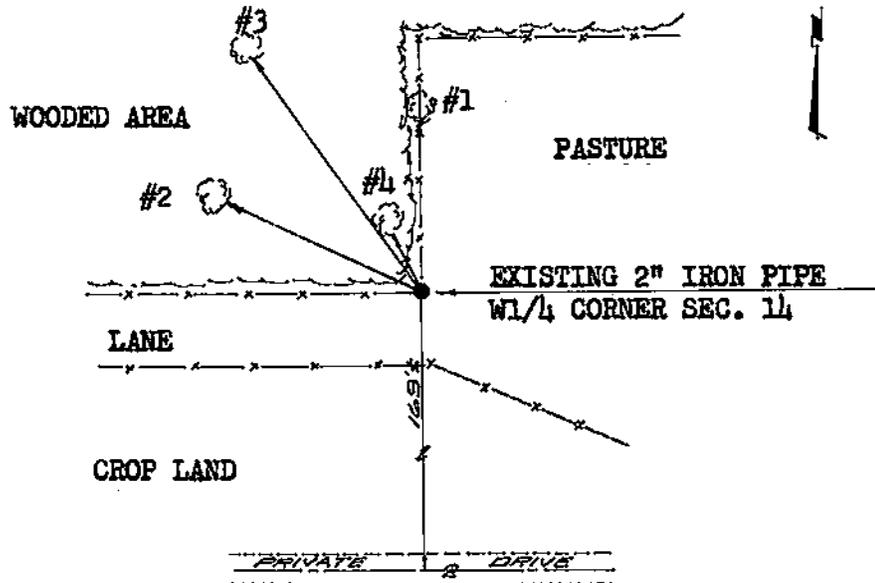

Note: Bearings Magnetic

PLAN VIEW DRAWING OF REFERENCE TIES

MAP SHOWING DISTANCE AND DIRECTION TO OTHER PUBLIC LAND SURVEY CORNERS USED FOR REESTABLISHING THE CORNER

N/A

I, Robert M. Lampman, Registered Land Surveyor, do
 HEREBY CERTIFY THAT THE CORNER LOCATION SHOWN ON THIS RECORD
 WAS DETERMINED BY ME OR UNDER MY DIRECTION AND CONTROL AND
 THAT THIS U. S. PUBLIC LAND SURVEY MONUMENT RECORD IS CORRECT
 AND COMPLETE TO THE BEST OF MY KNOWLEDGE AND BELIEF.

Robert M. Lampman
 Signature

June 28, 1984
 Date



Seal