


21507160000

U. S. PUBLIC LAND SURVEY MONUMENT RECORD

SECTION 16 T 15 N, R 7 W, ~~TOWN~~ OF La Crosse ^{City}

LA CROSSE COUNTY

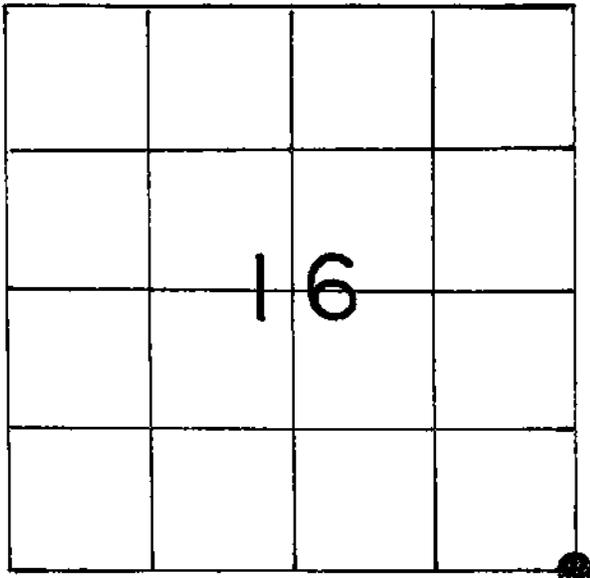

LOCATION OF LANDMARK

Crew: William C. Jung
Peter F. Follansbee

Date: May 17, 1991

Describe any record evidence, monument evidence, testimonial evidence or any other material evidence you considered and whether the monument was found or restored through acceptance of an obliterated evidence location.

I found a sandstone fieldstone at the corner, down 15" with a 1" iron pipe on the West side of the stone. I put a Berntsen top in a 1 1/4" iron pipe and set it over the high point of the stone. The top is up 8". A whiskey bottle with a shell casing is buried on the SE side of the stone. The stone had been used as the corner in numerous other surveys.

Describe or show any material discrepancy between the location of the restored corner and that of the corner previously restored or reestablished.

None known.

WISCONSIN COORDINATE SYSTEM

North

East

Theta Angle

Horiz. Order

Vert. Order


TYPE OF LANDMARK

Berntsen top in iron pipe over stone

BEARINGS ARE REFERENCED TO

RECORD OF DURABLE WITNESS MONUMENTS

NO	DESCRIPTION	BEARING	DISTANCE
1	To center of steel fence corner post	-----	19.79
2	To P.K. nail on South side of new 18" power pole; nailed a sign on the North side of pole	-----	1.64
3	To center of steel connector post	-----	1.74
4	"	-----	1.75

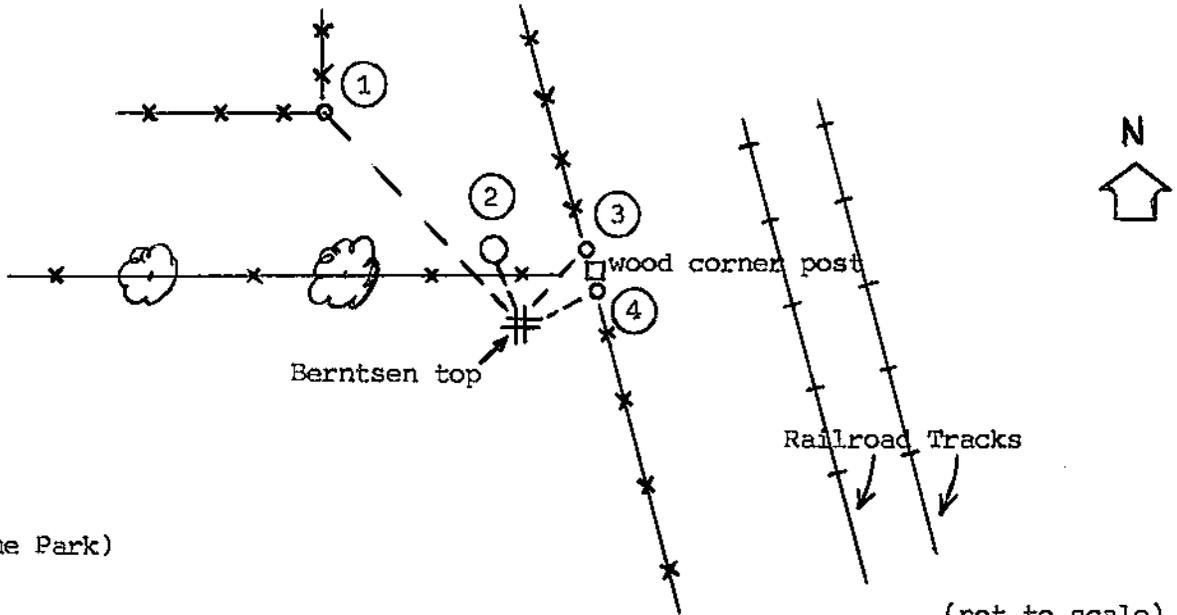

(Mobile Home Park)

PLAN VIEW DRAWING OF REFERENCE TIES

MAP SHOWING DISTANCE AND DIRECTION TO OTHER PUBLIC LAND SURVEY CORNERS USED FOR REESTABLISHING THE CORNER

No section measurements made by me at this time. See section measurements of record.

I, William C Jung, Deputy County Surveyor,
 HEREBY CERTIFY THAT THE CORNER LOCATION SHOWN ON THIS RECORD
 WAS DETERMINED BY ME OR UNDER MY DIRECTION AND CONTROL AND
 THAT THIS U. S. PUBLIC LAND SURVEY MONUMENT RECORD IS CORRECT
 AND COMPLETE TO THE BEST OF MY KNOWLEDGE AND BELIEF.

William C. Jung
 Signature

November 27, 1991
 Date



Seal

9 | 10 R.R. SPIKE SET FROM S.E. BLOCK CORNER.
 16 | 15 ← SEC. CORNER AT WARD AVE. & 32ND ST.

N 652,339.100 } U.S.C.E.
 E 1,680,731.195 }


5,342.544' ✓ } U.S.C.E.
 N 2°-13'-48.6" E }

5,342.61' } CITY OF LA CROSSE
 N 0°-26'-22" E }

STONE MONUMENT -
 SECTION CORNER SOUTH OF
 BROADVIEW PLACE ON WEST R.R. R.O.W. LINE.

16 | 15
 21 | 22 N 647,000.603 } U.S.C.E.
 E 1,680,523.295 }

- 647,000.603	· 1,680,731.195
+ 652,339.100	- 1,680,523.295
5,338.497 ✓	207.900 ✓

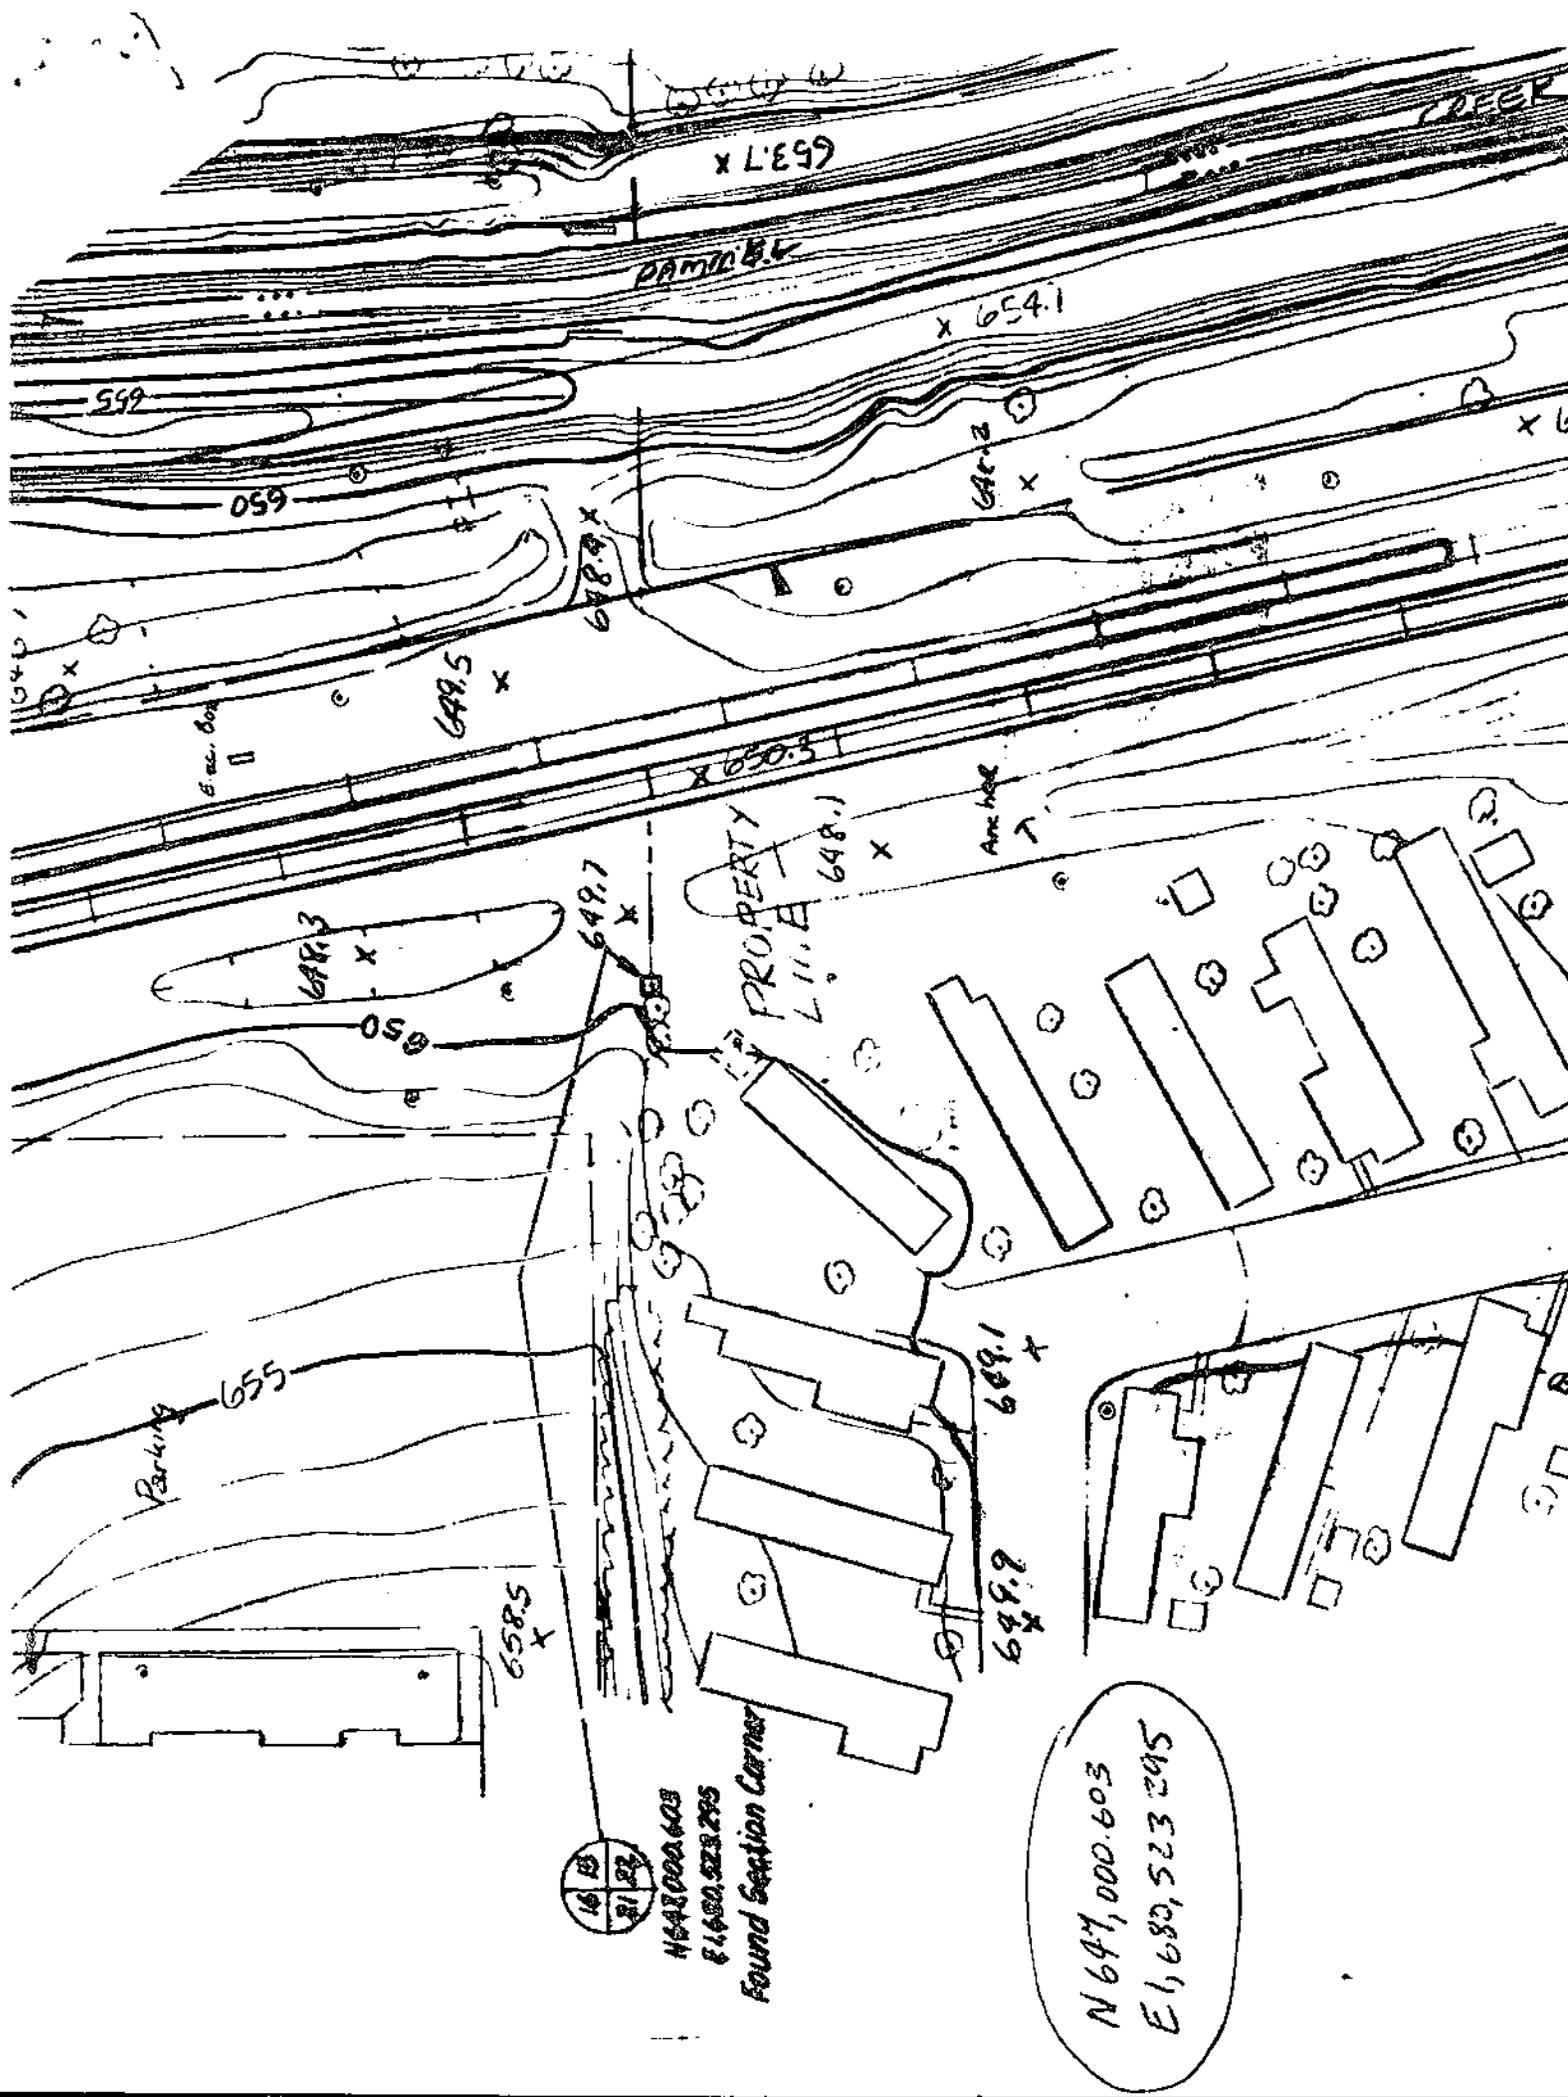

x 653.7

PAMPA BL

DEER

x 654.1

559

650

649.2

648.4

649.5

x 650.5

PROPERTY LINE

648.1

649.3

649.7

650

Parking 655

658.5

649.1


649.9

16 13
21 22

N 647,000.603
E 1,680,523.295

Found Section Corner

N 647,000.603
E 1,680,523.295

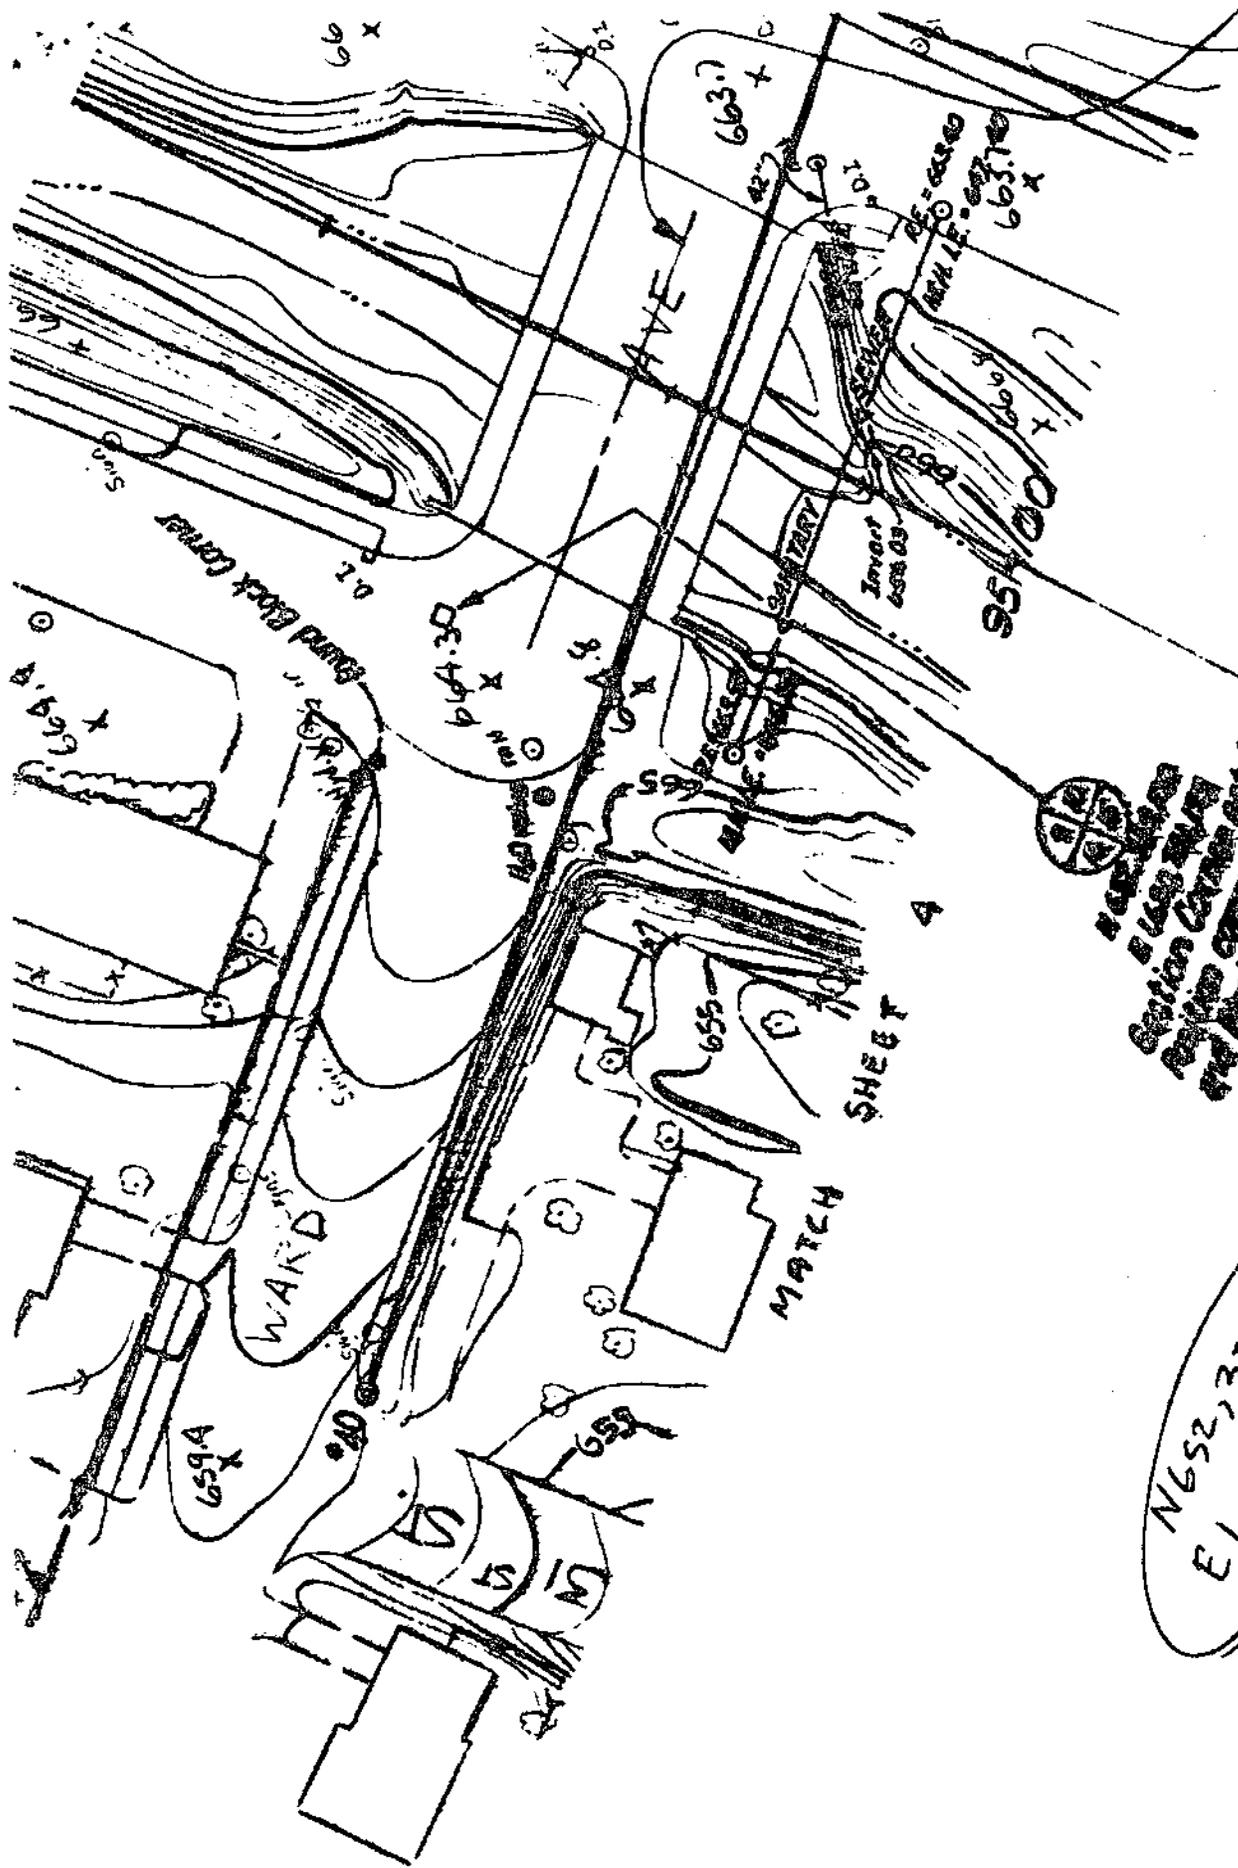

MATCH SHEET 4
 SECTION CENTER AND SURVEY
 POINT CENTER FROM 100
 FEET NORTH OF REPRESENTATION

N 652,339.100
 E 1,680,731.195

652,250N

652,250N