


21507212000

U. S. PUBLIC LAND SURVEY MONUMENT RECORD

SECTION 22 T 15 N, R 7 W, ^{City}TOWN OF LaCrosse

LA CROSSE COUNTY

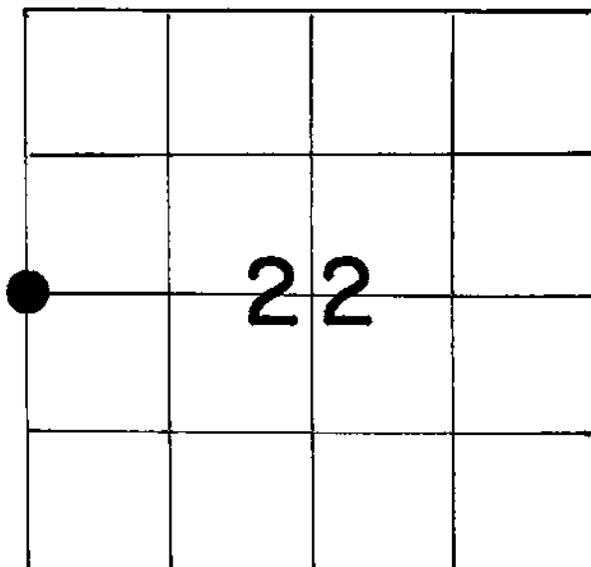

LOCATION OF LANDMARK

Crew: William Jung
Perry Dahl

7/30/85

WISCONSIN COORDINATE SYSTEM

North 644,358.469 (as per D.O.T.)

East 1,680,410.816

Theta Angle

Horiz. Order

Vert. Order

TYPE OF LANDMARK

BERNTSEN TOP SET IN 1½" X 23" IRON PIPE

BEARINGS ARE REFERENCED TO

Assumed

Describe any record evidence, monument evidence, testimonial evidence or any other material evidence you considered and whether the monument was found or restored through acceptance of an obliterated evidence location.


A 1956 survey by Kraft shows a government monument at the corner. The 1969 Plat of Sherwood Manor Addition shows a pipe at the corner. Clark and Hofmeister call for a 1¼" iron bar at the corner. The D.O.T. hwy. plat also shows this corner. I found a 1¼" iron bar at the corner. I removed the bar and dug a large hole, but did not find a pipe or a government marker. I replaced the bar with a 1½"x23" iron pipe with a Berntsen top in it, up ½" or so. Ray Pelishek and I both agreed to accept the position of the iron bar after reviewing the records and completing a field traverse. This corner was accepted by "common report". Describe or show any material discrepancy between the location of the restored corner and that of the corner previously restored or reestablished.

(see notes above)

I am not sure that this is at the government marker position as called for in 1956 by Kraft. It is not completely possible to compute the position of this marker.

Tie Sheet, City of La Crosse

Section 22 Township 15 N Range 7 W

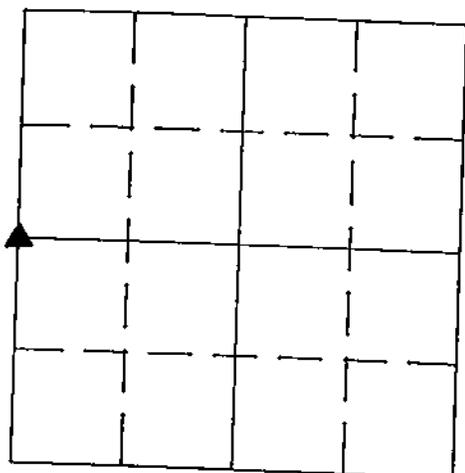


Project Section Corner
 Sta No _____
 Monument _____
 Coord. System _____
 North _____
 East _____
 Elev _____
 Surveyor County

Comments:

Date _____

Space for copy of field notes or ties to above described monument:

Berntsen top in pipe, up 1/2" or so
 (Do not dig here anymore!!! There
 are (7) utility lines, down 2 ft.,
 including a 8000V line. Dahl cut
 a line while we were digging!)

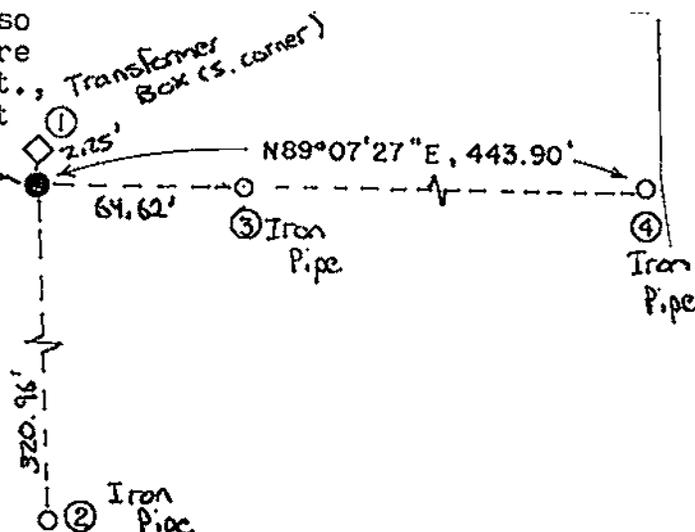

PLAN VIEW DRAWING OF REFERENCE TIES

MAP SHOWING DISTANCE AND DIRECTION TO OTHER PUBLIC LAND
 SURVEY CORNERS USED FOR REESTABLISHING THE CORNER