


21507222000

U. S. PUBLIC LAND SURVEY MONUMENT RECORD

SECTION 22 T 15 N, R 7 W, ^{City}~~TOWN~~ OF LaCrosse

LA CROSSE COUNTY

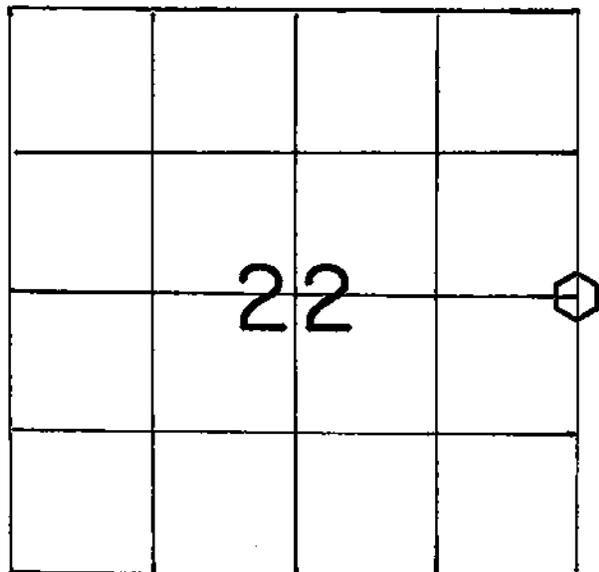

LOCATION OF LANDMARK

WISCONSIN COORDINATE SYSTEM
North
East
Theta Angle
Horiz. Order
Vert. Order
TYPE OF LANDMARK
Set brass cap Lunde marker.
BEARINGS ARE REFERENCED TO
True North.

Crew: WILLIAM C. JUNG
PETER F. FOLLANSBEE

Crew: William C. Jung
Peter F. Follansbee

Date: 4/08/1994

Date: 10/24/95

Describe any record evidence, monument evidence, testimonial evidence or any other material evidence you considered and whether the monument was found or restored through acceptance of an obliterated evidence location.

I found an iron pipe at the corner which had been set by Greg Hofmeister. I accepted the pipe as the best available evidence of the original government corner position and replaced the pipe with a Lunde.


10/24/95 - The area around the corner had been disturbed during construction. The Lunde was OK but (3) of the ties were disturbed. The corner is 14.35 feet West of the new back of curb. A new sign and post was set to the NE.

Describe or show any material discrepancy between the location of the restored corner and that of the corner previously restored or reestablished.

None Known.

RECORD OF DURABLE WITNESS MONUMENTS

NO	DESCRIPTION	BEARING	DISTANCE
1	Exist. 1" Iron Pipe (Hofmeister C.S.M.)	N 88°33'58" W	467.93 Ft.
2	Exist. 1" Iron Pipe by E.-side of fence.	S 01°45'48" W	2.63 2.66 Ft.
3	Center of top nut of existing hydrant.	Southeasterly \pm	18.96 18.90 Ft.
4	Center of existing water-shutoff cap.	Southeasterly \pm	20.06 20.11 Ft.

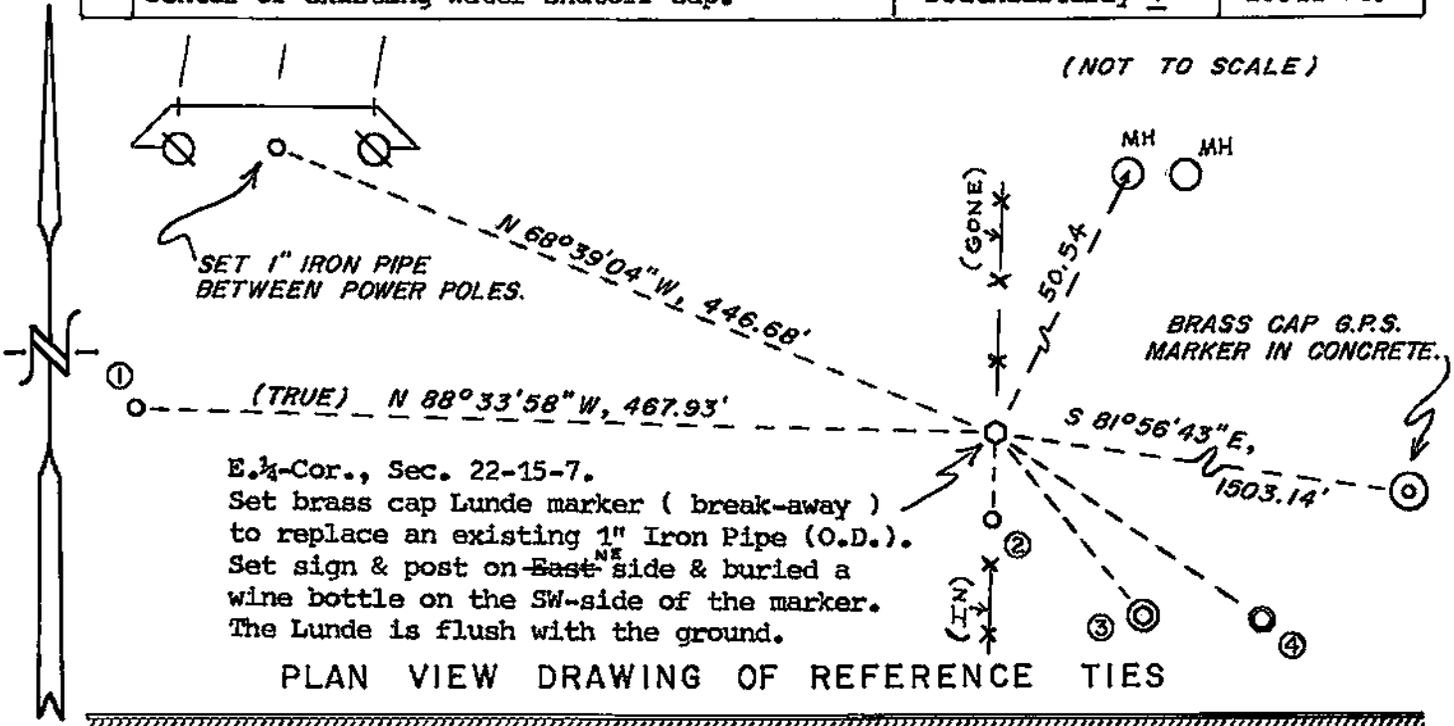

MAP SHOWING DISTANCE AND DIRECTION TO OTHER PUBLIC LAND SURVEY CORNERS USED FOR REESTABLISHING THE CORNER


I made ^{no} section measurements at this time. This position was confirmed previously by other surveyors.

I, William C. Jung, County Surveyor
HEREBY CERTIFY THAT THE CORNER LOCATION SHOWN ON THIS RECORD WAS DETERMINED BY ME OR UNDER MY DIRECTION AND CONTROL AND THAT THIS U. S. PUBLIC LAND SURVEY MONUMENT RECORD IS CORRECT AND COMPLETE TO THE BEST OF MY KNOWLEDGE AND BELIEF.

William C. Jung
Signature

May 11, 1994
Date


Revised: 1/8/96

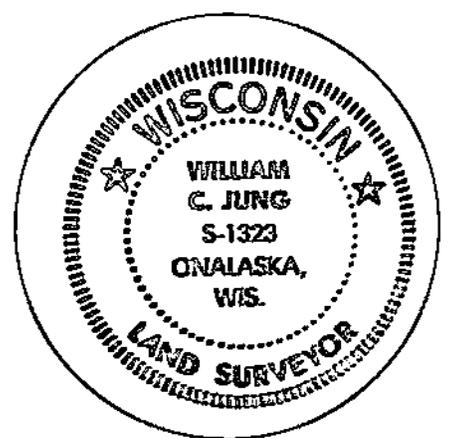

Seal

Tie Sheet, City of La Crosse

Section 22 Township 15 N Range 7 W

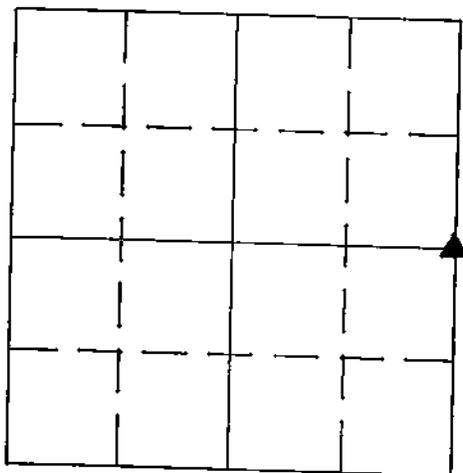


Project Section Corner
 Sta No _____
 Monument _____
 Coord. System _____
 North _____
 East _____
 Elev _____
 Surveyor County

Comments:

Date _____

Space for copy of field notes or ties to above described monument:

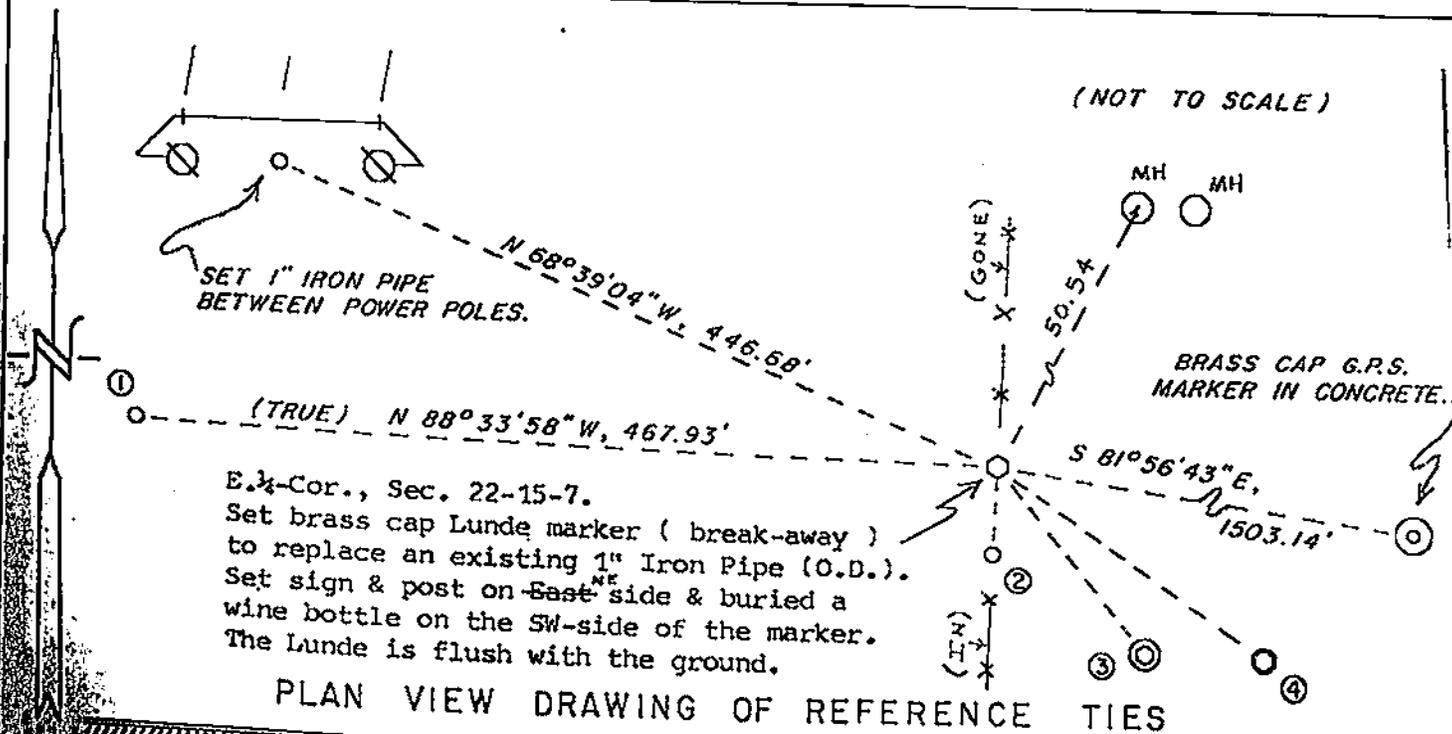

MAP SHOWING DISTANCE AND DIRECTION TO OTHER PUBLIC LAND SURVEY CORNERS USED FOR REESTABLISHING THE CORNER