


U. S. PUBLIC LAND SURVEY MONUMENT RECORD

SECTION 23 T 15 N, R 7 W, TOWN OF Shelby

LA CROSSE COUNTY

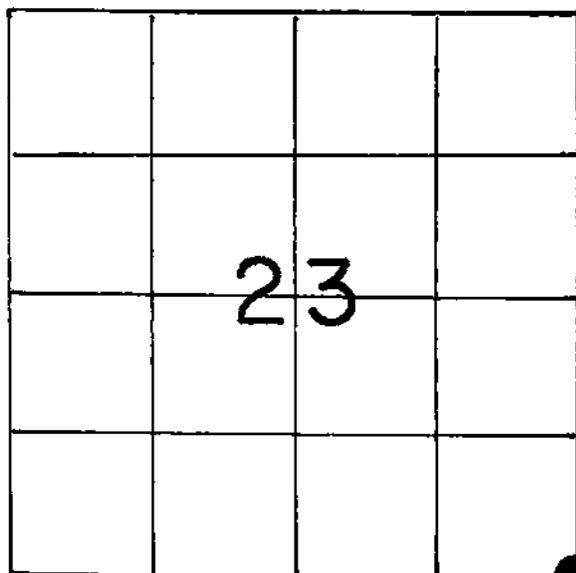

LOCATION OF LANDMARK

WISCONSIN COORDINATE SYSTEM	
North	641,560.571
East	1,659,348.613
Theta Angle	
Horiz. Order	83('91)
Vert. Order	
TYPE OF LANDMARK	
Existing 1" iron pipe with cap	
BEARINGS ARE REFERENCED TO	

Crew: William C. Jung
Peter Follansbee

Crew: William C. Jung
Peter Follansbee

Date: 8/29/89

Date: 9/19/03

Describe any record evidence, monument evidence, testimonial evidence or any other material evidence you considered and whether the monument was found or restored through acceptance of an obliterated evidence location.


I found an iron pipe at the occupied corner which I accepted as the best available evidence of the original government corner position. The iron pipe had a Hofmeister cap in it.

Describe or show any material discrepancy between the location of the restored corner and that of the corner previously restored or reestablished.

In previous surveys Connell and Pederson had used the steel fence post 9" to the Southwest as the corner.

RECORD OF DURABLE WITNESS MONUMENTS


NO	DESCRIPTION	BEARING	DISTANCE
1	Existing iron pipe with Hofmeister cap	-----	44.08'
2	3 1/2" steel fence post	-----	0.75'
3	To the center of a power pole	-----	slope = 92.5'
4			

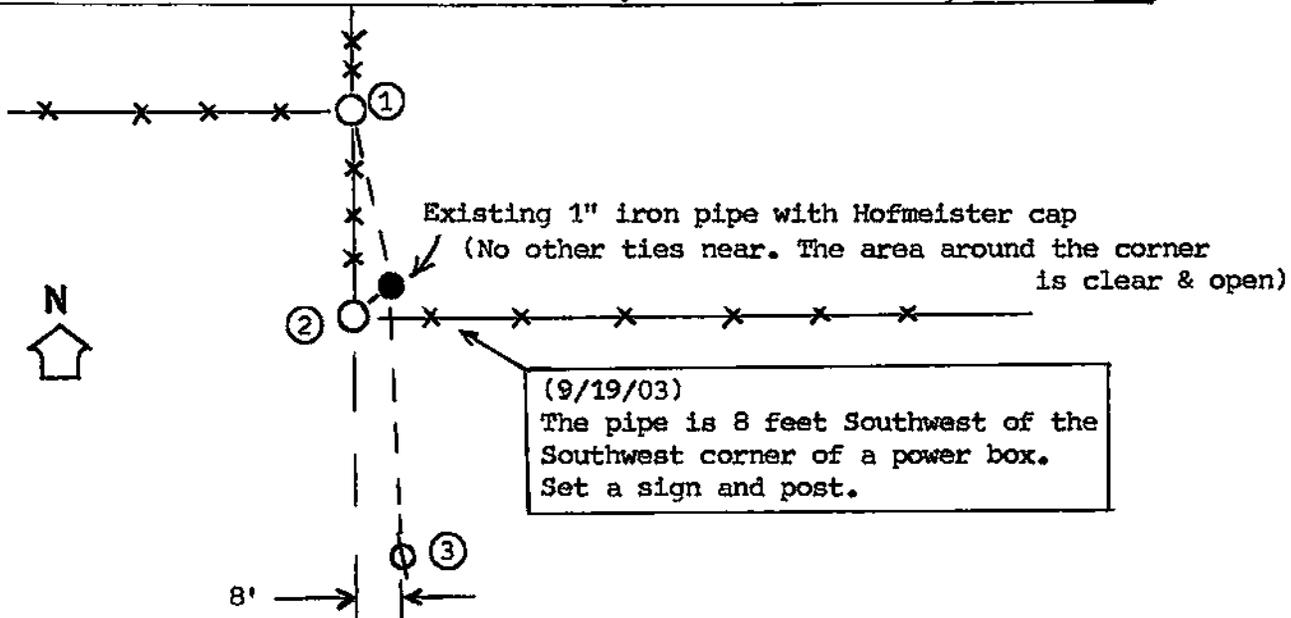

PLAN VIEW DRAWING OF REFERENCE TIES

MAP SHOWING DISTANCE AND DIRECTION TO OTHER PUBLIC LAND SURVEY CORNERS USED FOR REESTABLISHING THE CORNER

(not to scale)

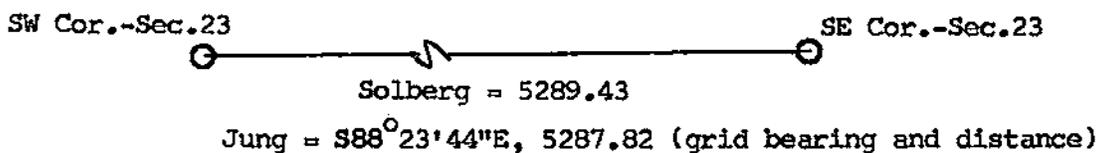


I, William C. Jung, Deputy County Surveyor,
HEREBY CERTIFY THAT THE CORNER LOCATION SHOWN ON THIS RECORD WAS DETERMINED BY ME OR UNDER MY DIRECTION AND CONTROL AND THAT THIS U. S. PUBLIC LAND SURVEY MONUMENT RECORD IS CORRECT AND COMPLETE TO THE BEST OF MY KNOWLEDGE AND BELIEF.

William C. Jung
Signature

11/30/89

Date

Revised: 12/01/03 *wlj*

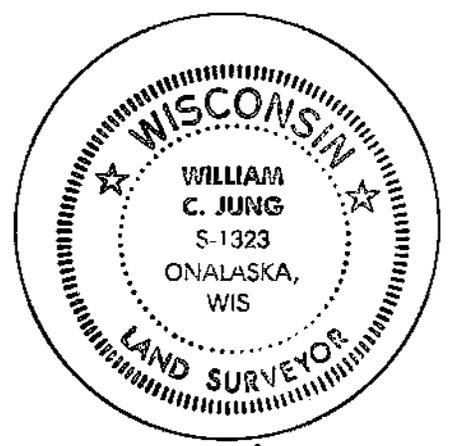

Seal