


21507230020

U. S. PUBLIC LAND SURVEY MONUMENT RECORD

SECTION 23 T 15 N, R 7 W, TOWN OF Shelby

LA CROSSE COUNTY

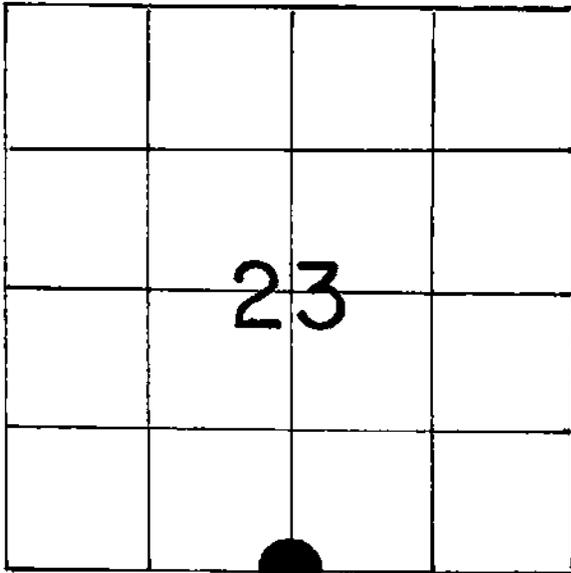

LOCATION OF LANDMARK

Crew: William C. Jung
Peter Follansbee

Date: 8/29/89

Describe any record evidence, monument evidence, testimonial evidence or any other material evidence you considered and whether the monument was found or restored through acceptance of an obliterated evidence location.

Using survey points, bearings, and coordinates as provided by Rodney Maxwell, RLS, I set the corner by single proportionate measurement. I set a brass capped Lunde marker at the corner.

Describe or show any material discrepancy between the location of the restored corner and that of the corner previously restored or reestablished.

None known.

WISCONSIN COORDINATE SYSTEM

North

East

Theta Angle

Horiz. Order

Vert. Order

TYPE OF LANDMARK


Brass capped Lunde marker

BEARINGS ARE REFERENCED TO

RECORD OF DURABLE WITNESS MONUMENTS
Magnetic

NO	DESCRIPTION	BEARING	DISTANCE
1	P.K. in double blazed 3" hickory	S88°E	22.03
2	" " " " 4" "	S86°E	29.53
3	" " " " 12" oak	S58°E	35.57
4	" " " " 16" white oak	S29°W	37.62

S1/4-COR., SEC. 23-15-7.
SET BRASS CAP LUNDE MARKER.
BURIED A LIQUOR BOTTLE CONTAINING A
BLANK BULLET ALONG WITH AN OLD
SHOVEL HEAD ON THE EAST SIDE OF
LUNDE. DROVE IN STEEL FENCE POST
AND SET LARGE ROCK TO N.W. OF LUNDE.

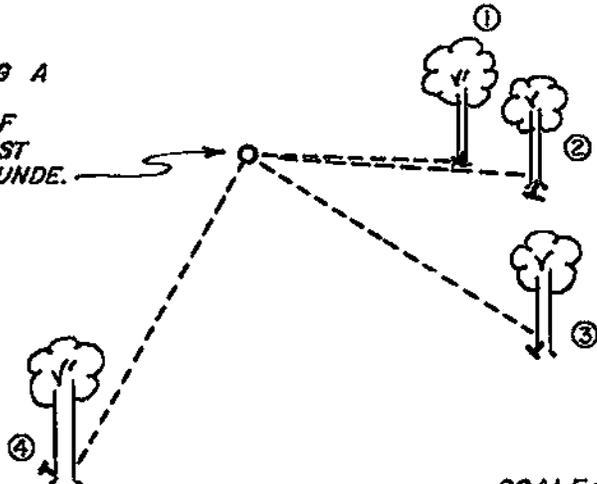


(NOTE: ALL TREES ARE
DOUBLE BLAZED)

SCALE: 1" = 20'

PLAN VIEW DRAWING OF REFERENCE TIES

MAP SHOWING DISTANCE AND DIRECTION TO OTHER PUBLIC LAND
SURVEY CORNERS USED FOR REESTABLISHING THE CORNER


(not to scale)

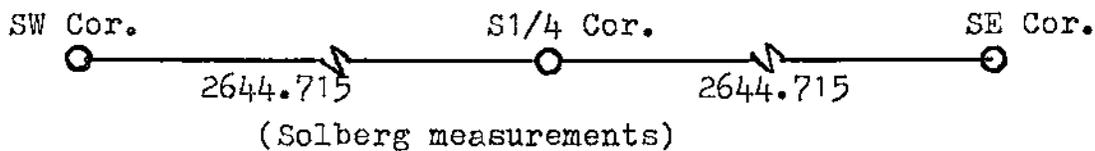

I, William C. Jung, Deputy County Surveyor,
HEREBY CERTIFY THAT THE CORNER LOCATION SHOWN ON THIS RECORD
WAS DETERMINED BY ME OR UNDER MY DIRECTION AND CONTROL AND
THAT THIS U. S. PUBLIC LAND SURVEY MONUMENT RECORD IS CORRECT
AND COMPLETE TO THE BEST OF MY KNOWLEDGE AND BELIEF.

William C. Jung
Signature

December 5, 1989
Date

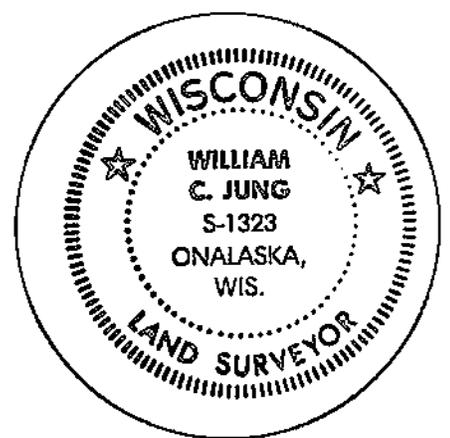

Seal

