

RECEIVED
 JUL 20 2005
 COUNTY SURVEYOR'S OFFICE

21507242000

**LA CROSSE COUNTY
 CERTIFIED U.S. PUBLIC LAND SURVEY MONUMENT RECORD**

INSTRUCTIONS: THIS RECORD SHALL SHOW THE LOCATION OF THE CORNER AND SHALL INCLUDE ALL OF THE FOLLOWING ELEMENTS (A-I)

(A) IDENTIFY THE CORNER BY REFERENCE TO THE U.S. PUBLIC LAND SURVEY SYSTEM

■ = CORNER MONUMENT RESTORED

WITNESSES TO CORNER LOCATION:

- 1) Robert M. Lampman
- 2) Jessica A. Zamor

WIS. STATE PLANE GRID COORDINATES - NAD83(1991) - SURVEY FEET

NORTHING: 644110.398

EASTING: 1684743.890

GEOGRAPHIC COORDINATES - WGS84/GRS80 - NAD83(1991)


Lat: 43°45'41.35757" N

Lon: 91°08'59.39868" W

LA CROSSE COUNTY GRID COORDINATES - NAD83(1991) - SURVEY FEET

NORTHING: 113185.290

EASTING: 472078.041

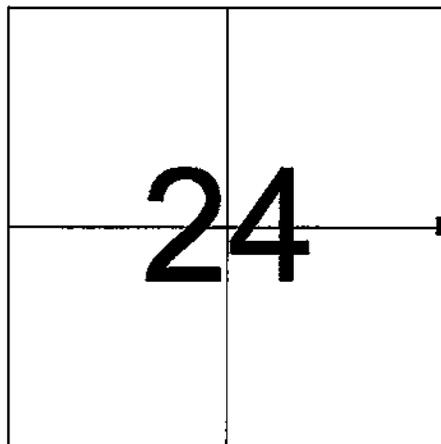

**SECTION 24
 TOWN 15 NORTH, RANGE 7 WEST**

(B) DESCRIBE ANY RECORD EVIDENCE, MONUMENT EVIDENCE, OCCUPATIONAL EVIDENCE, TESTIMONIAL EVIDENCE OR ANY OTHER MATERIAL EVIDENCE YOU CONSIDERED, AND WHETHER THE MONUMENT WAS FOUND OR PLACED.

Using distances of record as measured from adjacent corners, found an existing 1-1/4" o.d. iron pipe at the corner. The monument is in good condition and there is a plastic plug stamped "Hofmeister" set inside the pipe. Numerous surveys have been tied to this monument.

The found pipe is in line with occupation running north and south. Our measurements indicate that the location of the pipe also matches within three tenths of a foot a position determined by single proportionate measurement between the section corners to the north and south.

Accepted the existing monument, supported by surveys of record and occupation, as the best available evidence of the section corner location.



(C) IN THE PLAN VIEW DRAWING BELOW, PROVIDE REFERENCE TIES TO AT LEAST 4 WITNESS MONUMENTS OR, IF THE LOCATION IS WITHIN A MUNICIPALITY, TO AT LEAST 2 WITNESS MONUMENTS. (WITNESS MONUMENTS SHALL BE MADE OF CONCRETE, NATURAL STONE, IRON, OR OTHER EQUALLY DURABLE MATERIAL.) DESCRIBE WITNESS MONUMENTS.

(D) SHOW A PLAN VIEW DRAWING, DEPICTING THE RELEVANT MONUMENTS AND REFERENCE TIES, WHICH IS SUFFICIENTLY DETAILED TO ENABLE ACCURATE RELOCATION OF THE CORNER MONUMENT IF IT IS DISTURBED.

LEGEND

- FOUND 1-1/4" O.D. IRON PIPE WITH PASTIC PLUG STAMPED HOFMEISTER AT CORNER
- SET 3/4" x 24" ROUND IRON BAR AS WITNESS MONUMENT

NOT TO SCALE

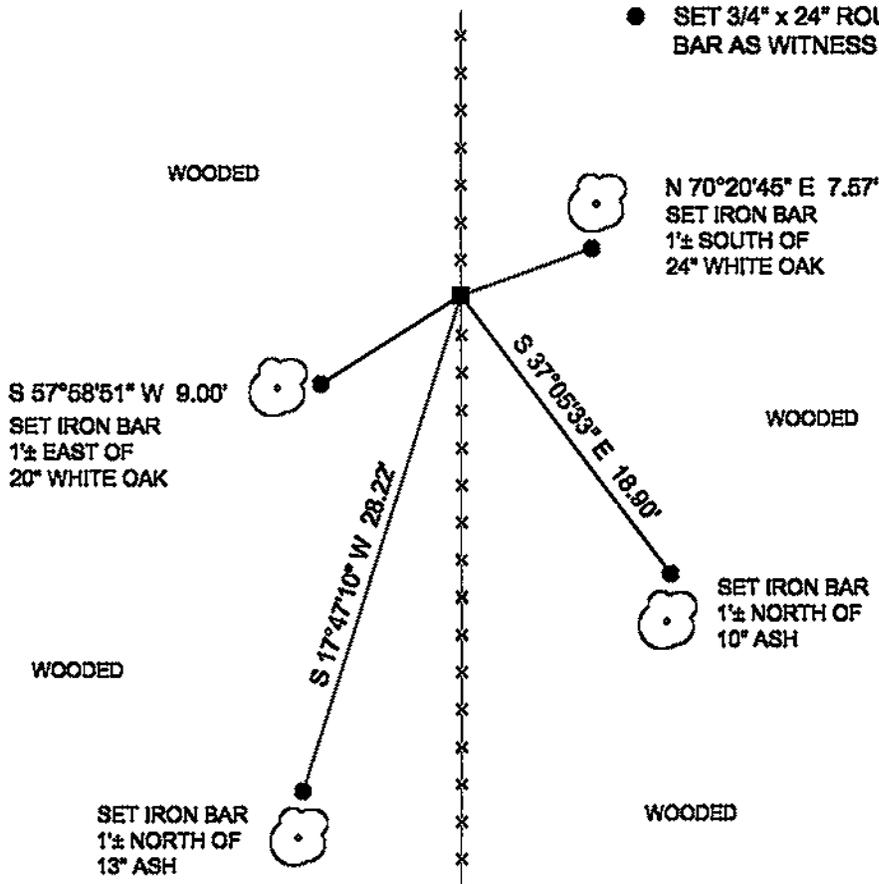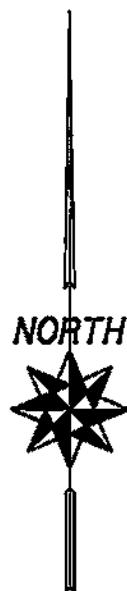

(E) DESCRIBE ANY MATERIAL DISCREPANCY BETWEEN THE LOCATION OF THE CORNER AS RESTORED OR REESTABLISHED AND THE LOCATION OF THAT CORNER AS PREVIOUSLY RESTORED OR REESTABLISHED BY DISTANCE AND DIRECTION. SHOW THE DISCREPANCY ON THE PLAN VIEW DRAWING UNDER (D), ABOVE. SHOW THE DISTANCES BETWEEN THE CORNER AS PREVIOUSLY RESTORED OR REESTABLISHED AND (1) THE CORNER AS RESTORED OR REESTABLISHED, AND (2) TO AT LEAST 2 OF THE WITNESS MONUMENTS AS SHOWN ON THE DRAWING IN (D), ABOVE.

N/A

(F) WAS THE CORNER RESTORED THROUGH ACCEPTANCE OF (1) AN OBLITERATED EVIDENCE LOCATION, OR (2) A FOUND PERPETUATED LOCATION?

(1) A FOUND PERPETUATED LOCATION


(G & H) WAS THE CORNER REESTABLISHED THROUGH LOST CORNER PROPORTIONATE METHODS? IF SO SHOW THE METHOD, INCLUDING THE DIRECTIONS AND DISTANCES TO OTHER PUBLIC LAND SURVEY CORNERS USED AS EVIDENCE OR USED FOR PROPORTIONING IN DETERMINING THE CORNER LOCATION.

N/A


(**) ANY ADDITIONAL INFORMATION RELATED TO CORNER LOCATION

SECTION LINE MEASUREMENTS:

NOT TO SCALE

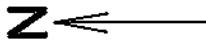

Bearings and distances are La Crosse County Grid.

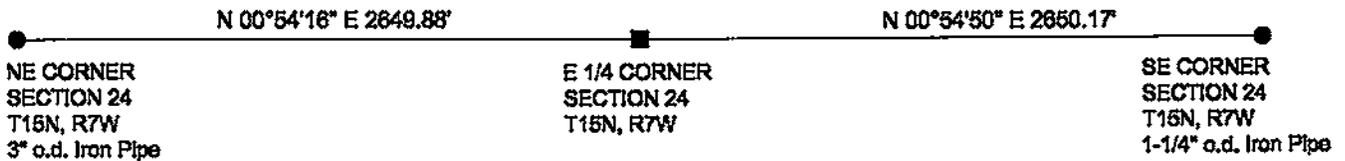

CORNER HISTORY:

-Original government corner location established by Uriah Biggs in 1845.

AFFIX LAND SURVEYOR SEAL

(I) I, JESSICA A. ZAMOR, CERTIFY THAT THE LOCATION SHOWN ON THIS RECORD WAS DETERMINED BY ME OR UNDER MY DIRECTION AND CONTROL AND THAT THIS U.S. PUBLIC LAND SURVEY MONUMENT RECORD IS CORRECT AND COMPLETE TO THE BEST OF MY KNOWLEDGE AND BELIEF.

Jessica A. Zamor
SIGNATURE

7-4-2005
DATE

